


dawn 2
release
disclosure
plans



SUMMERSTONE


MORAYFIELD

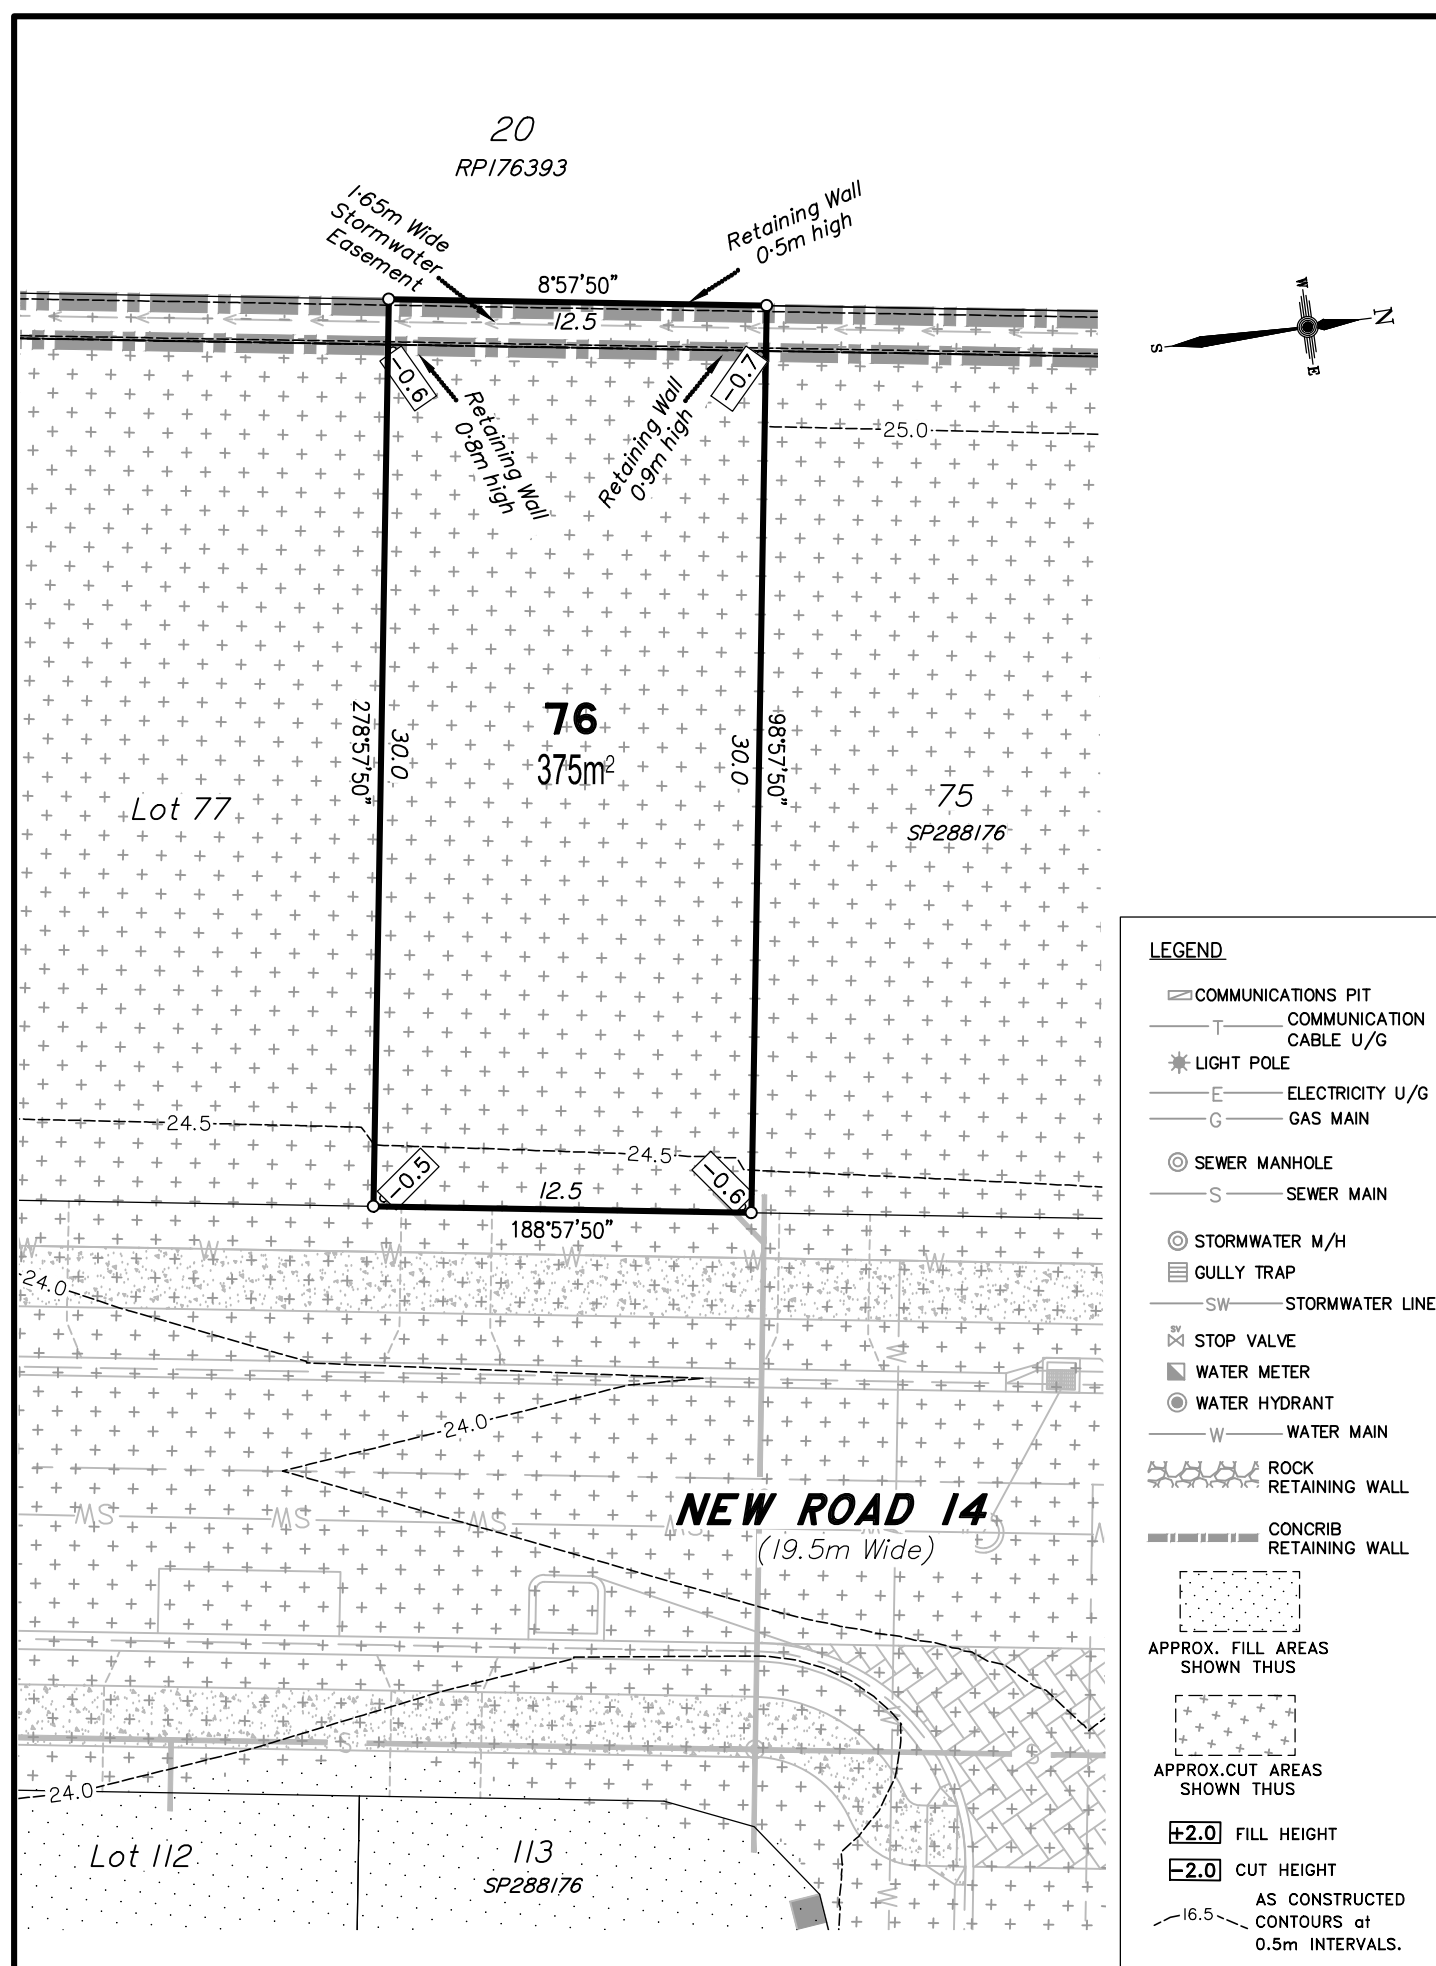

DISCLOSURE PLAN
FOR PROPOSED ALLOTMENT 76
Dated 20th July 2021

This plan shows details of Proposed Allotment 76 on the Proposal Plan 12244-PRO-17 Rev G dated 14/12/2020, which complies with the Development Approval DA/34253/2017/V3RL dated 17th February 2021, approved by Moreton Bay Regional Council, subject to conditions, and associated Judgment by the Planning and Environment Court (1987 of 2018).

The description of the proposed allotment 76, is as part of Lot 1000 on SP324141 (Formally lots 21-24 on RP176393), and situated at Clark Road, Morayfield, commencing at an initial point (A) being the north eastern most point of Lot 20 on RP176393 and thence bounding off on a bearing of 181°20'10" and a distance of 226.001m to point (B) at proposed allotment 76, and containing an area of 375 square metres, more or less.

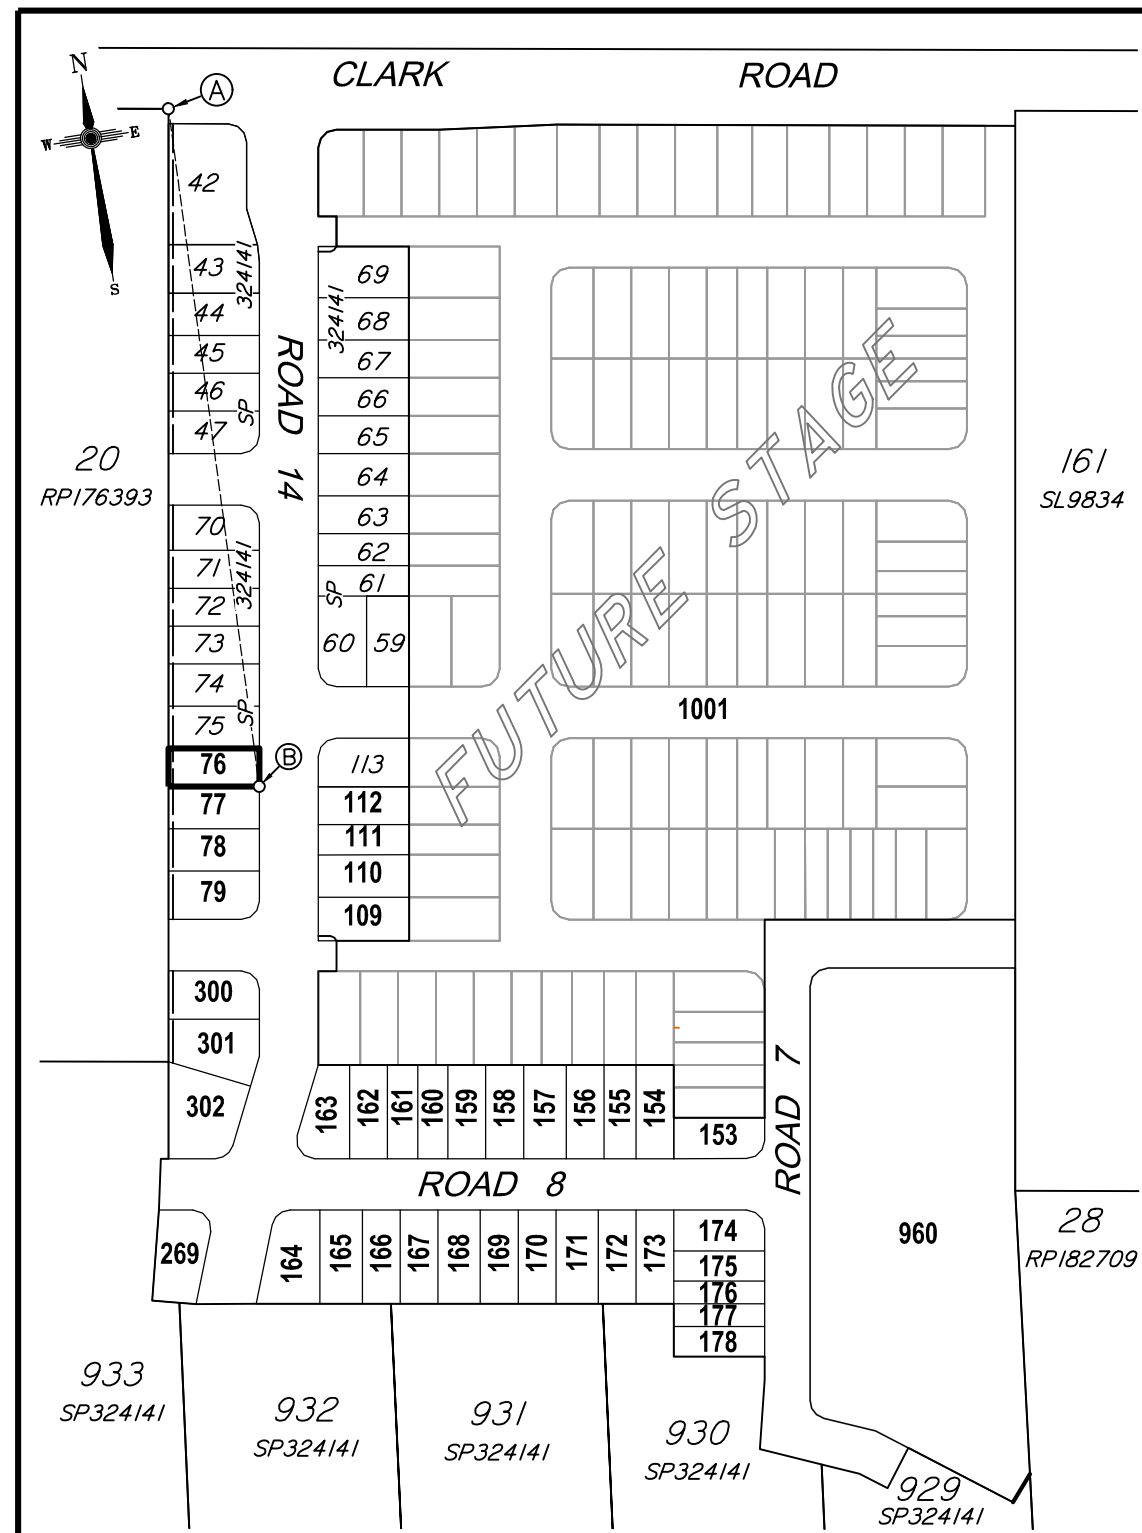

CADASTRAL CONNECTION

A - B 181°20'10" 226.001



Disclosure Plan

**Summerstone Estate,
Morayfield**

PROPOSED STAGE 2
ALLOTMENTS 76-79, 109-112, 153-178
& 300-302

Cancelling Lot 1000 on SP324141
 (Formally Lots 21-24 on RP176393)

PROPOSED LOT 76

DETAIL SURVEY COMPLETED BY LSD 26/06/2021.
 ENGINEERING DESIGN BY GREEN-HAVEN PROJECTS.
 ANY FILLING ON THIS LOT IS TO BE COMPLETED TO LEVEL ONE SUPERVISION AND TESTING IN ACCORDANCE WITH THE REQUIREMENTS OF AS 3798-2007 "GUIDELINES ON EARTHWORKS FOR COMMERCIAL AND RESIDENTIAL DEVELOPMENTS".

Revisions	Surveyed	Drawn	Checked	Passed	Date
B EMT UPDATES	LSD	MH	MH	LS	1/10/21
A ORIGINAL PLAN	LSD	LA	MH	LS	20/07/21



PO Box 6334, Maroochydore BC QLD 4558
 10/1 Newspaper Place, Maroochydore QLD 4558
 Mobile: 0412 666 516
 Email: mail@landsurveyingdynamics.com
 Web: www.landsurveyingdynamics.com
 Land Surveying Dynamics (LSD) Pty Ltd
 ACN 154 593 870


Signed
 Cadastral Surveyor/Director
 Date 1/10/2021

Horiz. Datum MGA20 Z56
 Origin GNSS CORS

Vert. Datum AHD
 Origin PSM 42642
 RL 25.417 AHD

Locality: Morayfield
 Local Government: Moreton Bay R.C.


Scale
SHEET 1 OF 1 As shown at A3
COMPUTER FILE 12244-DIS
DRAWING NUMBER 12116-DIS-76
REV. B

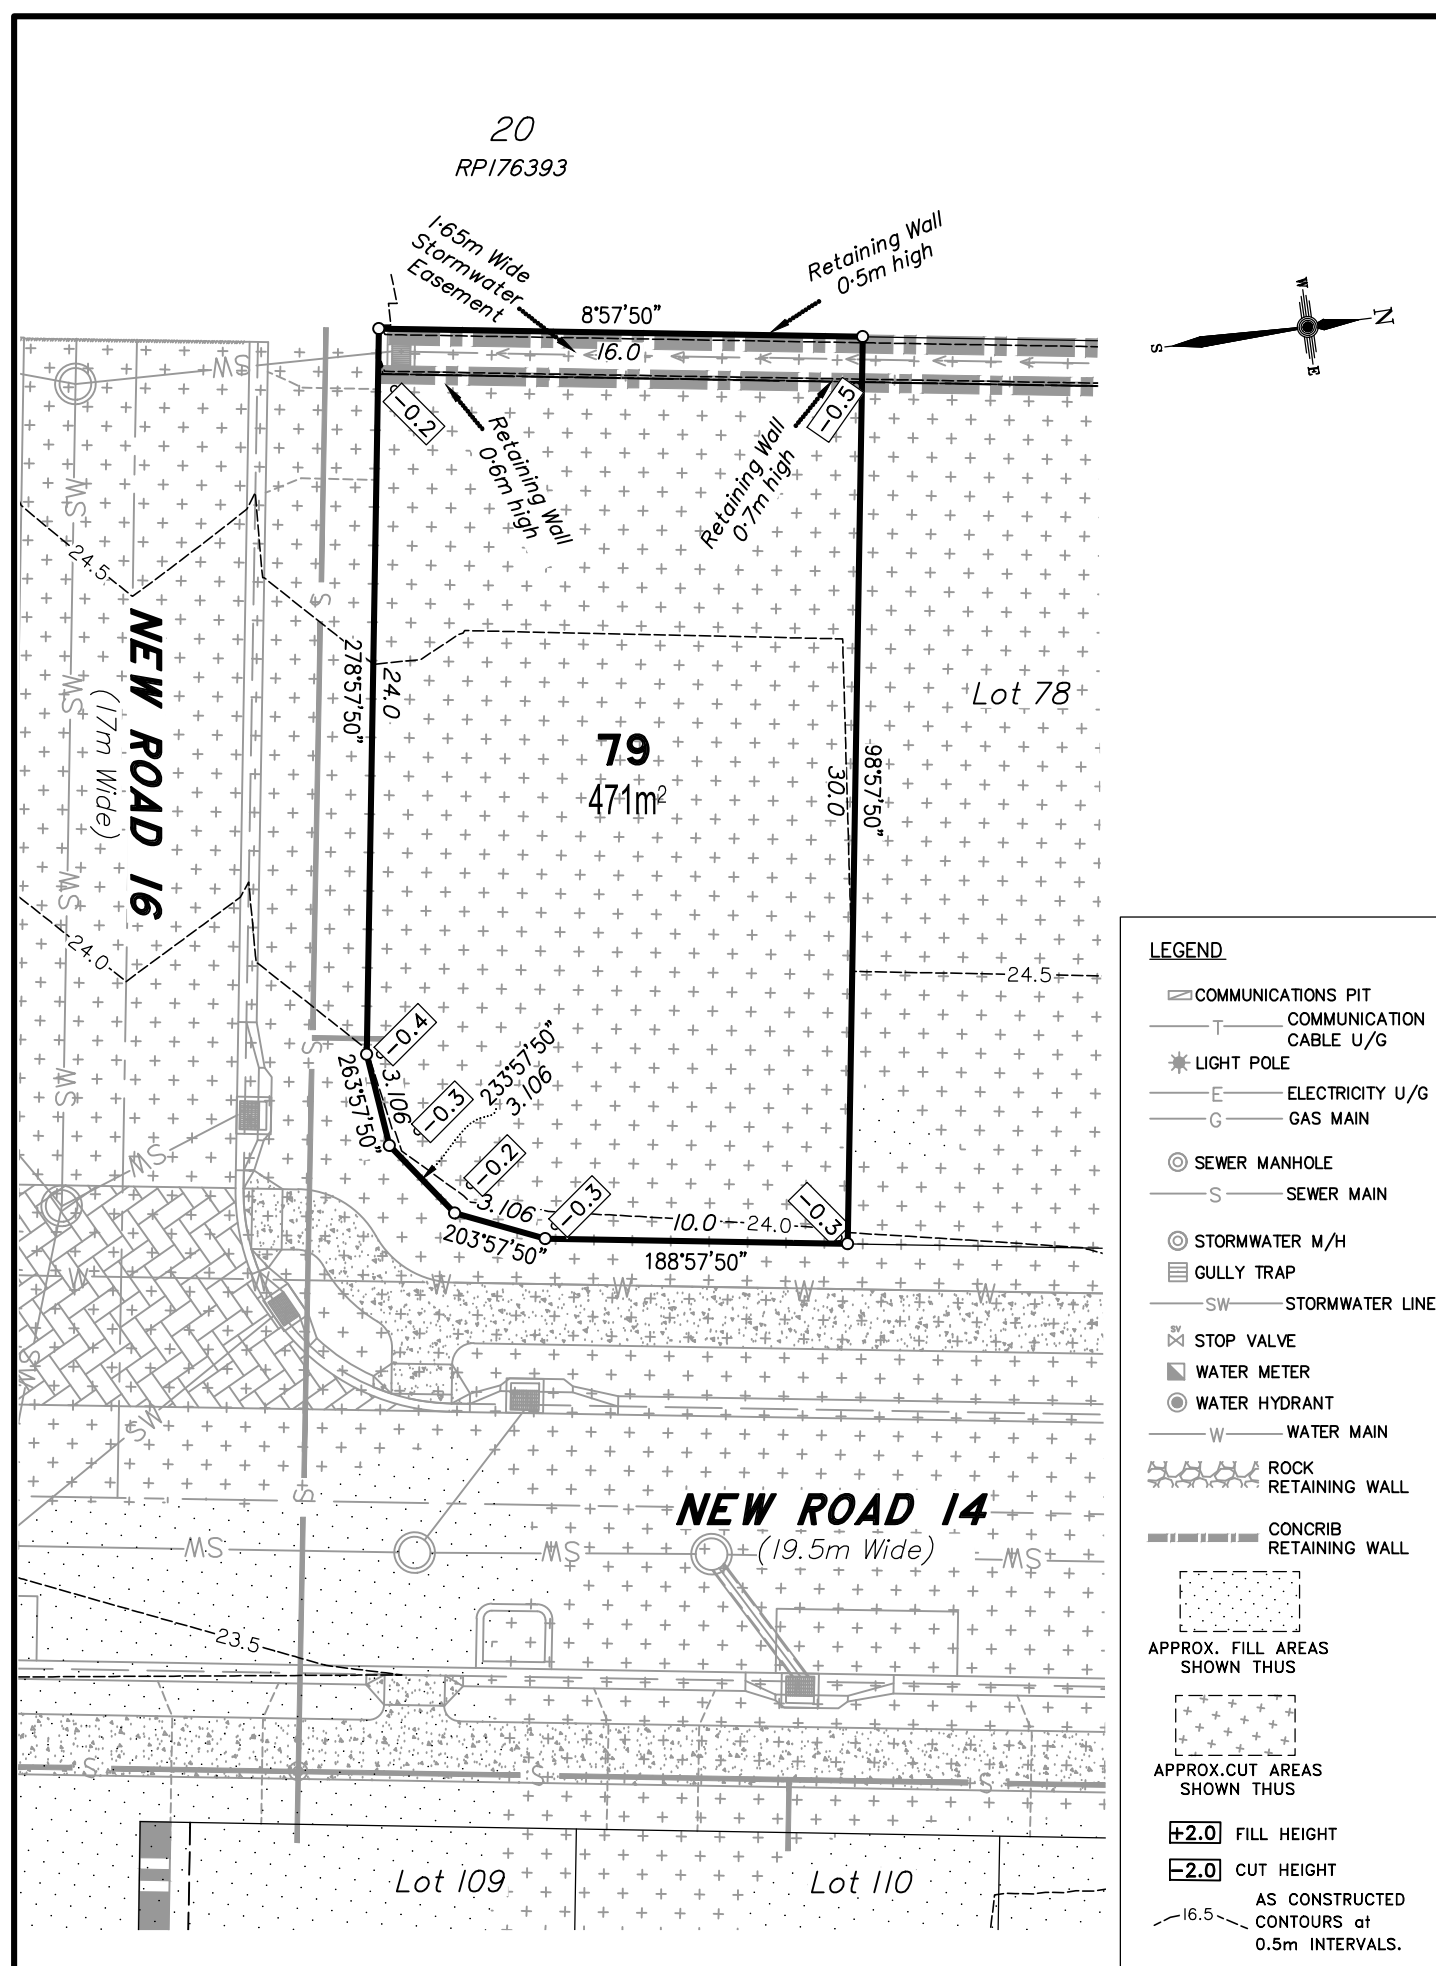

DISCLOSURE PLAN
FOR PROPOSED ALLOTMENT 79
Dated 20th July 2021

This plan shows details of Proposed Allotment 79 on the Proposal Plan 12244-PRO-17 Rev G dated 14/12/2020, which complies with the Development Approval DA/34253/2017/V3RL dated 17th February 2021, approved by Moreton Bay Regional Council, subject to conditions, and associated Judgment by the Planning and Environment Court (1987 of 2018).

The description of the proposed allotment 79, is as part of Lot 1000 on SP324141 (Formally lots 21-24 on RP176393), and situated at Clark Road, Morayfield, commencing at an initial point (A) being the north eastern most point of Lot 20 on RP176393 and thence bounding off on a bearing of 182°10'30" and a distance of 253.78m to point (B) at proposed allotment 79, and containing an area of 471 square metres, more or less.

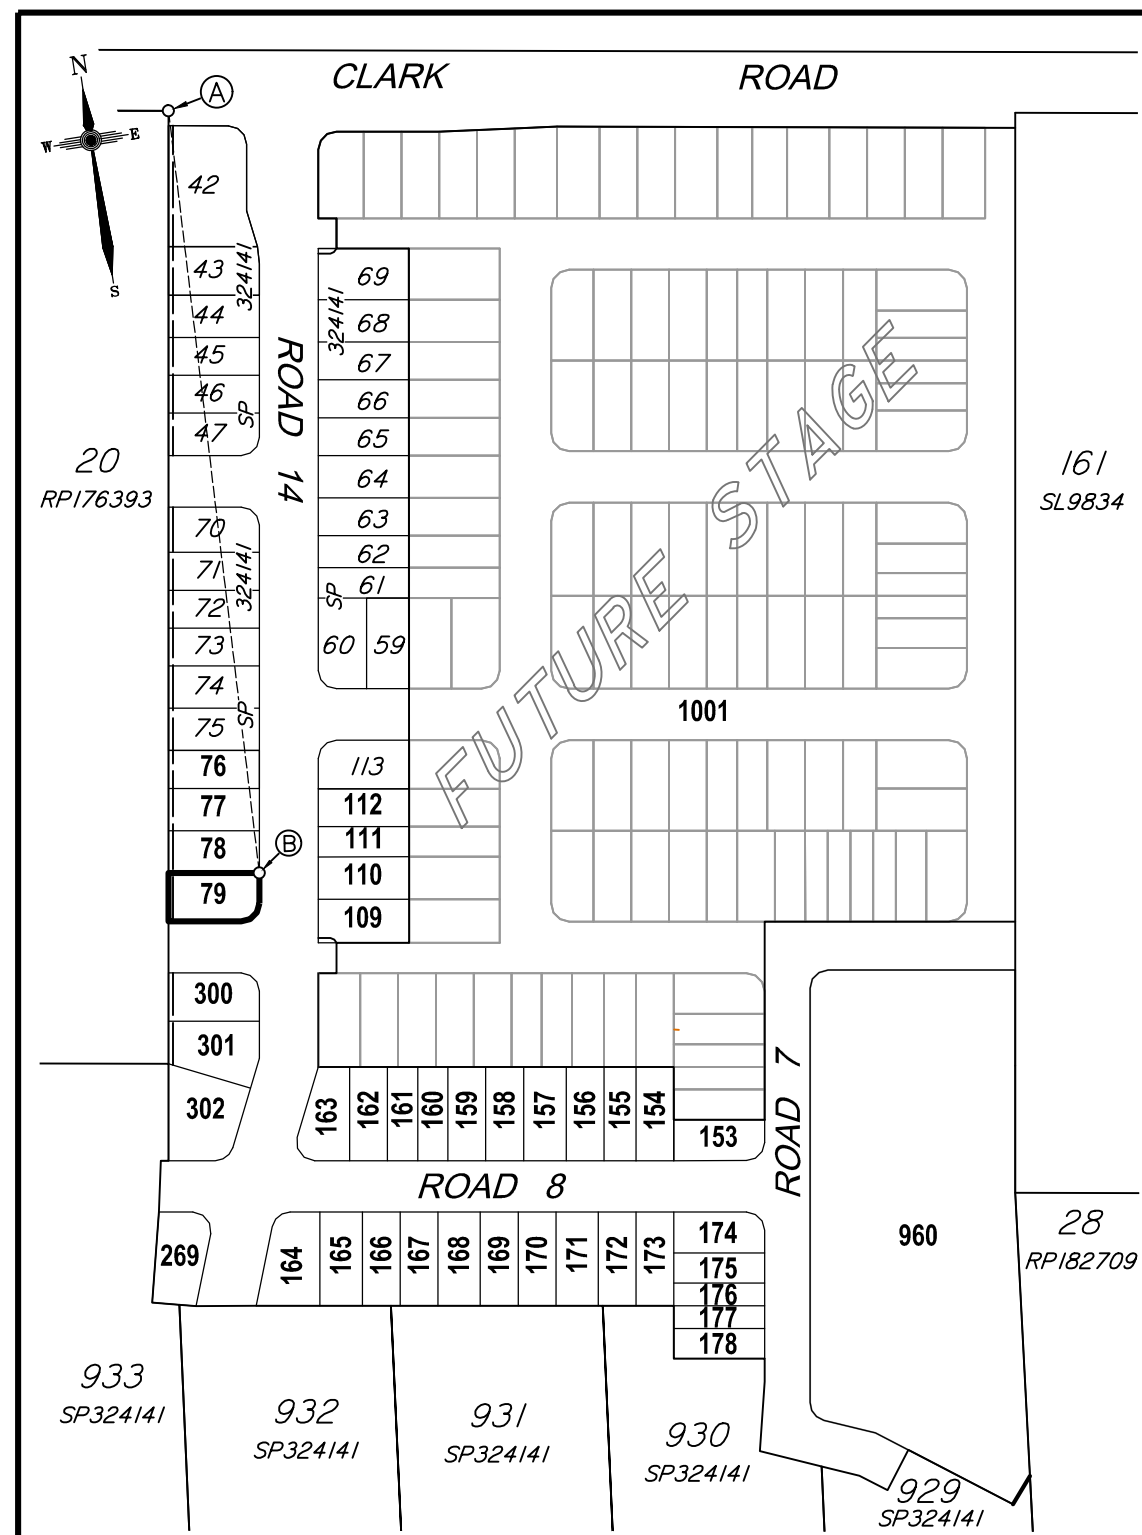

Disclosure Plan

**Summerstone Estate,
Morayfield**

PROPOSED STAGE 2
ALLOTMENTS 76-79, 109-112, 153-178
& 300-302

Cancelling Lot 1000 on SP324141
(Formally Lots 21-24 on RP176393)

PROPOSED LOT 79

DETAIL SURVEY COMPLETED BY LSD
26/06/2021.
ENGINEERING DESIGN BY GREEN-HAVEN PROJECTS.
ANY FILLING ON THIS LOT IS TO BE COMPLETED TO LEVEL ONE SUPERVISION AND TESTING IN ACCORDANCE WITH THE REQUIREMENTS OF AS 3798-2007 "GUIDELINES ON EARTHWORKS FOR COMMERCIAL AND RESIDENTIAL DEVELOPMENTS".

Revisions	Surveyed	Drawn	Checked	Passed	Date
B EMT UPDATES	LSD	MH	MH	LS	1/10/21
A ORIGINAL PLAN	LSD	LA	MH	LS	20/07/21



PO Box 6334, Maroochydore BC QLD 4558
10/1 Newspaper Place, Maroochydore QLD 4558
Mobile: 0412 666 516
Email: mail@landsurveyingdynamics.com
Web: www.landsurveyingdynamics.com
Land Surveying Dynamics (LSD) Pty Ltd
ACN 154 593 870

Signed
Cadastral Surveyor/Director
Date 1/10/2021

Horiz. Datum MGA20 Z56
Origin GNSS CORS

Vert. Datum AHD
Origin PSM 42642
RL 25.417 AHD

Locality: Morayfield


Local Government: Moreton Bay R.C.


SHEET 1 OF 1	Scale As shown at A3
COMPUTER FILE 12244-DIS	REV.
DRAWING NUMBER	12116-DIS-79
	B

CADASTRAL CONNECTION


A - B 182°10'30" 253.78

Scale 1:2000 - Lengths are in Metres.

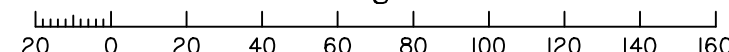

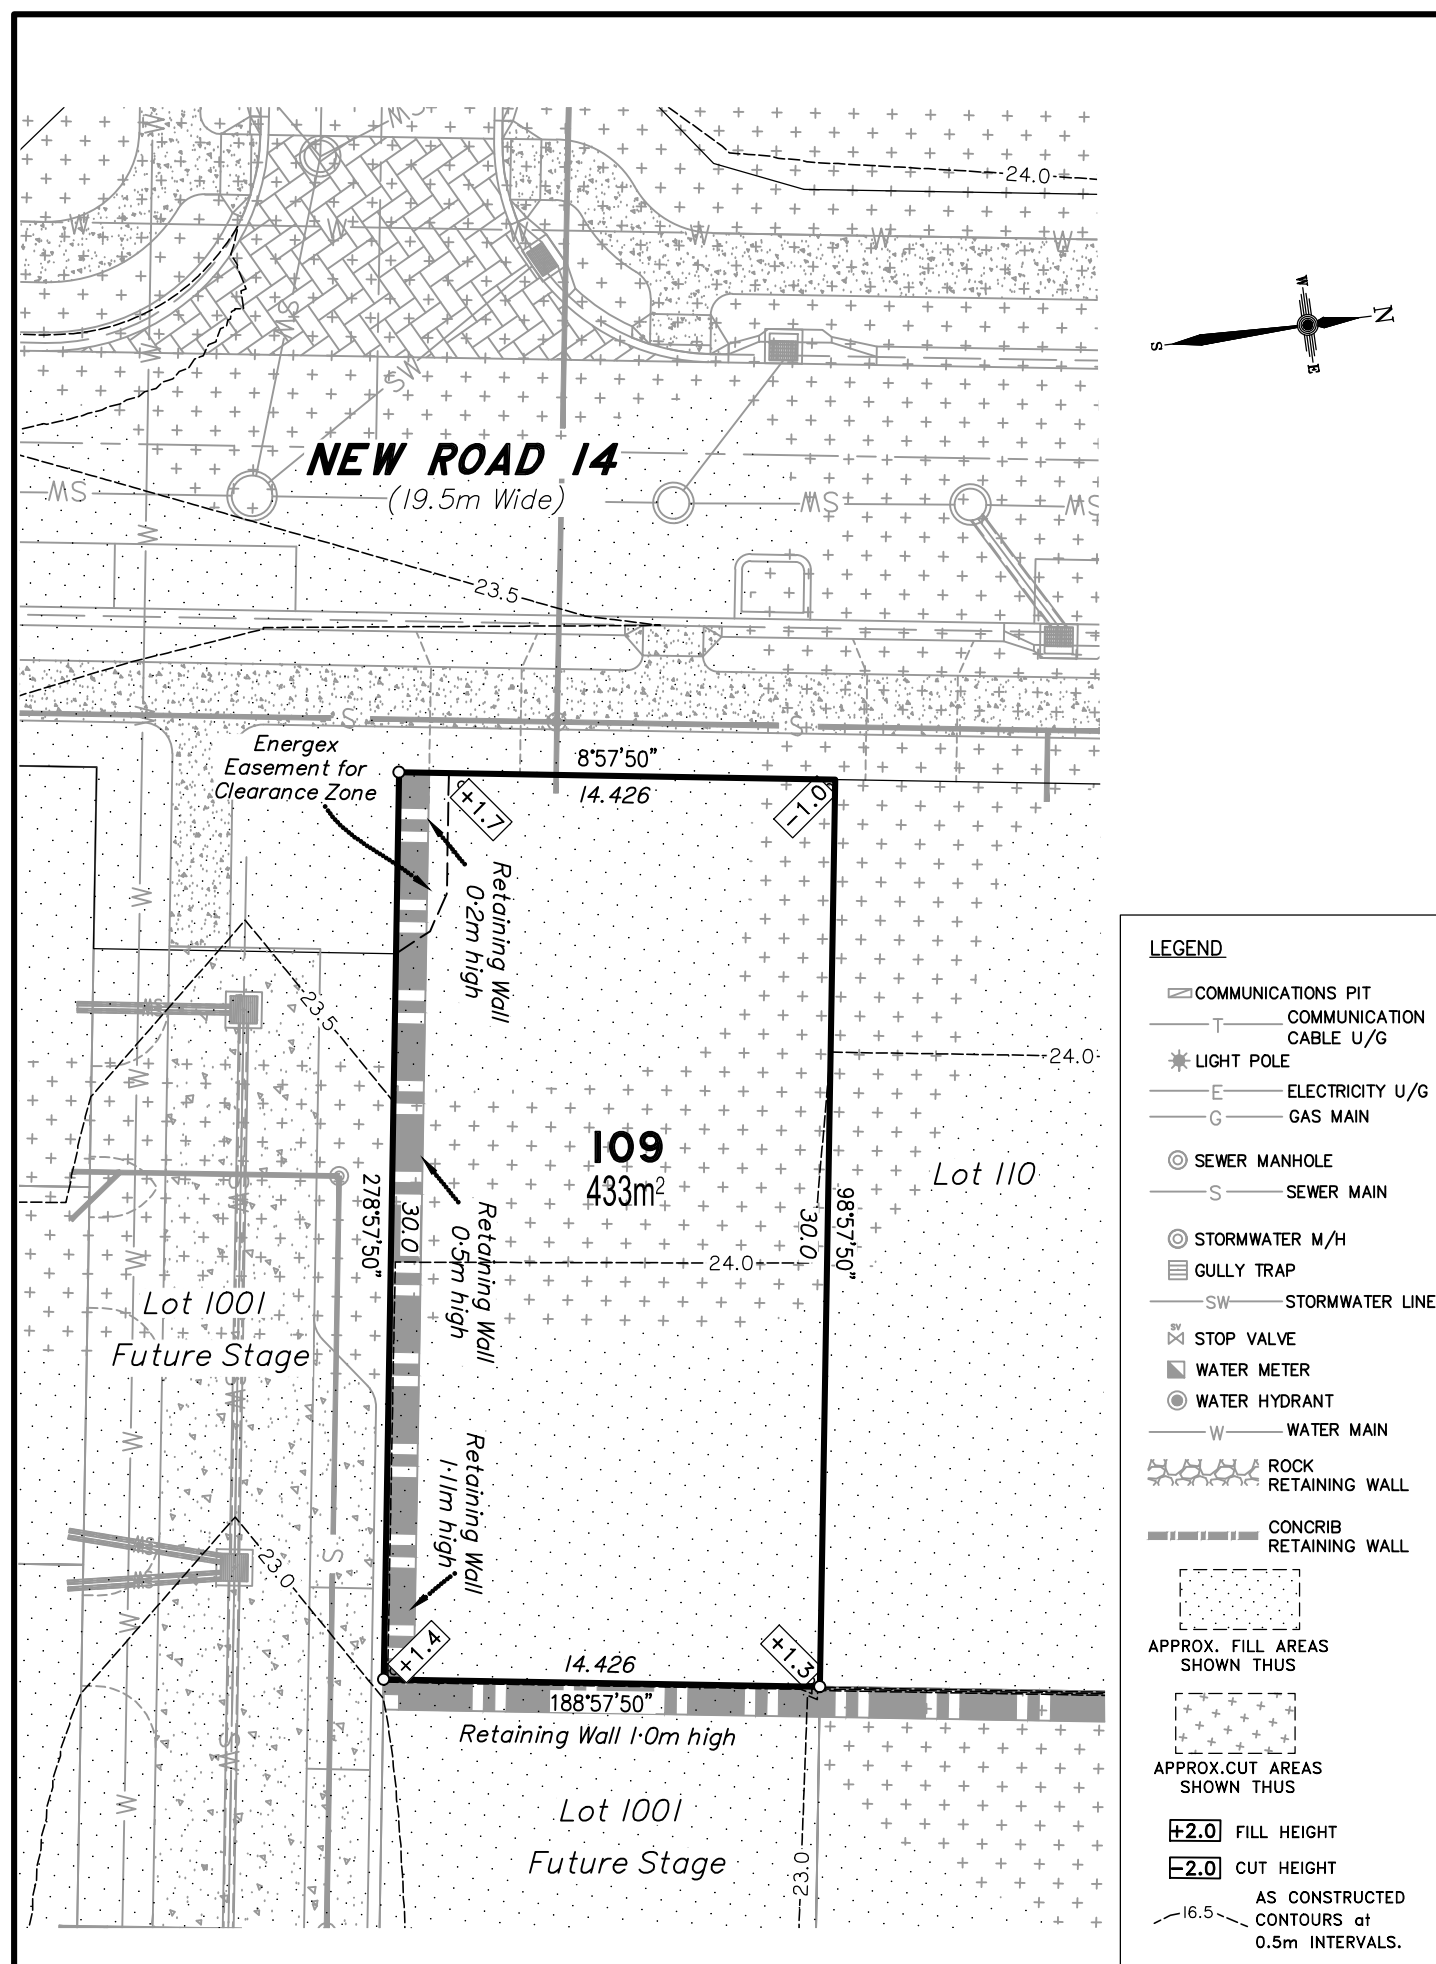


Scale 1:250 - Lengths are in Metres.

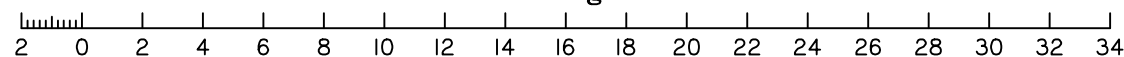

CADASTRAL CONNECTION

A - B 178°12'35" 265.297

Scale 1:2000 - Lengths are in Metres.

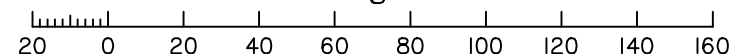


DISCLOSURE PLAN FOR PROPOSED ALLOTMENT 109

Dated 20th July 2021

This plan shows details of Proposed Allotment 109 on the Proposal Plan 12244-PRO-17 Rev G dated 14/12/2020, which complies with the Development Approval DA/34253/2017/V3RL dated 17th February 2021, approved by Moreton Bay Regional Council, subject to conditions, and associated Judgment by the Planning and Environment Court (1987 of 2018).

The description of the proposed allotment 109, is as part of Lot 1000 on SP324141 (Formally lots 21-24 on RP176393), and situated at Clark Road, Morayfield, commencing at an initial point (A) being the north eastern most point of Lot 20 on RP176393 and thence bounding off on a bearing of 178°12'35" and a distance of 265.297m to point (B) at proposed allotment 109, and containing an area of 433 square metres, more or less.

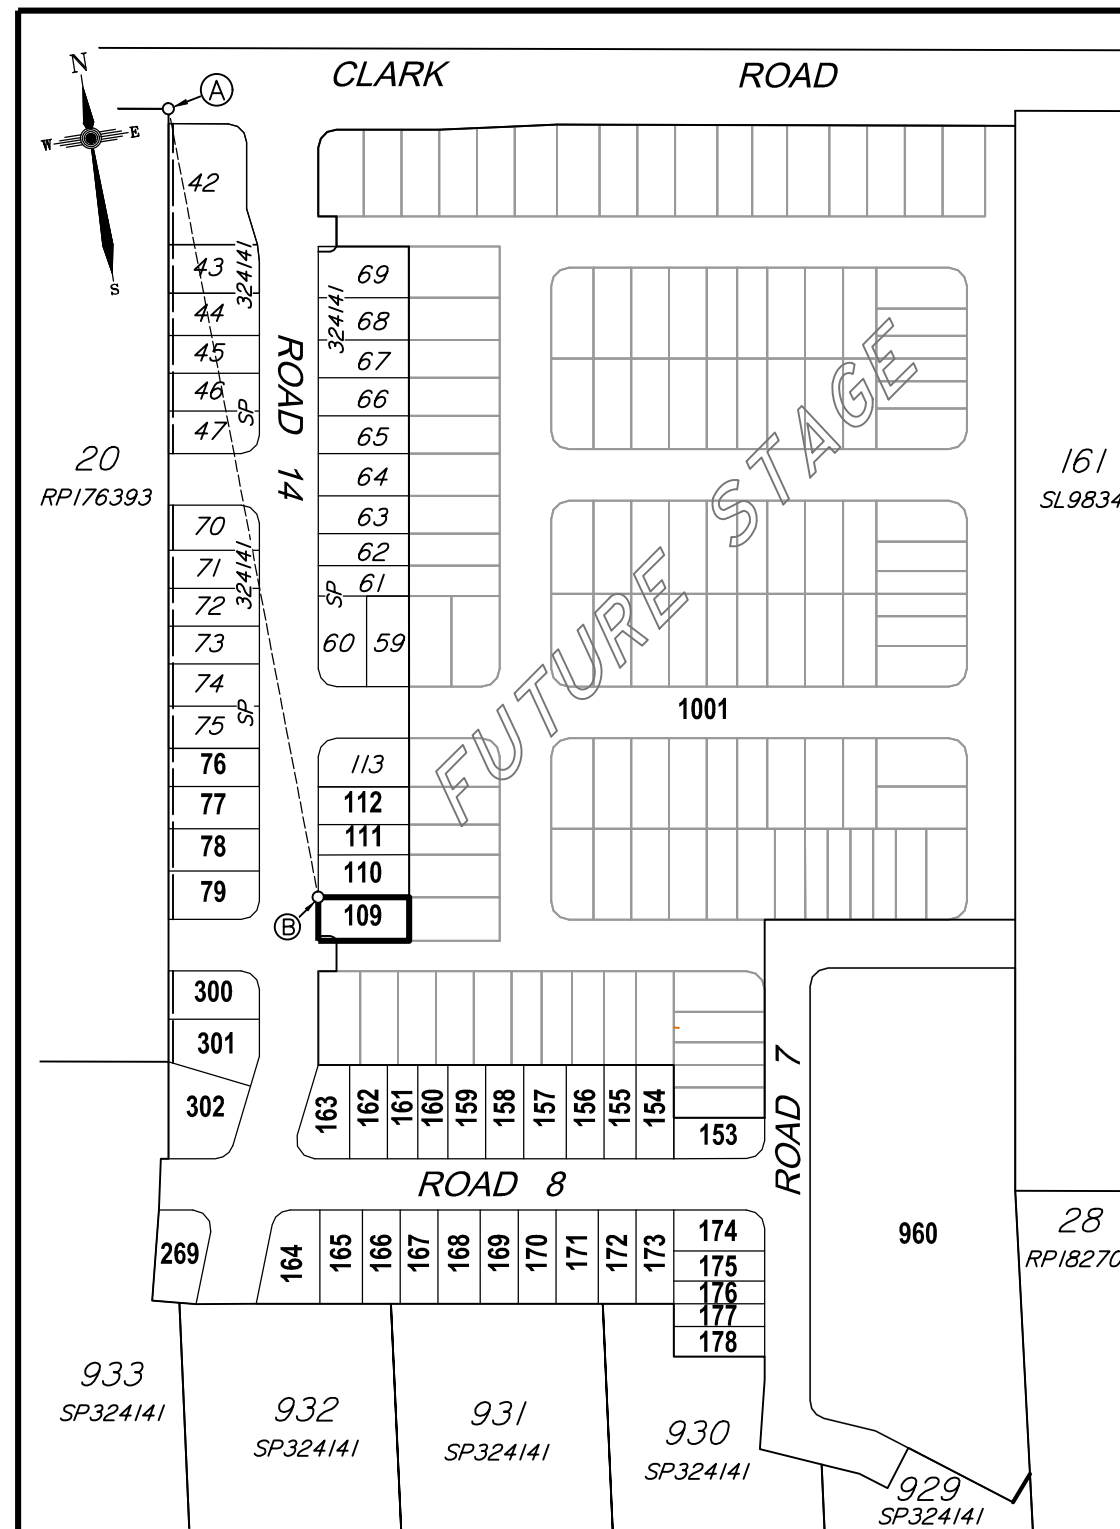

Disclosure Plan

**Summerstone Estate,
Morayfield**

PROPOSED STAGE 2
ALLOTMENTS 76-79, 109-112, 153-178
& 300-302

Cancelling Lot 1000 on SP324141
(Formally Lots 21-24 on RP176393)

PROPOSED LOT 109

DETAIL SURVEY COMPLETED BY LSD
26/06/2021.
ENGINEERING DESIGN BY GREEN-
HAVEN PROJECTS.
ANY FILLING ON THIS LOT IS TO BE
COMPLETED TO LEVEL ONE
SUPERVISION AND TESTING IN
ACCORDANCE WITH THE
REQUIREMENTS OF AS 3798-2007
"GUIDELINES ON EARTHWORKS FOR
COMMERCIAL AND RESIDENTIAL
DEVELOPMENTS".

Revisions	Surveyed	Drawn	Checked	Passed	Date
B EMT UPDATES	LSD	MH	MH	LS	1/10/21
A ORIGINAL PLAN	LSD	LA	MH	LS	20/07/21



PO Box 6334, Maroochydore BC QLD 4558
10/1 Newspaper Place, Maroochydore QLD 4558
Mobile: 0412 666 516
Email: mail@landsurveyingdynamics.com
Web: www.landsurveyingdynamics.com
Land Surveying Dynamics (LSD) Pty Ltd
ACN 154 593 670

Signed
Cadastral Surveyor/Director
Date 1/10/2021

Horiz. Datum MGA20 Z56
Origin GNSS CORS

Vert. Datum AHD
Origin PSM 42642
RL 25.417 AHD


Locality: Morayfield

Local Government: Moreton Bay R.C.

SHEET 1 OF 1 Scale **As shown at A3**

COMPUTER FILE 12244-DIS
DRAWING NUMBER REV.


12116-DIS-109 **B**

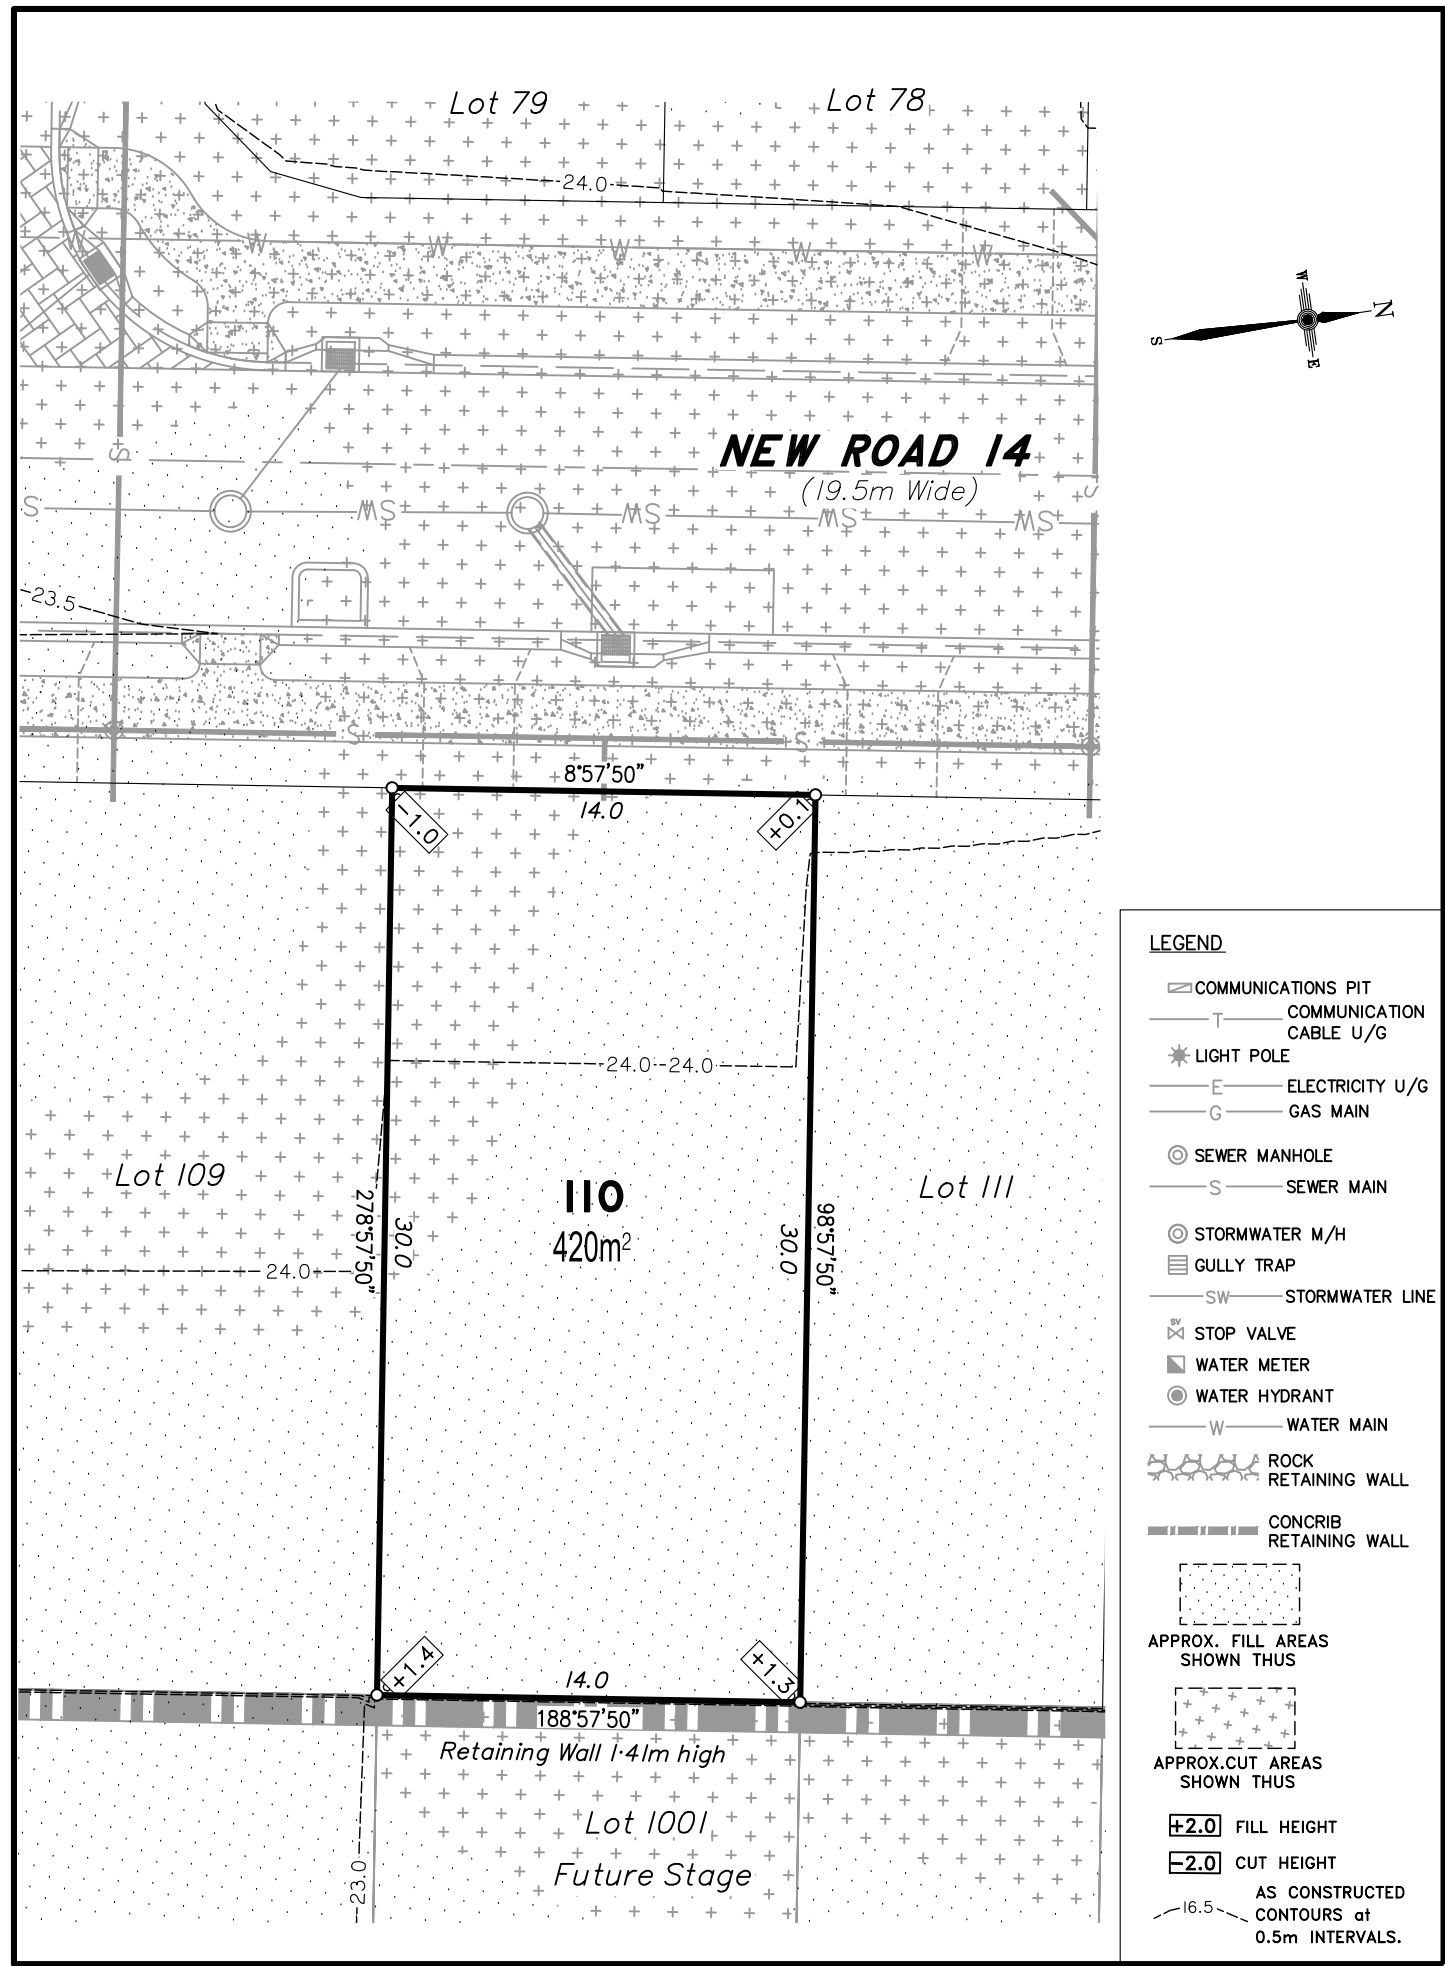

DISCLOSURE PLAN
FOR PROPOSED ALLOTMENT 110
Dated 20th July 2021

This plan shows details of Proposed Allotment 110 on the Proposal Plan 12244-PRO-17 Rev G dated 14/12/2020, which complies with the Development Approval DA/34253/2017/V3RL dated 17th February 2021, approved by Moreton Bay Regional Council, subject to conditions, and associated Judgment by the Planning and Environment Court (1987 of 2018).

The description of the proposed allotment 110, is as part of Lot 1000 on SP324141 (Formally lots 21-24 on RP176393), and situated at Clark Road, Morayfield, commencing at an initial point (A) being the north eastern most point of Lot 20 on RP176393 and thence bounding off on a bearing of 178°12'35" and a distance of 265.297m to point (B) at proposed allotment 110, and containing an area of 420 square metres, more or less.

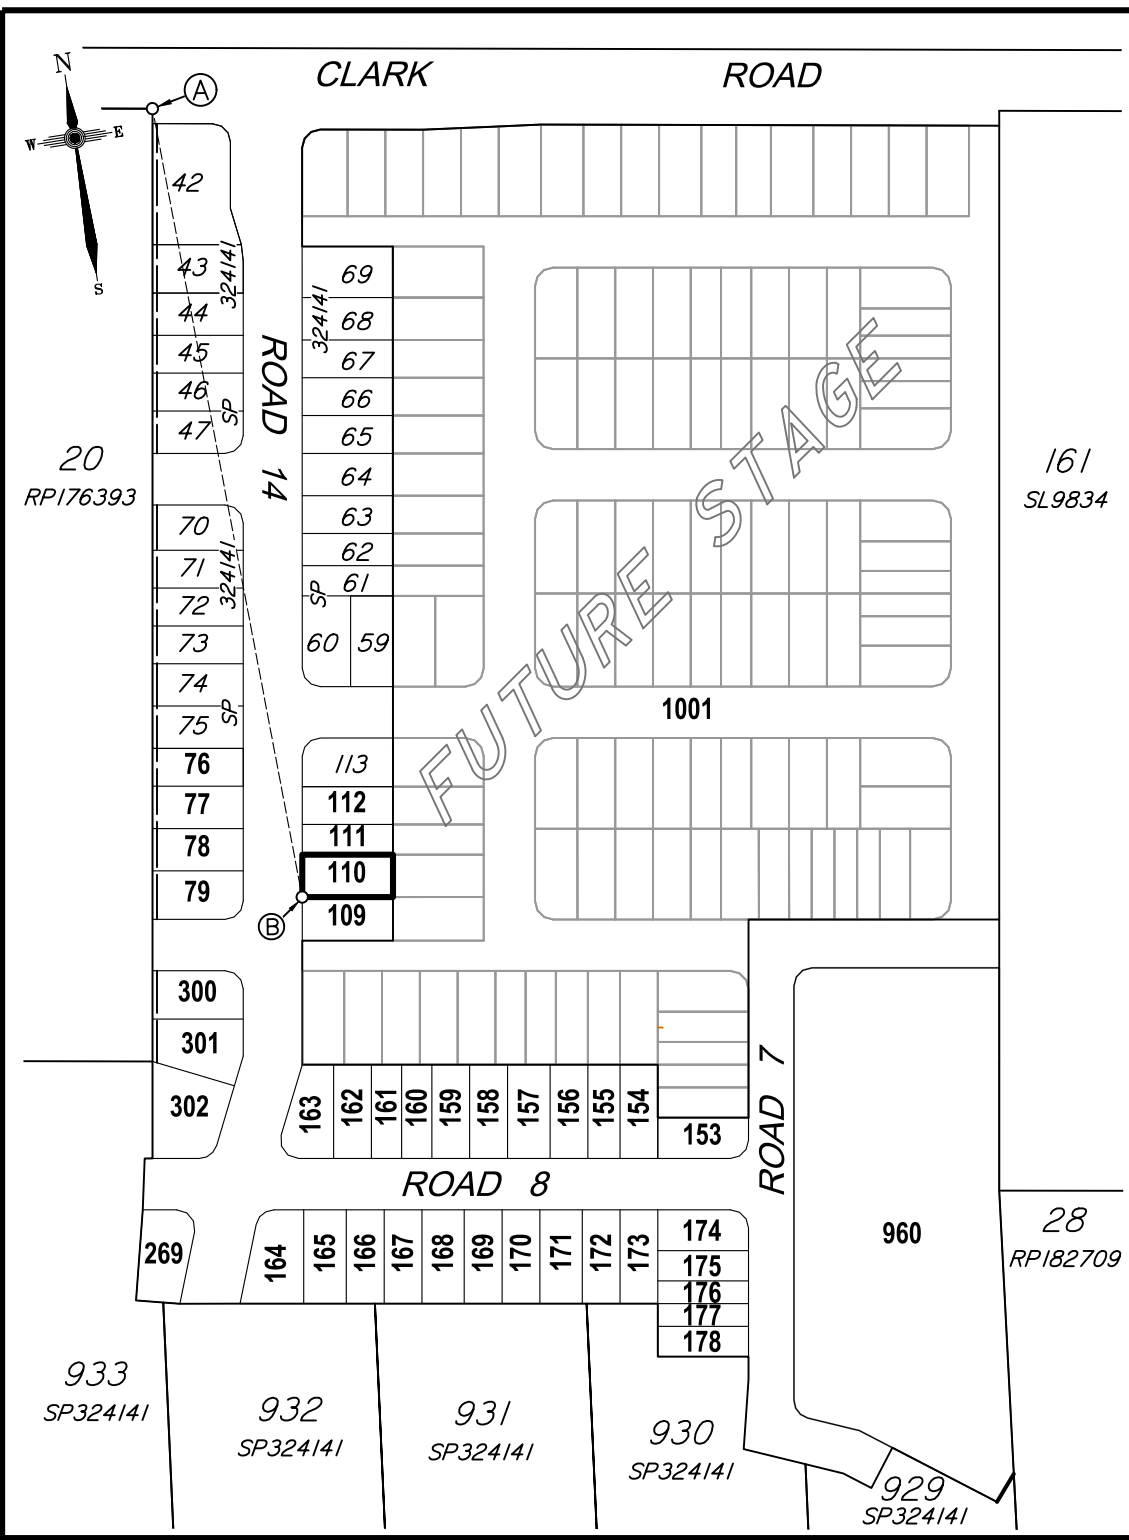

Disclosure Plan
Summerstone Estate,
Morayfield
PROPOSED STAGE 2
ALLOTMENTS 76-79, 109-112, 153-178
& 300-302
Cancelling Lot 1000 on SP324141
(Formally Lots 21-24 on RP176393)
PROPOSED LOT 110

DETAIL SURVEY COMPLETED BY LSD 26/06/2021.
 ENGINEERING DESIGN BY GREEN-HAVEN PROJECTS.
 ANY FILLING ON THIS LOT IS TO BE COMPLETED TO LEVEL ONE SUPERVISION AND TESTING IN ACCORDANCE WITH THE REQUIREMENTS OF AS 3798-2007 "GUIDELINES ON EARTHWORKS FOR COMMERCIAL AND RESIDENTIAL DEVELOPMENTS".


Revisions	Surveyed	Drawn	Checked	Passed	Date


LSD
 LAND SURVEYING DYNAMICS
 PO Box 6334, Maroochydore BC QLD 4558
 10/1 Newspaper Place, Maroochydore QLD 4558
 Mobile: 0412 666 516
 Email: mail@landsurveyingdynamics.com
 Web: www.landsurveyingdynamics.com
 Land Surveying Dynamics (LSD) Pty Ltd
 ACN 154 593 870


Signed 
 Cadastral Surveyor/Director
 Date 20/7/2021

Horiz. Datum MGA20 Z56
 Origin GNSS CORS
 Vert. Datum AHD
 Origin PSM 42642
 RL 25.417 AHD
 Locality: Morayfield
 Local Government: Moreton Bay R.C.

SHEET 1 OF 1	Scale As shown at A3
COMPUTER FILE 12244-DIS	REV.
DRAWING NUMBER	
12116-DIS-110	A

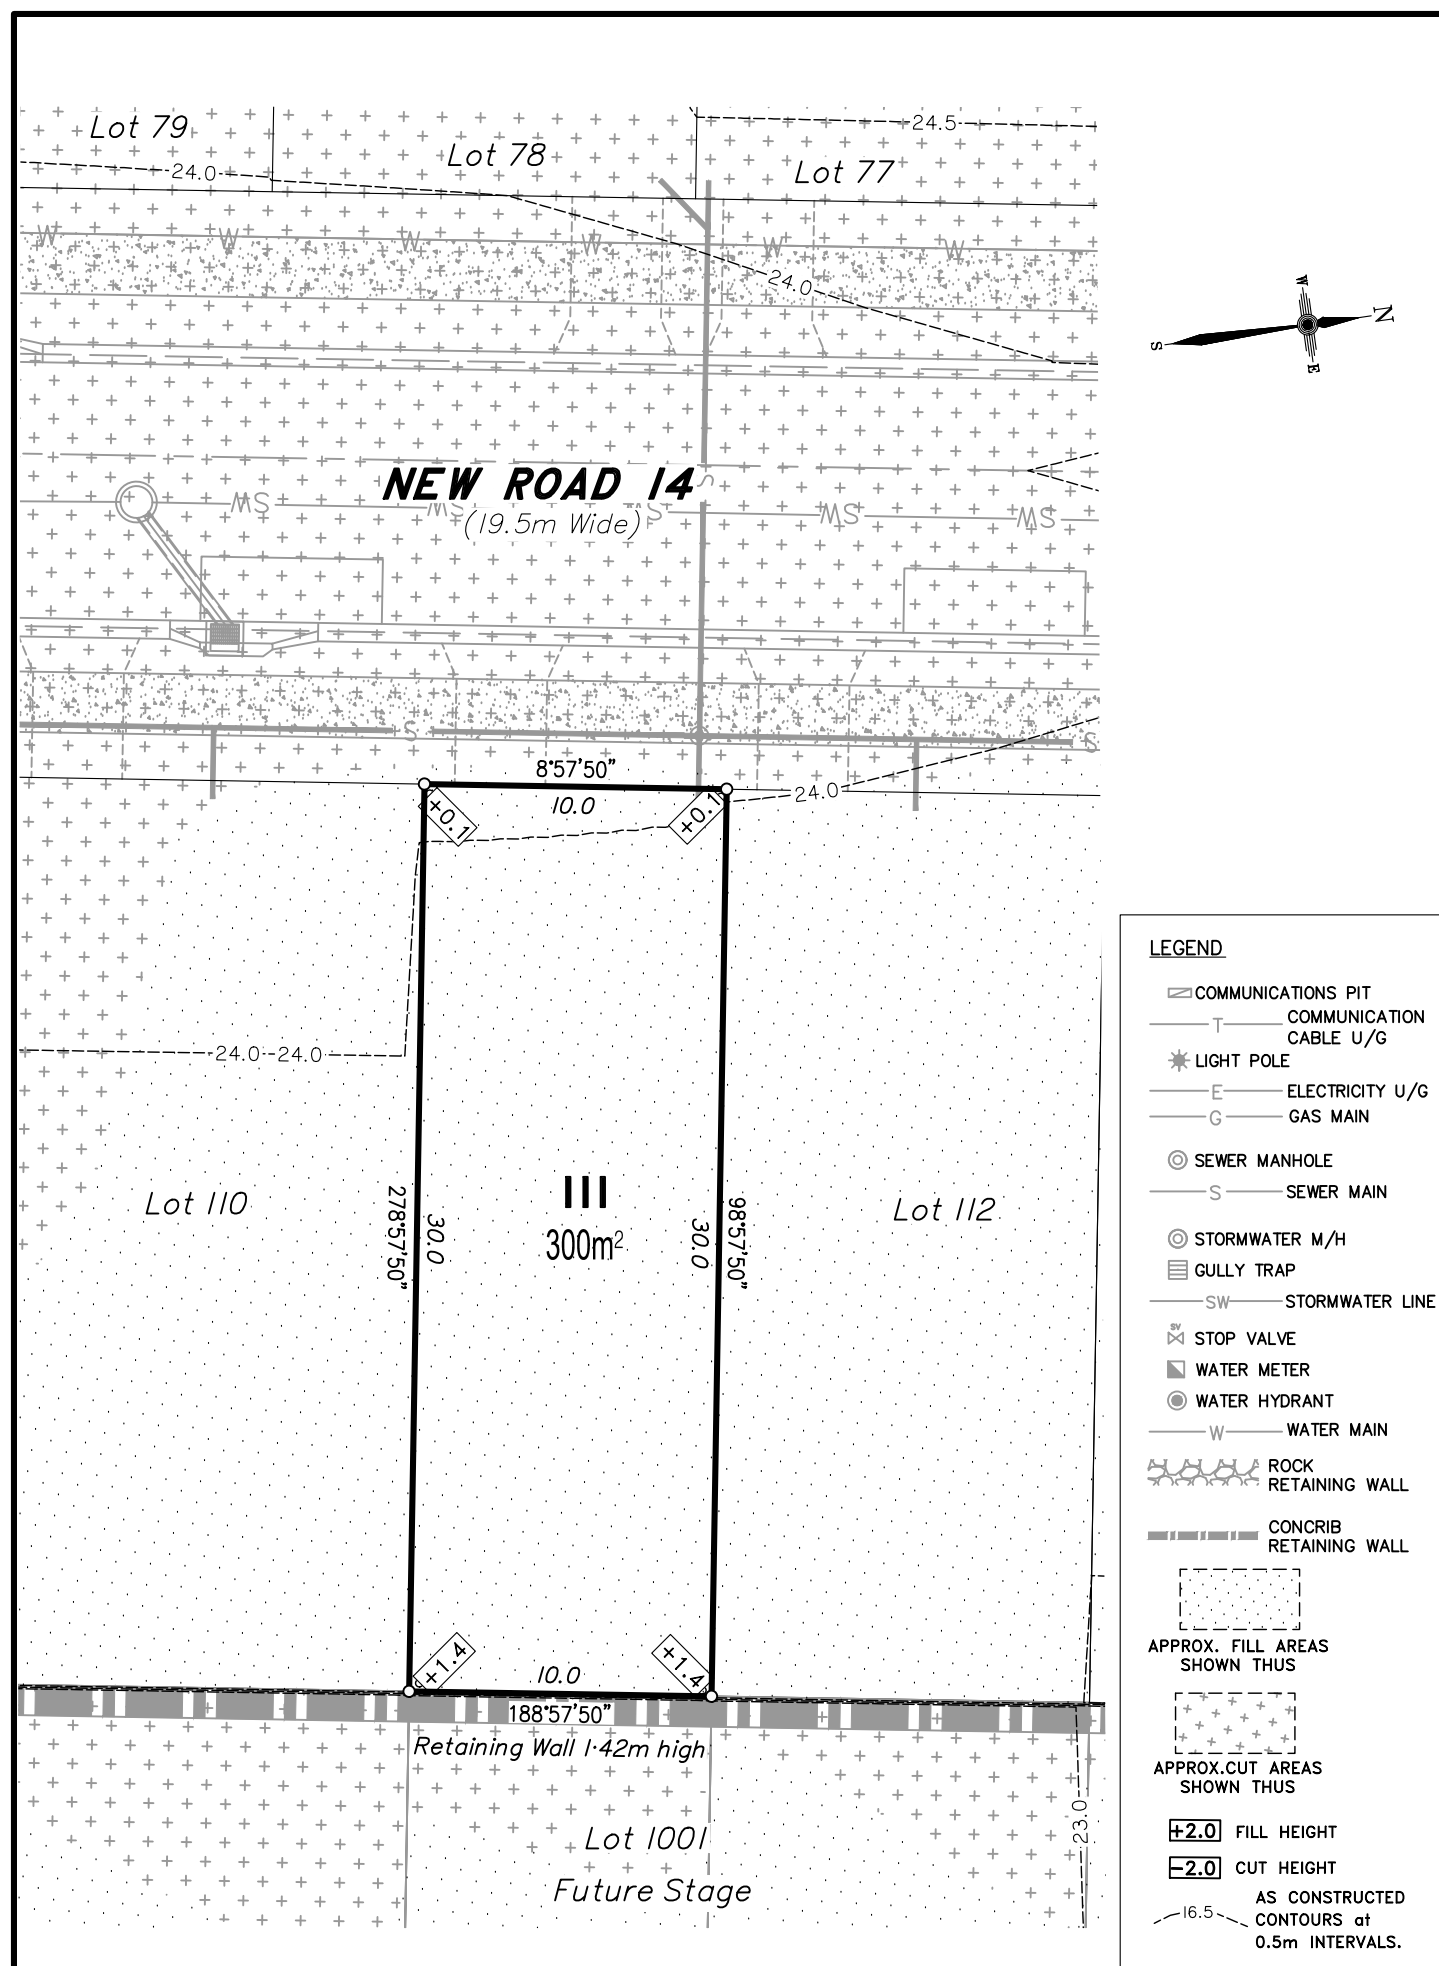


Scale 1:250 - Lengths are in Metres.

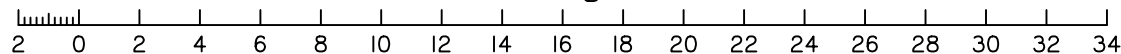

DISCLOSURE PLAN
FOR PROPOSED ALLOTMENT 111
Dated 20th July 2021

This plan shows details of Proposed Allotment 111 on the Proposal Plan 12244-PRO-17 Rev G dated 14/12/2020, which complies with the Development Approval DA/34253/2017/V3RL dated 17th February 2021, approved by Moreton Bay Regional Council, subject to conditions, and associated Judgment by the Planning and Environment Court (1987 of 2018).


The description of the proposed allotment 111, is as part of Lot 1000 on SP324141 (Formally lots 21-24 on RP176393), and situated at Clark Road, Morayfield, commencing at an initial point (A) being the north eastern most point of Lot 20 on RP176393 and thence bounding off on a bearing of 177°08'55" and a distance of 241.76m to point (B) at proposed allotment 111, and containing an area of 300 square metres, more or less.

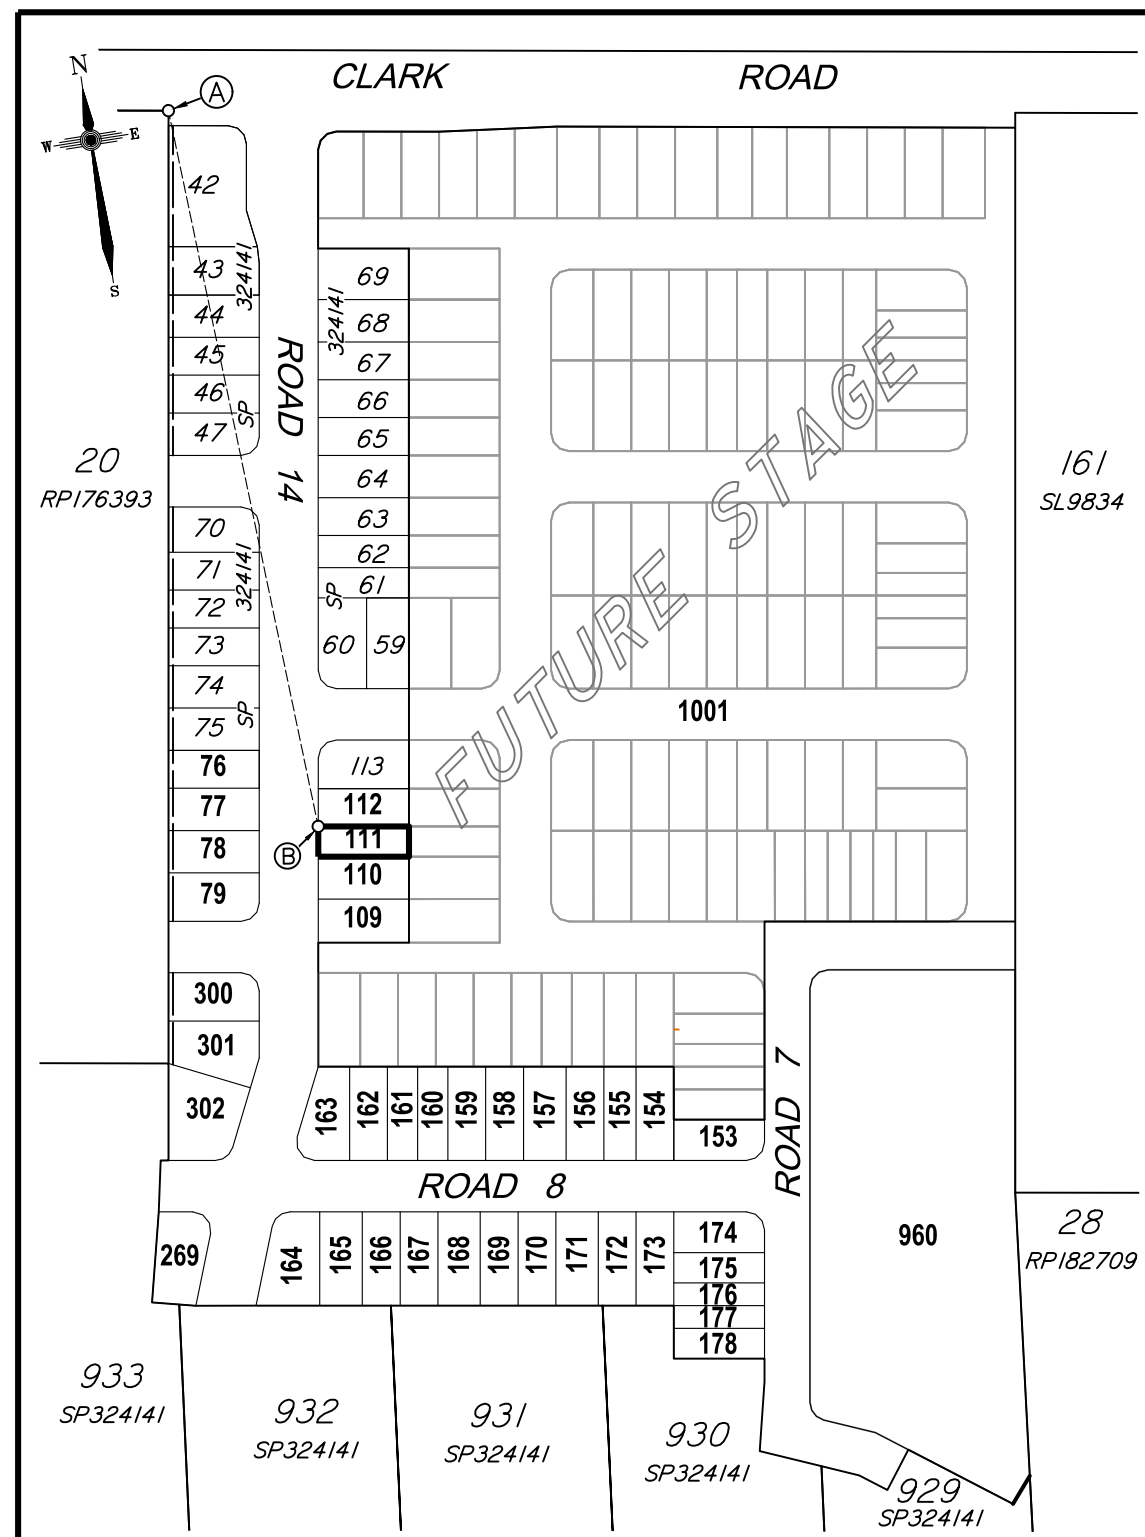

CADASTRAL CONNECTION

A - B 177°08'55" 241.76

Scale 1:2000 - Lengths are in Metres.

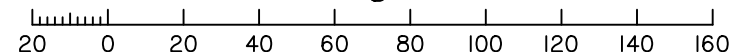

Disclosure Plan

**Summerstone Estate,
Morayfield**

PROPOSED STAGE 2
ALLOTMENTS 76-79, 109-112, 153-178
& 300-302
Cancelling Lot 1000 on SP324141
(Formally Lots 21-24 on RP176393)
PROPOSED LOT 111

DETAIL SURVEY COMPLETED BY LSD
26/06/2021.
ENGINEERING DESIGN BY GREEN-
HAVEN PROJECTS.
ANY FILLING ON THIS LOT IS TO BE
COMPLETED TO LEVEL ONE
SUPERVISION AND TESTING IN
ACCORDANCE WITH THE
REQUIREMENTS OF AS 3798-2007
"GUIDELINES ON EARTHWORKS FOR
COMMERCIAL AND RESIDENTIAL
DEVELOPMENTS".

Revisions	Surveyed	Drawn	Checked	Passed	Date
A ORIGINAL PLAN	LSD	LA	MH	LS	20/07/21



PO Box 6334, Maroochydore BC QLD 4558
10/1 Newspaper Place, Maroochydore QLD 4558
Mobile: 0412 666 516
Email: mail@landsurveyingdynamics.com
Web: www.landsurveyingdynamics.com
Land Surveying Dynamics (LSD) Pty Ltd
ACN 154 593 870

Signed
Cadastral Surveyor/Director
Date 20/7/2021

Horiz. Datum MGA20 Z56
Origin GNSS CORS

Vert. Datum AHD
Origin PSM 42642
RL 25.417 AHD


Locality: Morayfield

Local Government: Moreton Bay R.C.


SHEET 1 OF 1 Scale As shown at A3

COMPUTER FILE 12244-DIS
DRAWING NUMBER

12116-DIS-111 REV. **A**

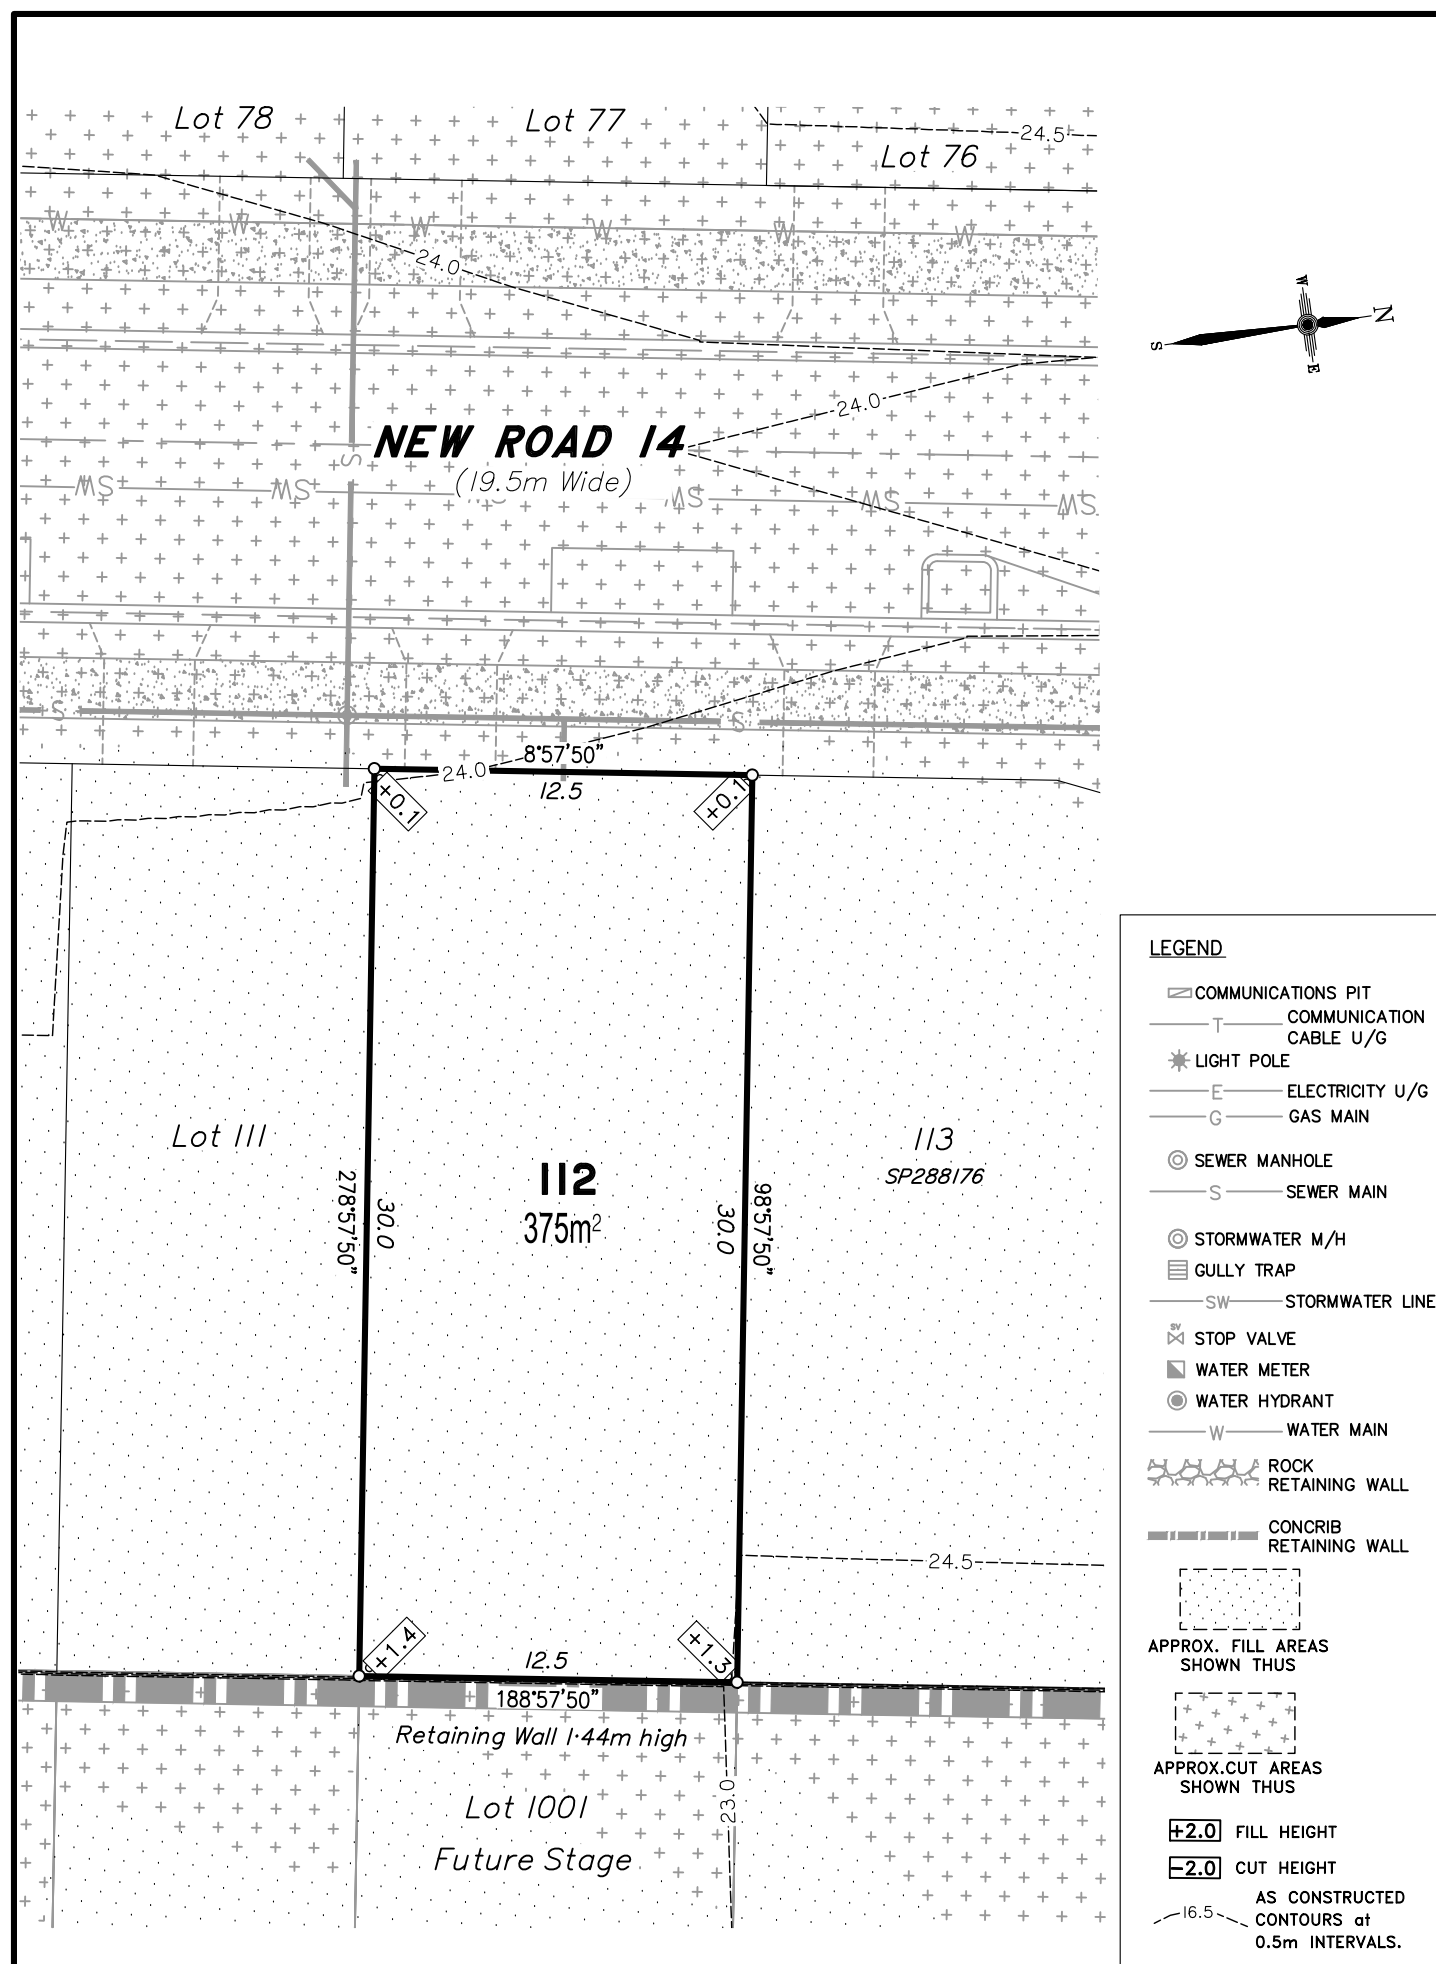


Scale 1:250 - Lengths are in Metres.

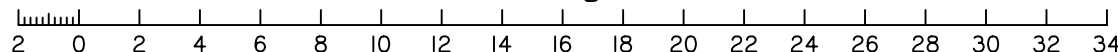


DISCLOSURE PLAN
FOR PROPOSED ALLOTMENT 112
Dated 20th July 2021

This plan shows details of Proposed Allotment 112 on the Proposal Plan 12244-PRO-17 Rev G dated 14/12/2020, which complies with the Development Approval DA/34253/2017/V3RL dated 17th February 2021, approved by Moreton Bay Regional Council, subject to conditions, and associated Judgment by the Planning and Environment Court (1987 of 2018).


The description of the proposed allotment 112, is as part of Lot 1000 on SP324141 (Formally lots 21-24 on RP176393), and situated at Clark Road, Morayfield, commencing at an initial point (A) being the north eastern most point of Lot 20 on RP176393 and thence bounding off on a bearing of 177°08'55" and a distance of 241.76m to point (B) at proposed allotment 112, and containing an area of 375 square metres, more or less.

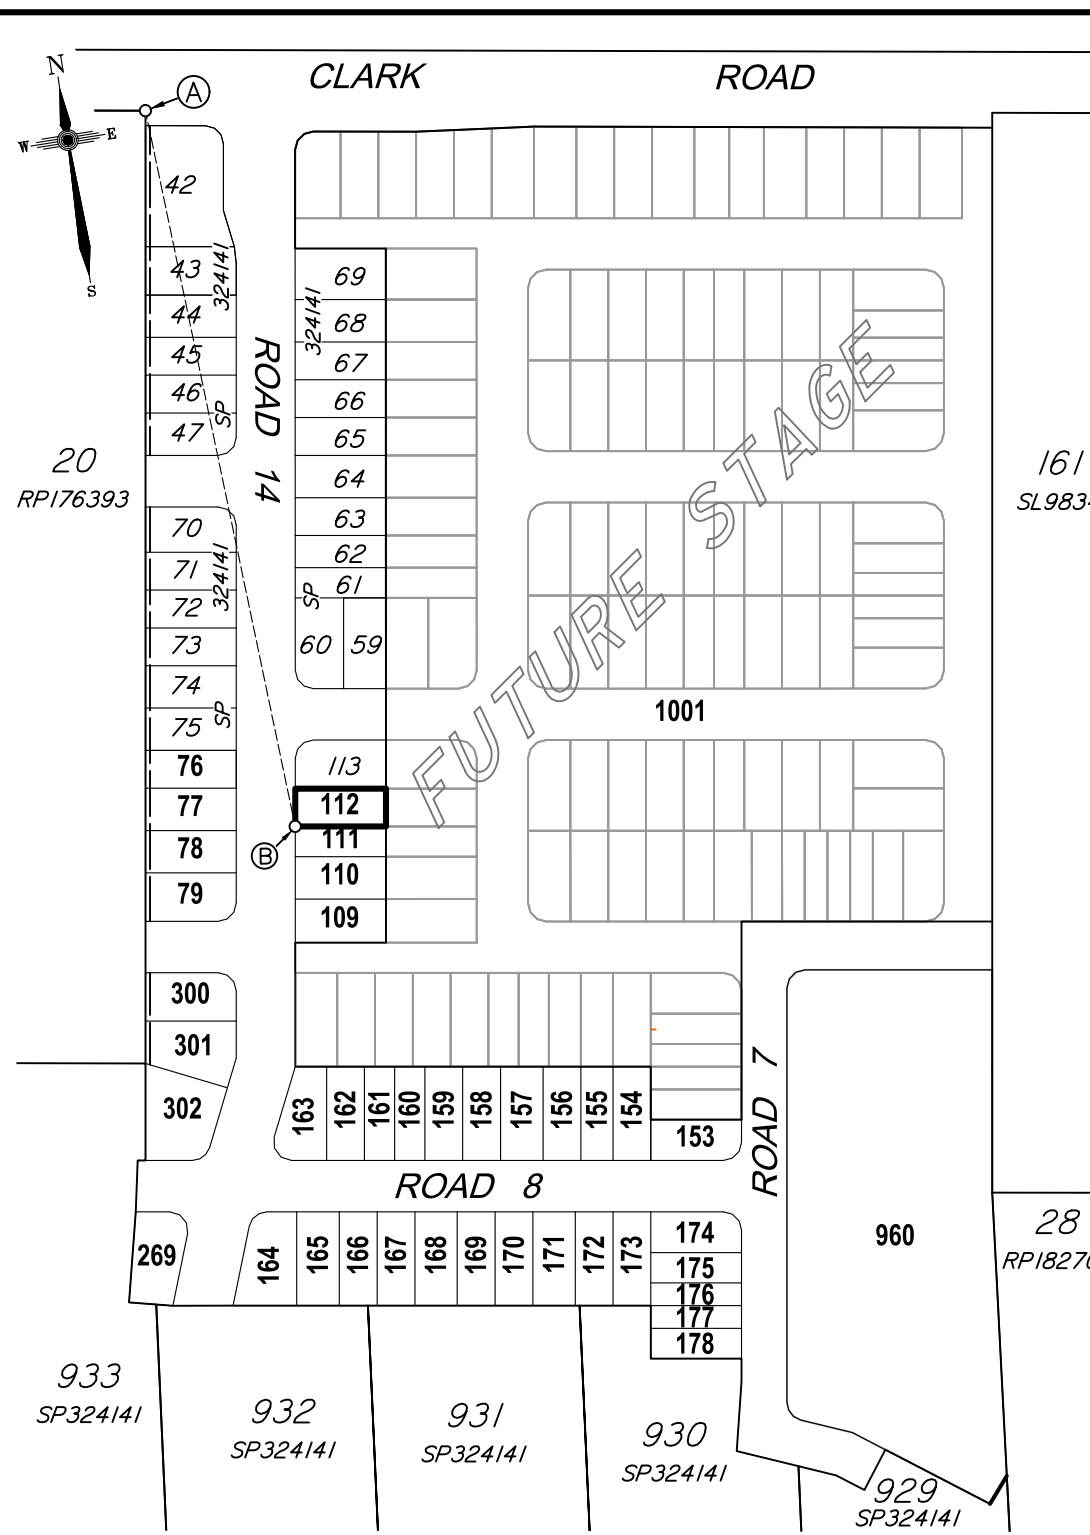

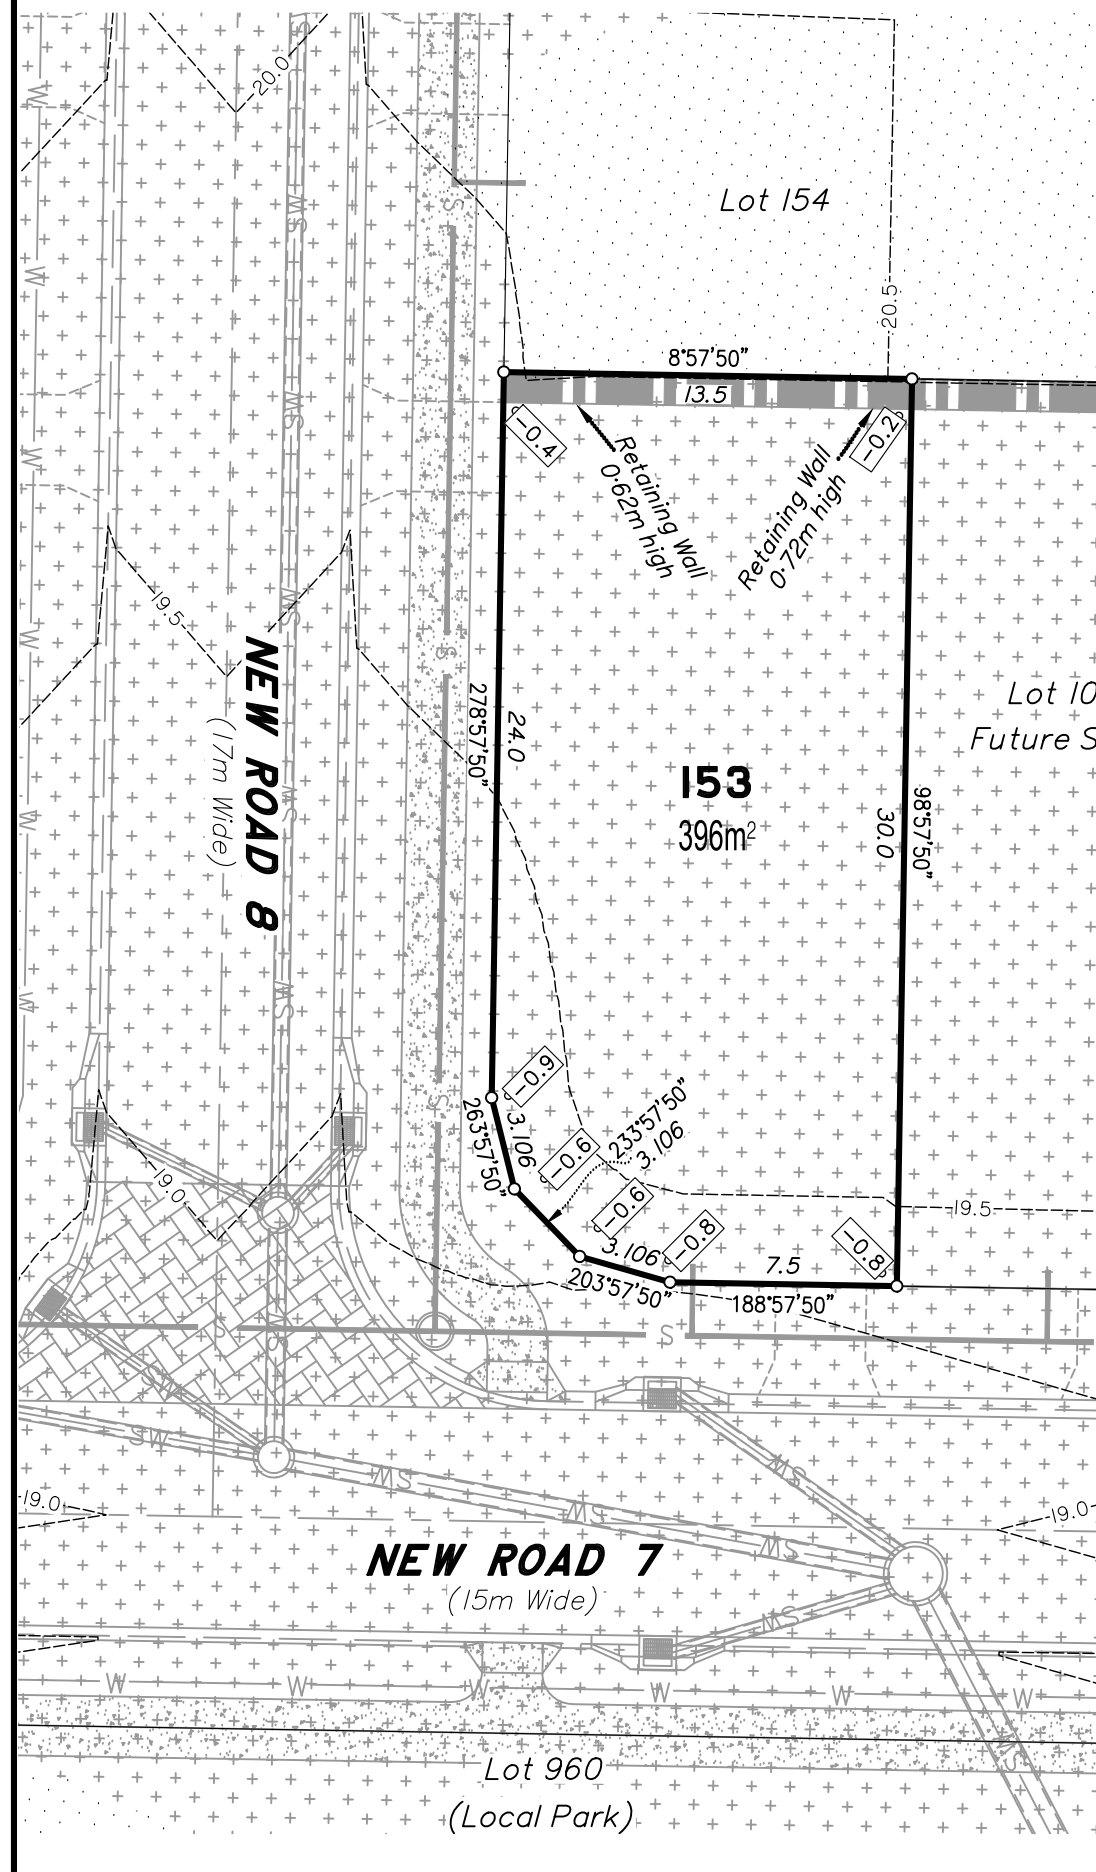

- LEGEND**
- COMMUNICATIONS PIT
 - COMMUNICATION CABLE U/G
 - LIGHT POLE
 - ELECTRICITY U/G
 - GAS MAIN
 - SEWER MANHOLE
 - SEWER MAIN
 - STORMWATER M/H
 - GULLY TRAP
 - STORMWATER LINE
 - STOP VALVE
 - WATER METER
 - WATER HYDRANT
 - WATER MAIN
 - ROCK RETAINING WALL
 - CONCRIB RETAINING WALL
 - APPROX. FILL AREAS SHOWN THUS
 - APPROX. CUT AREAS SHOWN THUS
 - +2.0 FILL HEIGHT
 - 2.0 CUT HEIGHT
 - AS CONSTRUCTED CONTOURS at 0.5m INTERVALS.

Scale 1:250 - Lengths are in Metres.

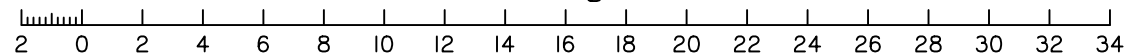


DISCLOSURE PLAN FOR PROPOSED ALLOTMENT 153

Dated 20th July 2021

This plan shows details of Proposed Allotment 153 on the Proposal Plan 12244-PRO-17 Rev G dated 14/12/2020, which complies with the Development Approval DA/34253/2017/V3RL dated 17th February 2021, approved by Moreton Bay Regional Council, subject to conditions, and associated Judgment by the Planning and Environment Court (1987 of 2018).


The description of the proposed allotment 153, is as part of Lot 1000 on SP324141 (Formally lots 21-24 on RP176393), and situated at Clark Road, Morayfield, commencing at an initial point (A) being the north eastern most point of Lot 20 on RP176393 and thence bounding off on a bearing of 158°23'15" and a distance of 387.437m to point (B) at proposed allotment 153, and containing an area of 396 square metres, more or less.

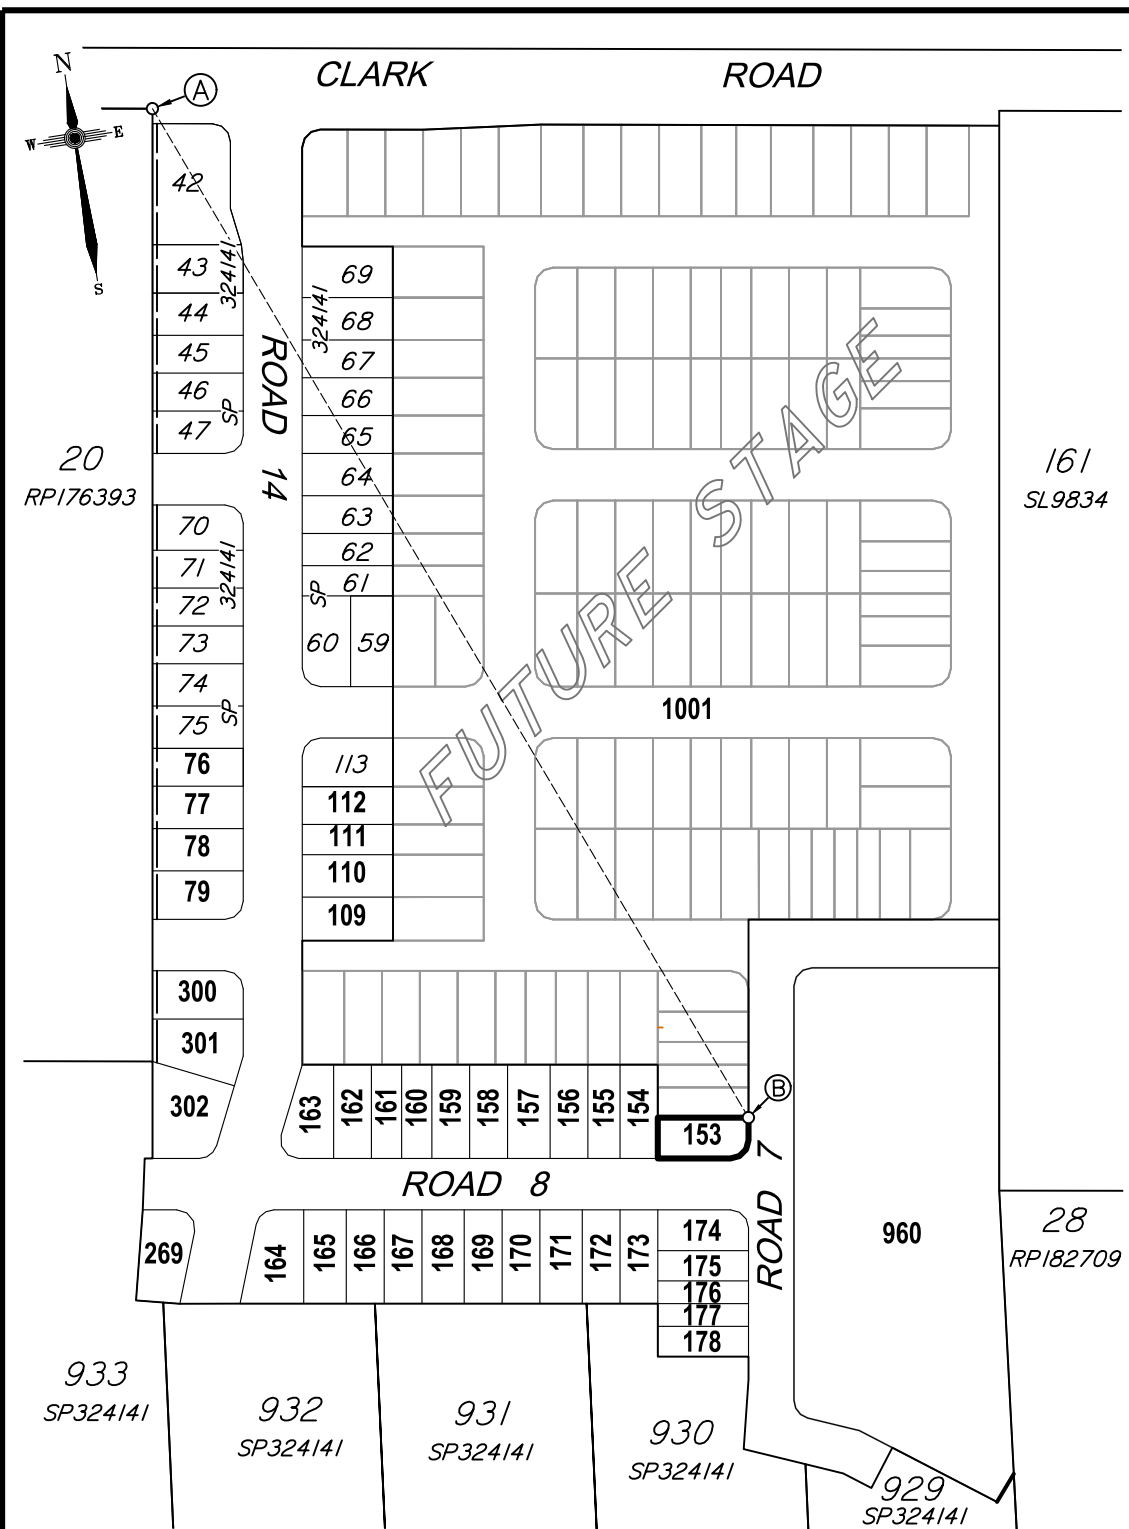

CADASTRAL CONNECTION

A - B 158°23'15" 387.437

Scale 1:2000 - Lengths are in Metres.

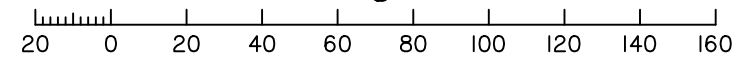

Disclosure Plan

Summerstone Estate,
Morayfield

PROPOSED STAGE 2
ALLOTMENTS 76-79, 109-112, 153-178
& 300-302
Cancelling Lot 1000 on SP324141
(Formally Lots 21-24 on RP176393)
PROPOSED LOT 153

DETAIL SURVEY COMPLETED BY LSD
26/06/2021.
ENGINEERING DESIGN BY GREEN-HAVEN PROJECTS.
ANY FILLING ON THIS LOT IS TO BE COMPLETED TO LEVEL ONE SUPERVISION AND TESTING IN ACCORDANCE WITH THE REQUIREMENTS OF AS 3798-2007 "GUIDELINES ON EARTHWORKS FOR COMMERCIAL AND RESIDENTIAL DEVELOPMENTS".

Revisions	Surveyed	Drawn	Checked	Passed	Date
A ORIGINAL PLAN	LSD	LA	MH	LS	20/07/21




PO Box 6334, Maroochydore BC QLD 4558
10/1 Newspaper Place, Maroochydore QLD 4558
Mobile: 0412 666 516
Email: mail@landsurveyingdynamics.com
Web: www.landsurveyingdynamics.com
Land Surveying Dynamics (LSD) Pty Ltd
ACN 154 593 670

Signed
Cadastral Surveyor/Director
Date 20/7/2021


Horiz. Datum MGA20 Z56
Origin GNSS CORS
Vert. Datum AHD
Origin PSM 42642
RL 25.417 AHD
Locality: Morayfield
Local Government: Moreton Bay R.C.

Scale
SHEET 1 OF 1 As shown at A3
COMPUTER FILE 12244-DIS
DRAWING NUMBER
12116-DIS-153
REV. **A**

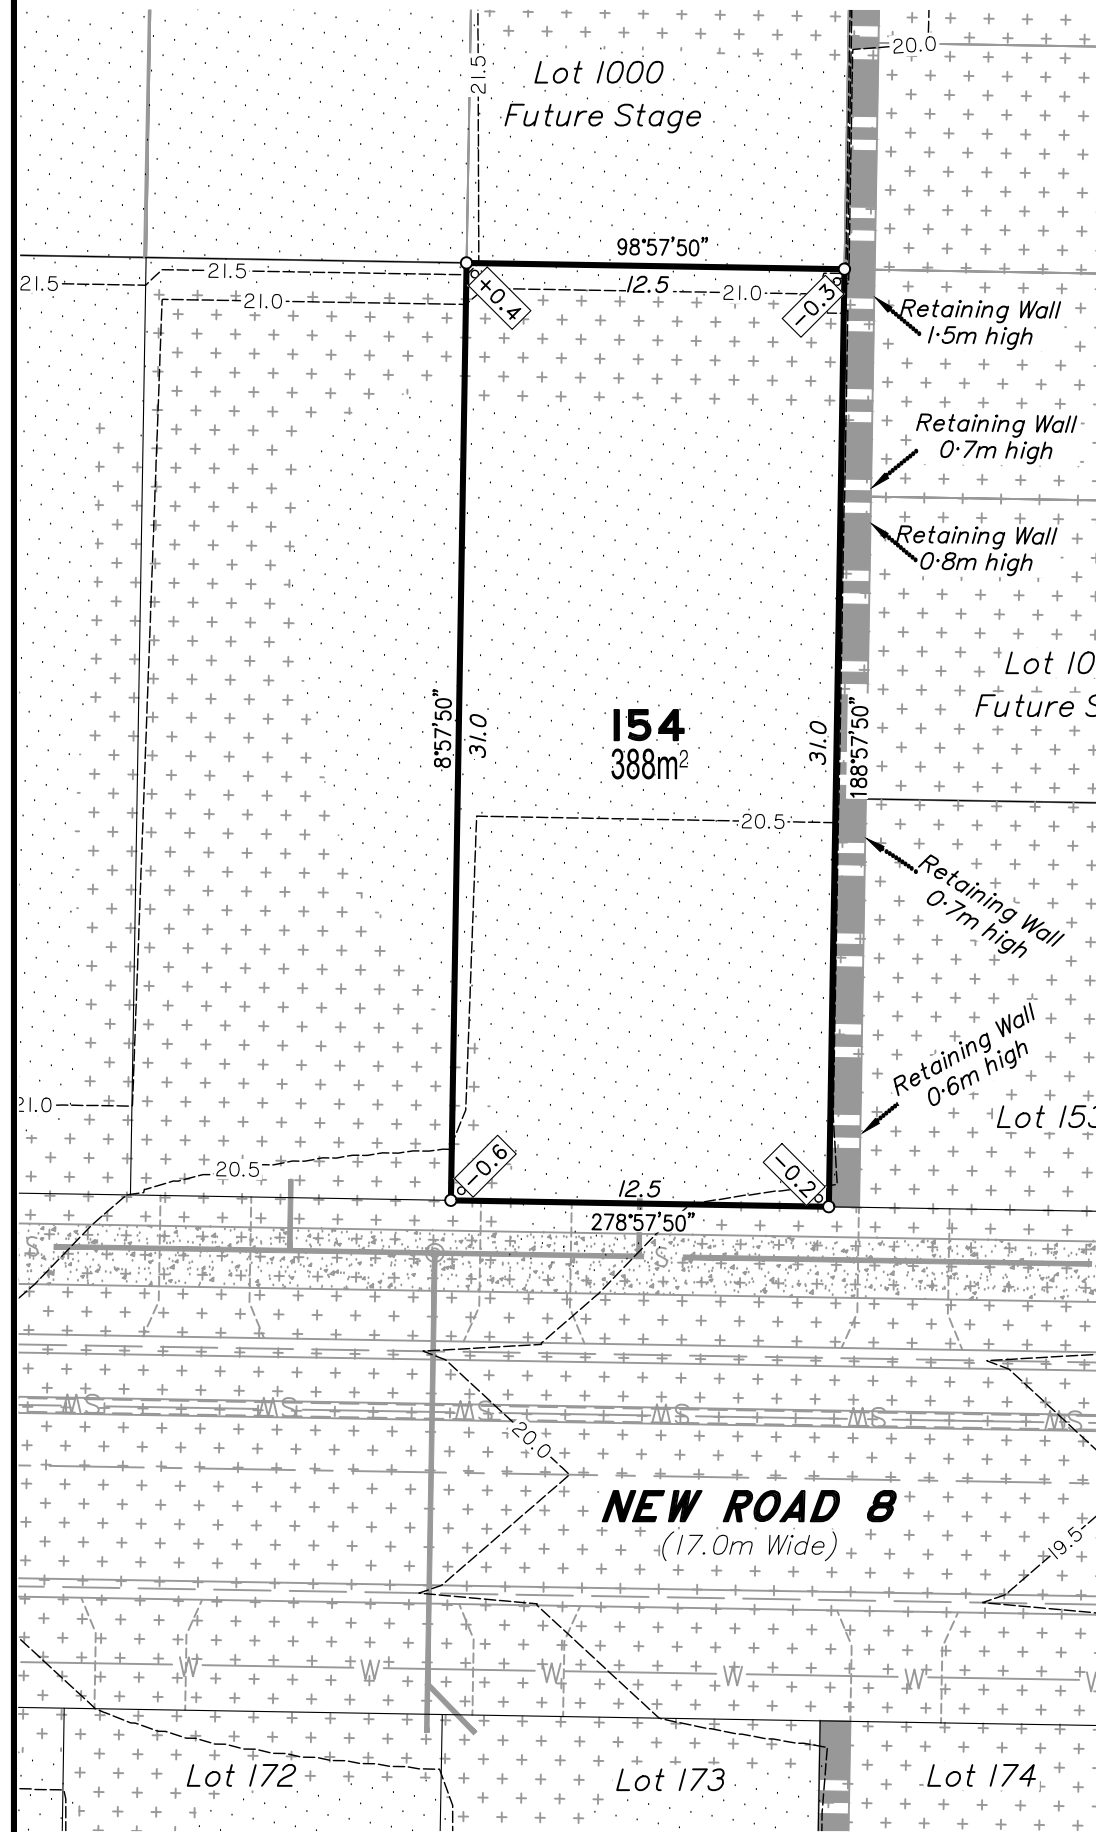

- LEGEND**
- COMMUNICATIONS PIT
 - COMMUNICATION CABLE U/G
 - LIGHT POLE
 - ELECTRICITY U/G
 - GAS MAIN
 - SEWER MANHOLE
 - SEWER MAIN
 - STORMWATER M/H
 - GULLY TRAP
 - STORMWATER LINE
 - STOP VALVE
 - WATER METER
 - WATER HYDRANT
 - WATER MAIN
 - ROCK RETAINING WALL
 - CONCRIB RETAINING WALL
 - APPROX. FILL AREAS SHOWN THUS
 - APPROX. CUT AREAS SHOWN THUS
 - +2.0 FILL HEIGHT
 - 2.0 CUT HEIGHT
 - AS CONSTRUCTED CONTOURS at 0.5m INTERVALS.

Scale 1:250 - Lengths are in Metres.

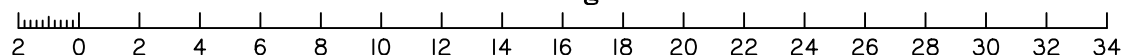



DISCLOSURE PLAN FOR PROPOSED ALLOTMENT 154

Dated 20th July 2021


This plan shows details of Proposed Allotment 154 on the Proposal Plan 12244-PRO-17 Rev G dated 14/12/2020, which complies with the Development Approval DA/34253/2017/V3RL dated 17th February 2021, approved by Moreton Bay Regional Council, subject to conditions, and associated Judgment by the Planning and Environment Court (1987 of 2018).

The description of the proposed allotment 154, is as part of Lot 1000 on SP324141 (Formally lots 21-24 on RP176393), and situated at Clark Road, Morayfield, commencing at an initial point (A) being the north eastern most point of Lot 20 on RP176393 and thence bounding off on a bearing of 164°57'20" and a distance of 379.934m to point (B) at proposed allotment 154, and containing an area of 388 square metres, more or less.

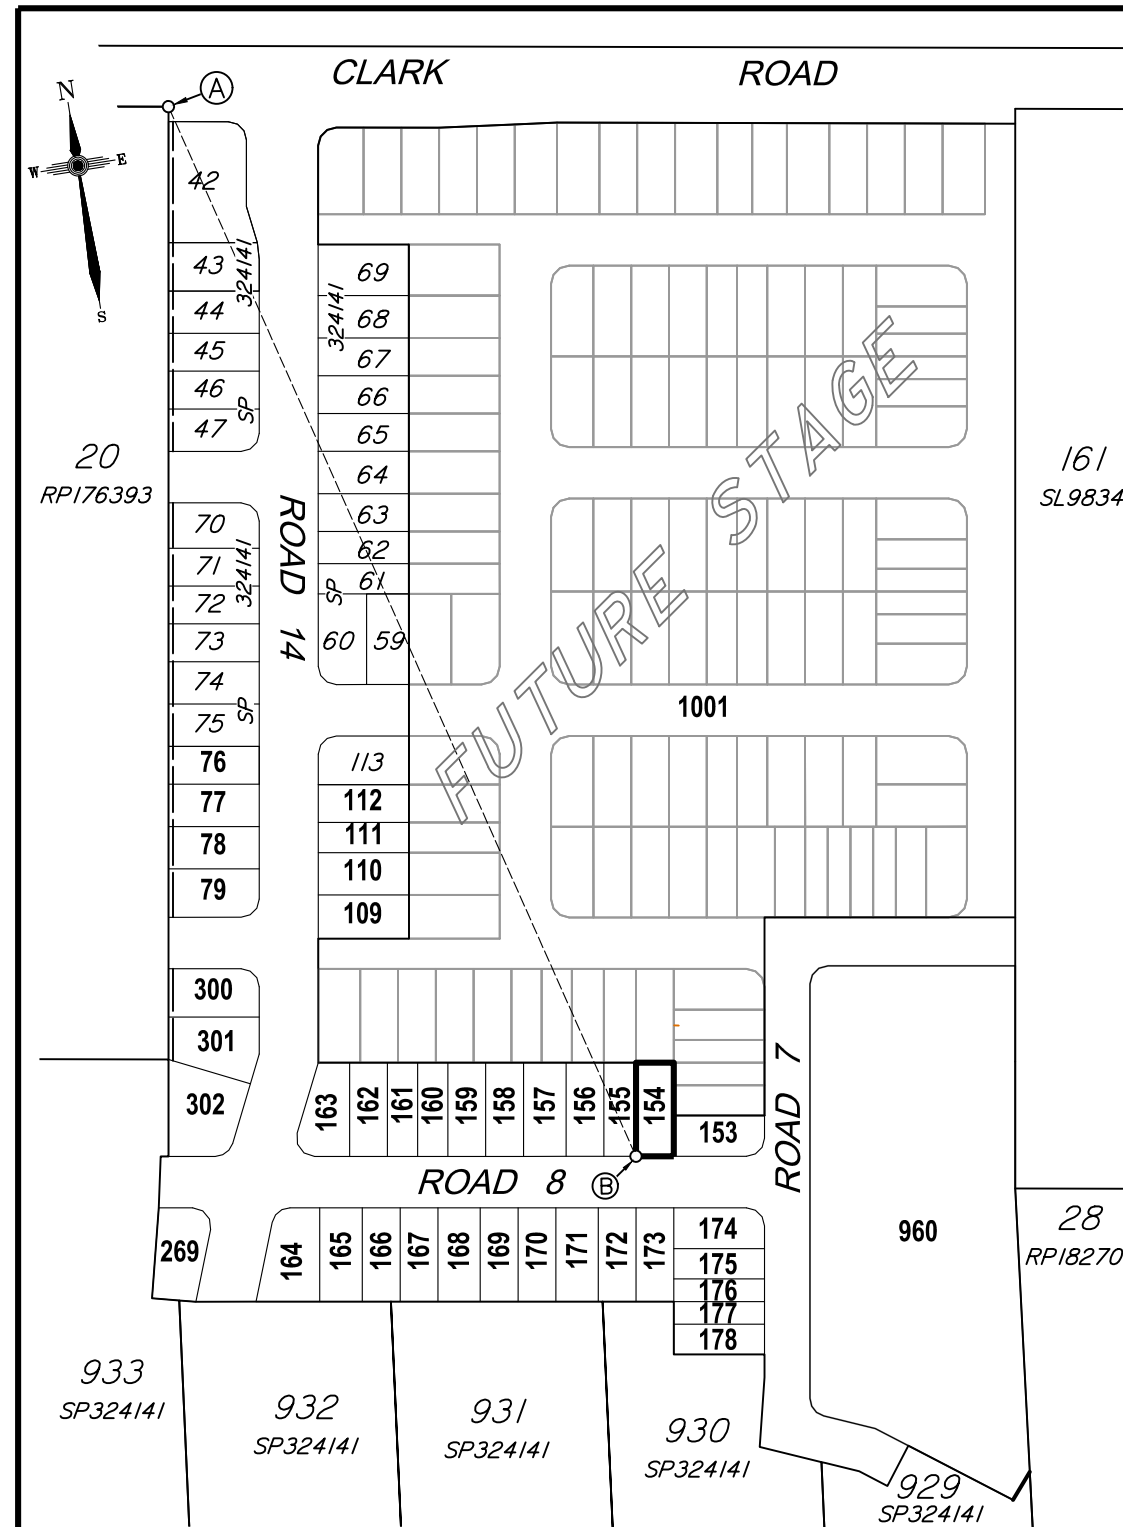

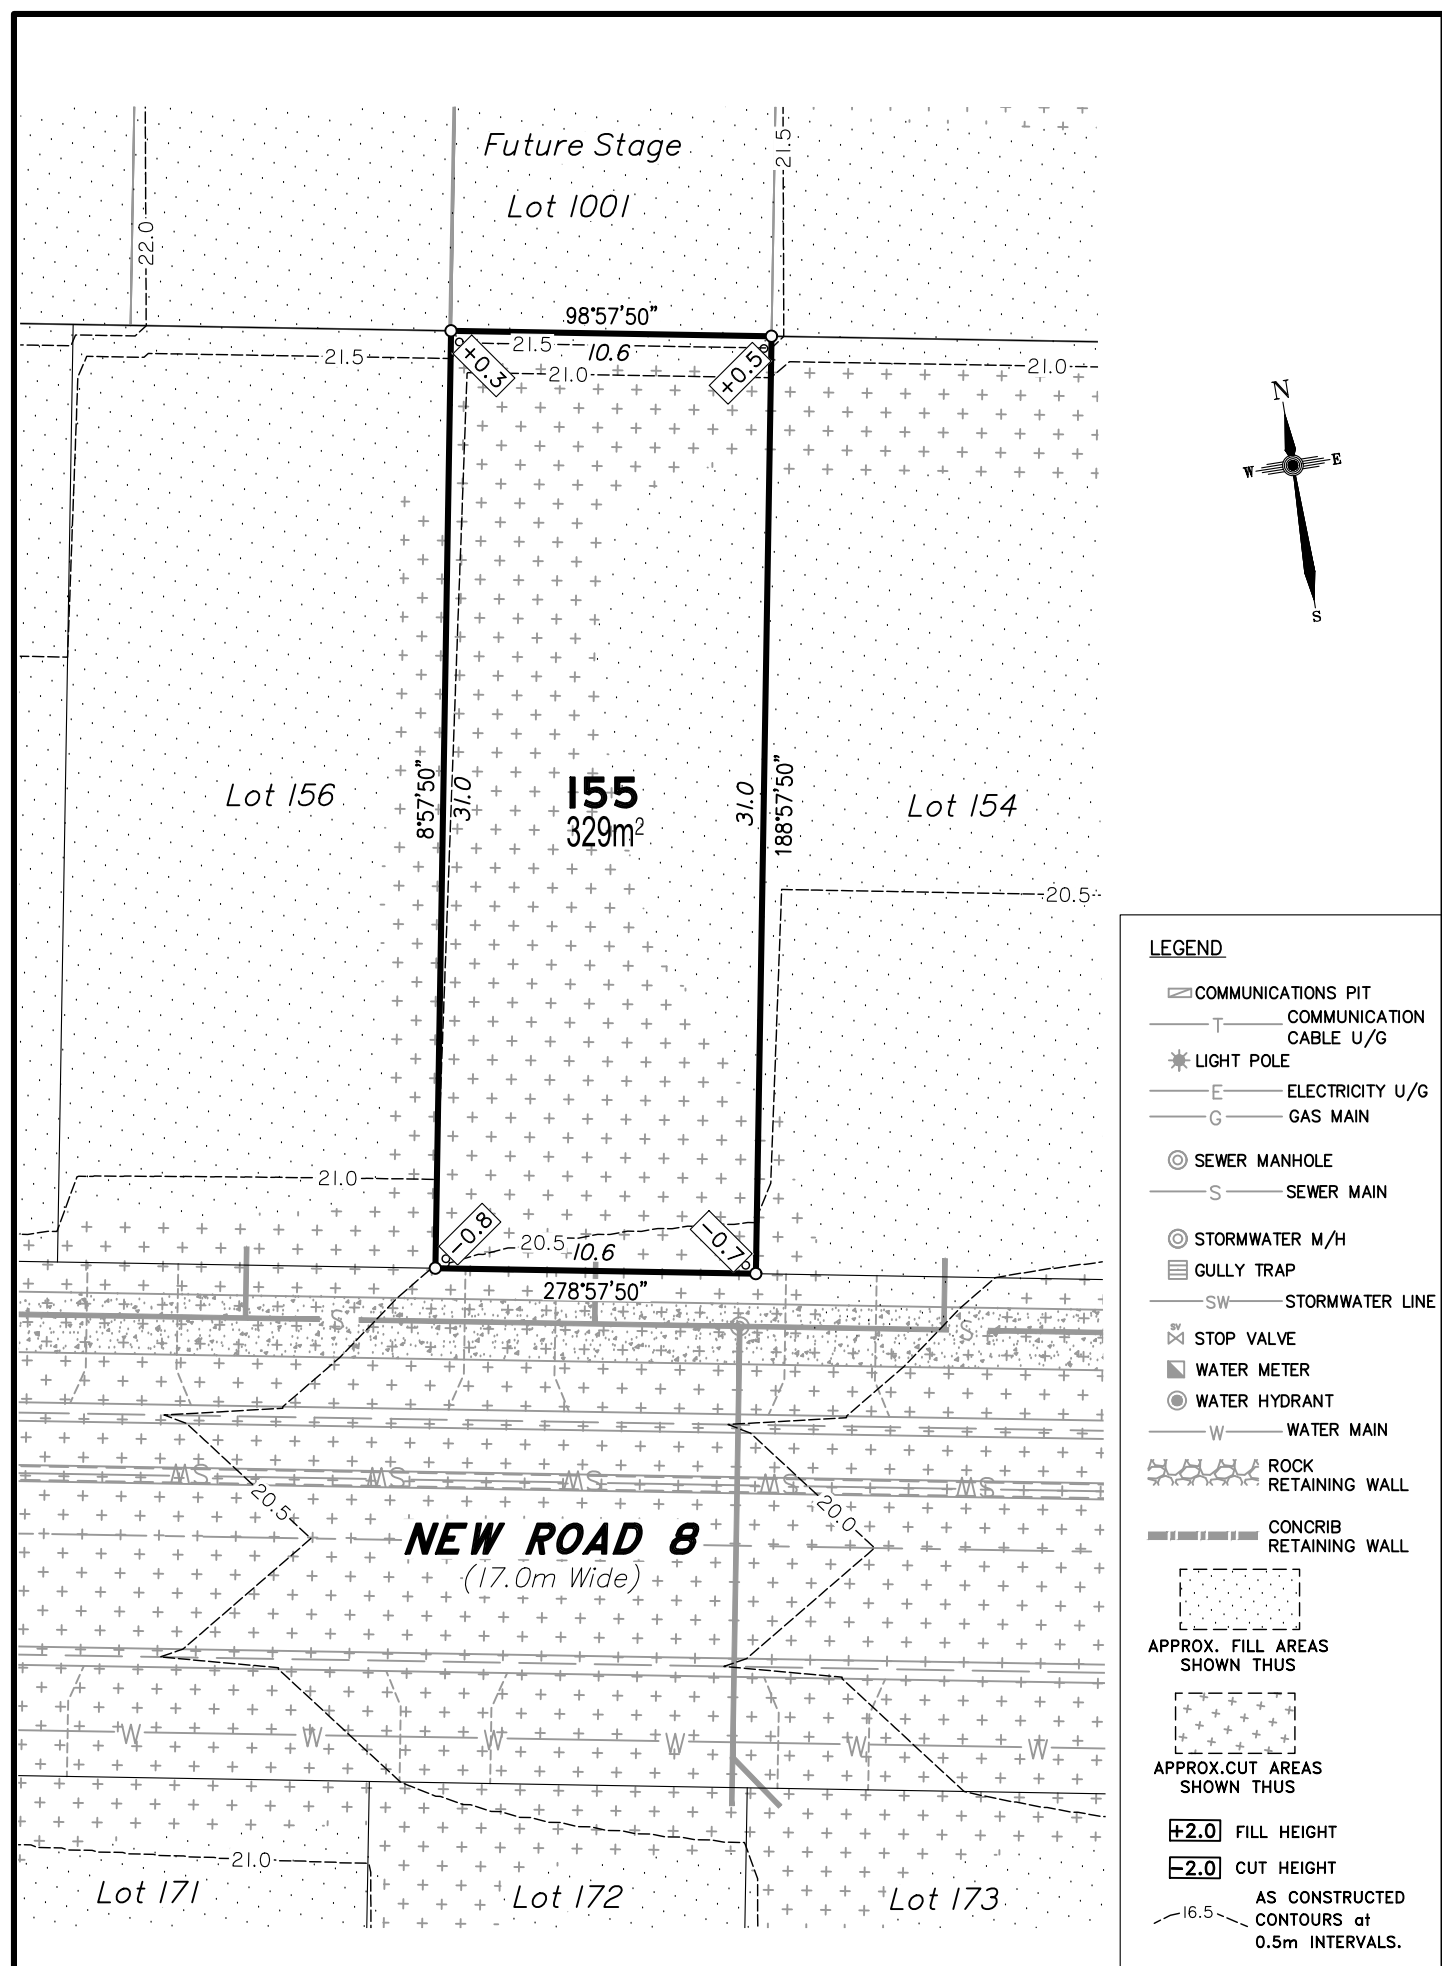


Scale 1:250 - Lengths are in Metres.

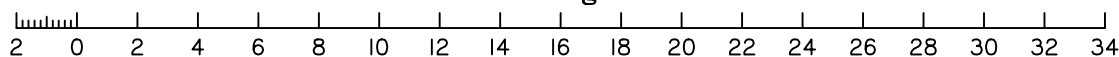


DISCLOSURE PLAN
FOR PROPOSED ALLOTMENT 155
Dated 20th July 2021

This plan shows details of Proposed Allotment 155 on the Proposal Plan 12244-PRO-17 Rev G dated 14/12/2020, which complies with the Development Approval DA/34253/2017/V3RL dated 17th February 2021, approved by Moreton Bay Regional Council, subject to conditions, and associated Judgment by the Planning and Environment Court (1987 of 2018).



The description of the proposed allotment 155, is as part of Lot 1000 on SP324141 (Formally lots 21-24 on RP176393), and situated at Clark Road, Morayfield, commencing at an initial point (A) being the north eastern most point of Lot 20 on RP176393 and thence bounding off on a bearing of 164°57'20" and a distance of 379.934m to point (B) at proposed allotment 155, and containing an area of 329 square metres, more or less.

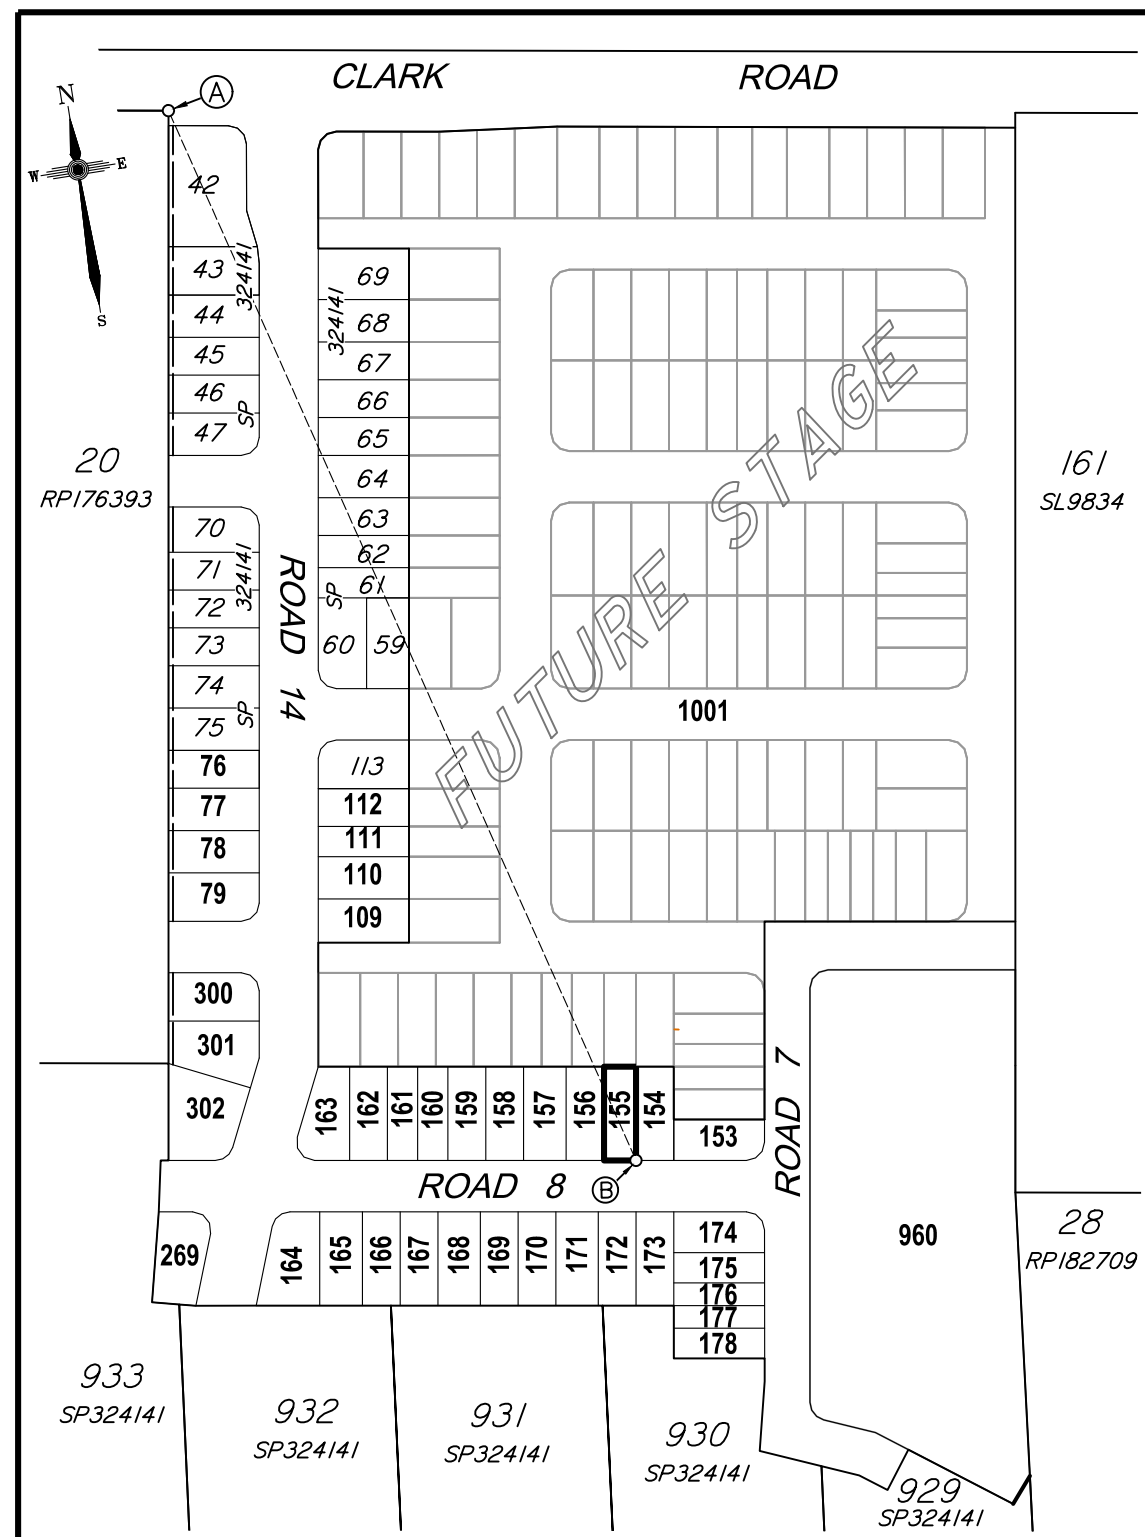

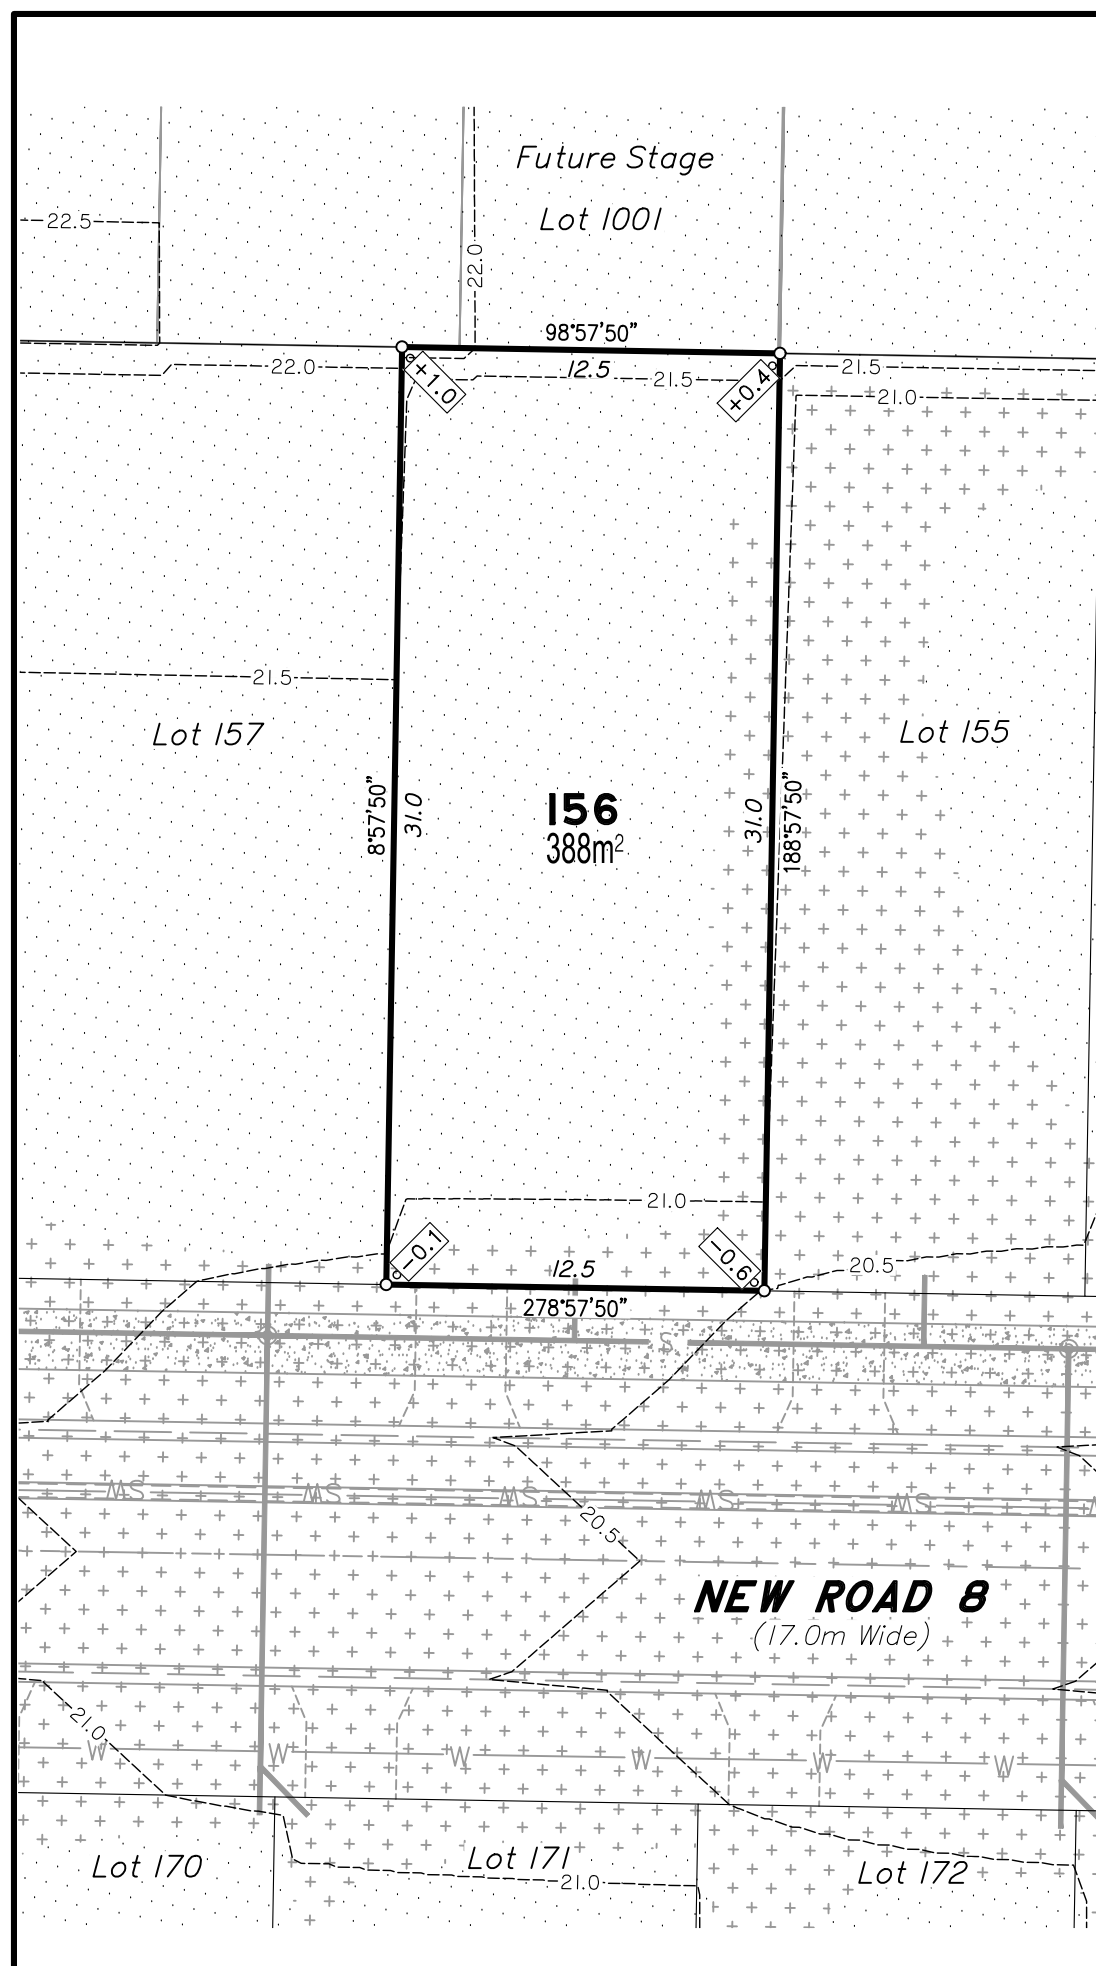

- LEGEND**
- ☐ COMMUNICATIONS PIT
 - T — COMMUNICATION CABLE U/G
 - ★ LIGHT POLE
 - E — ELECTRICITY U/G
 - G — GAS MAIN
 - ⊙ SEWER MANHOLE
 - S — SEWER MAIN
 - ⊙ STORMWATER M/H
 - ☐ GULLY TRAP
 - SW — STORMWATER LINE
 - ✕ STOP VALVE
 - ⊙ WATER METER
 - ⊙ WATER HYDRANT
 - W — WATER MAIN
 - ⚡ ROCK RETAINING WALL
 - ⚡ CONCRIB RETAINING WALL
 - ⚡ APPROX. FILL AREAS SHOWN THUS
 - ⚡ APPROX. CUT AREAS SHOWN THUS
 - +2.0 FILL HEIGHT
 - 2.0 CUT HEIGHT
 - AS CONSTRUCTED CONTOURS at 0.5m INTERVALS.

Scale 1:250 - Lengths are in Metres.

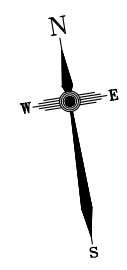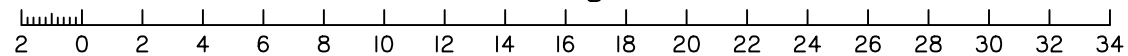


DISCLOSURE PLAN FOR PROPOSED ALLOTMENT 156

Dated 20th July 2021

This plan shows details of Proposed Allotment 156 on the Proposal Plan 12244-PRO-17 Rev G dated 14/12/2020, which complies with the Development Approval DA/34253/2017/V3RL dated 17th February 2021, approved by Moreton Bay Regional Council, subject to conditions, and associated Judgment by the Planning and Environment Court (1987 of 2018).


The description of the proposed allotment 156, is as part of Lot 1000 on SP324141 (Formally lots 21-24 on RP176393), and situated at Clark Road, Morayfield, commencing at an initial point (A) being the north eastern most point of Lot 20 on RP176393 and thence bounding off on a bearing of 168°12'50" and a distance of 371.136m to point (B) at proposed allotment 156, and containing an area of 388 square metres, more or less.

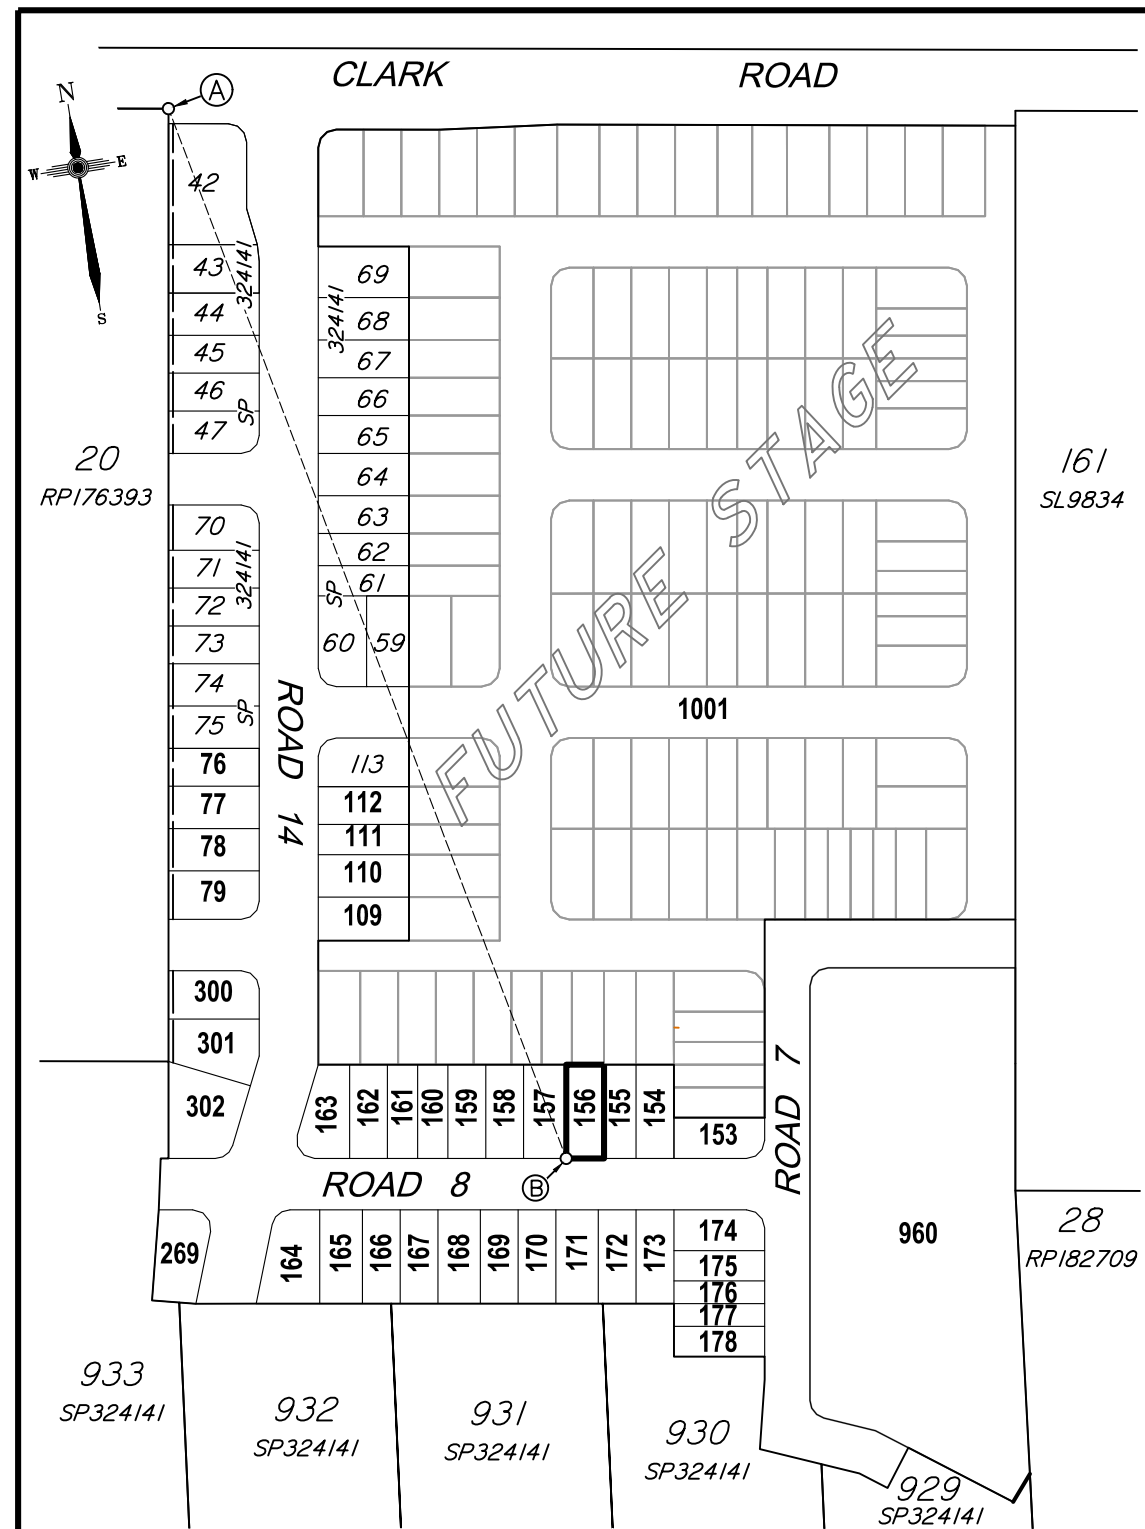

CADASTRAL CONNECTION

A - B 168°12'50" 371.136

Scale 1:2500 - Lengths are in Metres.

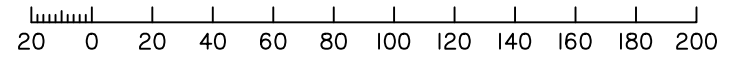

Disclosure Plan

Summerstone Estate,
Morayfield

PROPOSED STAGE 2
ALLOTMENTS 76-79, 109-112, 153-178
& 300-302
Cancelling Lot 1000 on SP324141
(Formally Lots 21-24 on RP176393)
PROPOSED LOT 156

DETAIL SURVEY COMPLETED BY LSD
26/06/2021.
ENGINEERING DESIGN BY GREEN-HAVEN PROJECTS.
ANY FILLING ON THIS LOT IS TO BE COMPLETED TO LEVEL ONE SUPERVISION AND TESTING IN ACCORDANCE WITH THE REQUIREMENTS OF AS 3798-2007 "GUIDELINES ON EARTHWORKS FOR COMMERCIAL AND RESIDENTIAL DEVELOPMENTS".

Revisions	Surveyed	Drawn	Checked	Passed	Date

A ORIGINAL PLAN LSD LA MH LS 20/07/21




PO Box 6334, Maroochydore BC QLD 4558
10/1 Newspaper Place, Maroochydore QLD 4558
Mobile: 0412 666 516
Email: mail@landsurveyingdynamics.com
Web: www.landsurveyingdynamics.com
Land Surveying Dynamics (LSD) Pty Ltd
ACN 154 593 670


Signed
Cadastral Surveyor/Director
Date 20/7/2021

Horiz. Datum MGA20 Z56
Origin GNSS CORS
Vert. Datum AHD
Origin PSM 42642
RL 25.417 AHD
Locality: Morayfield
Local Government: Moreton Bay R.C.

Scale
SHEET 1 OF 1 As shown at A3
COMPUTER FILE 12244-DIS
DRAWING NUMBER
12116-DIS-156
REV. A

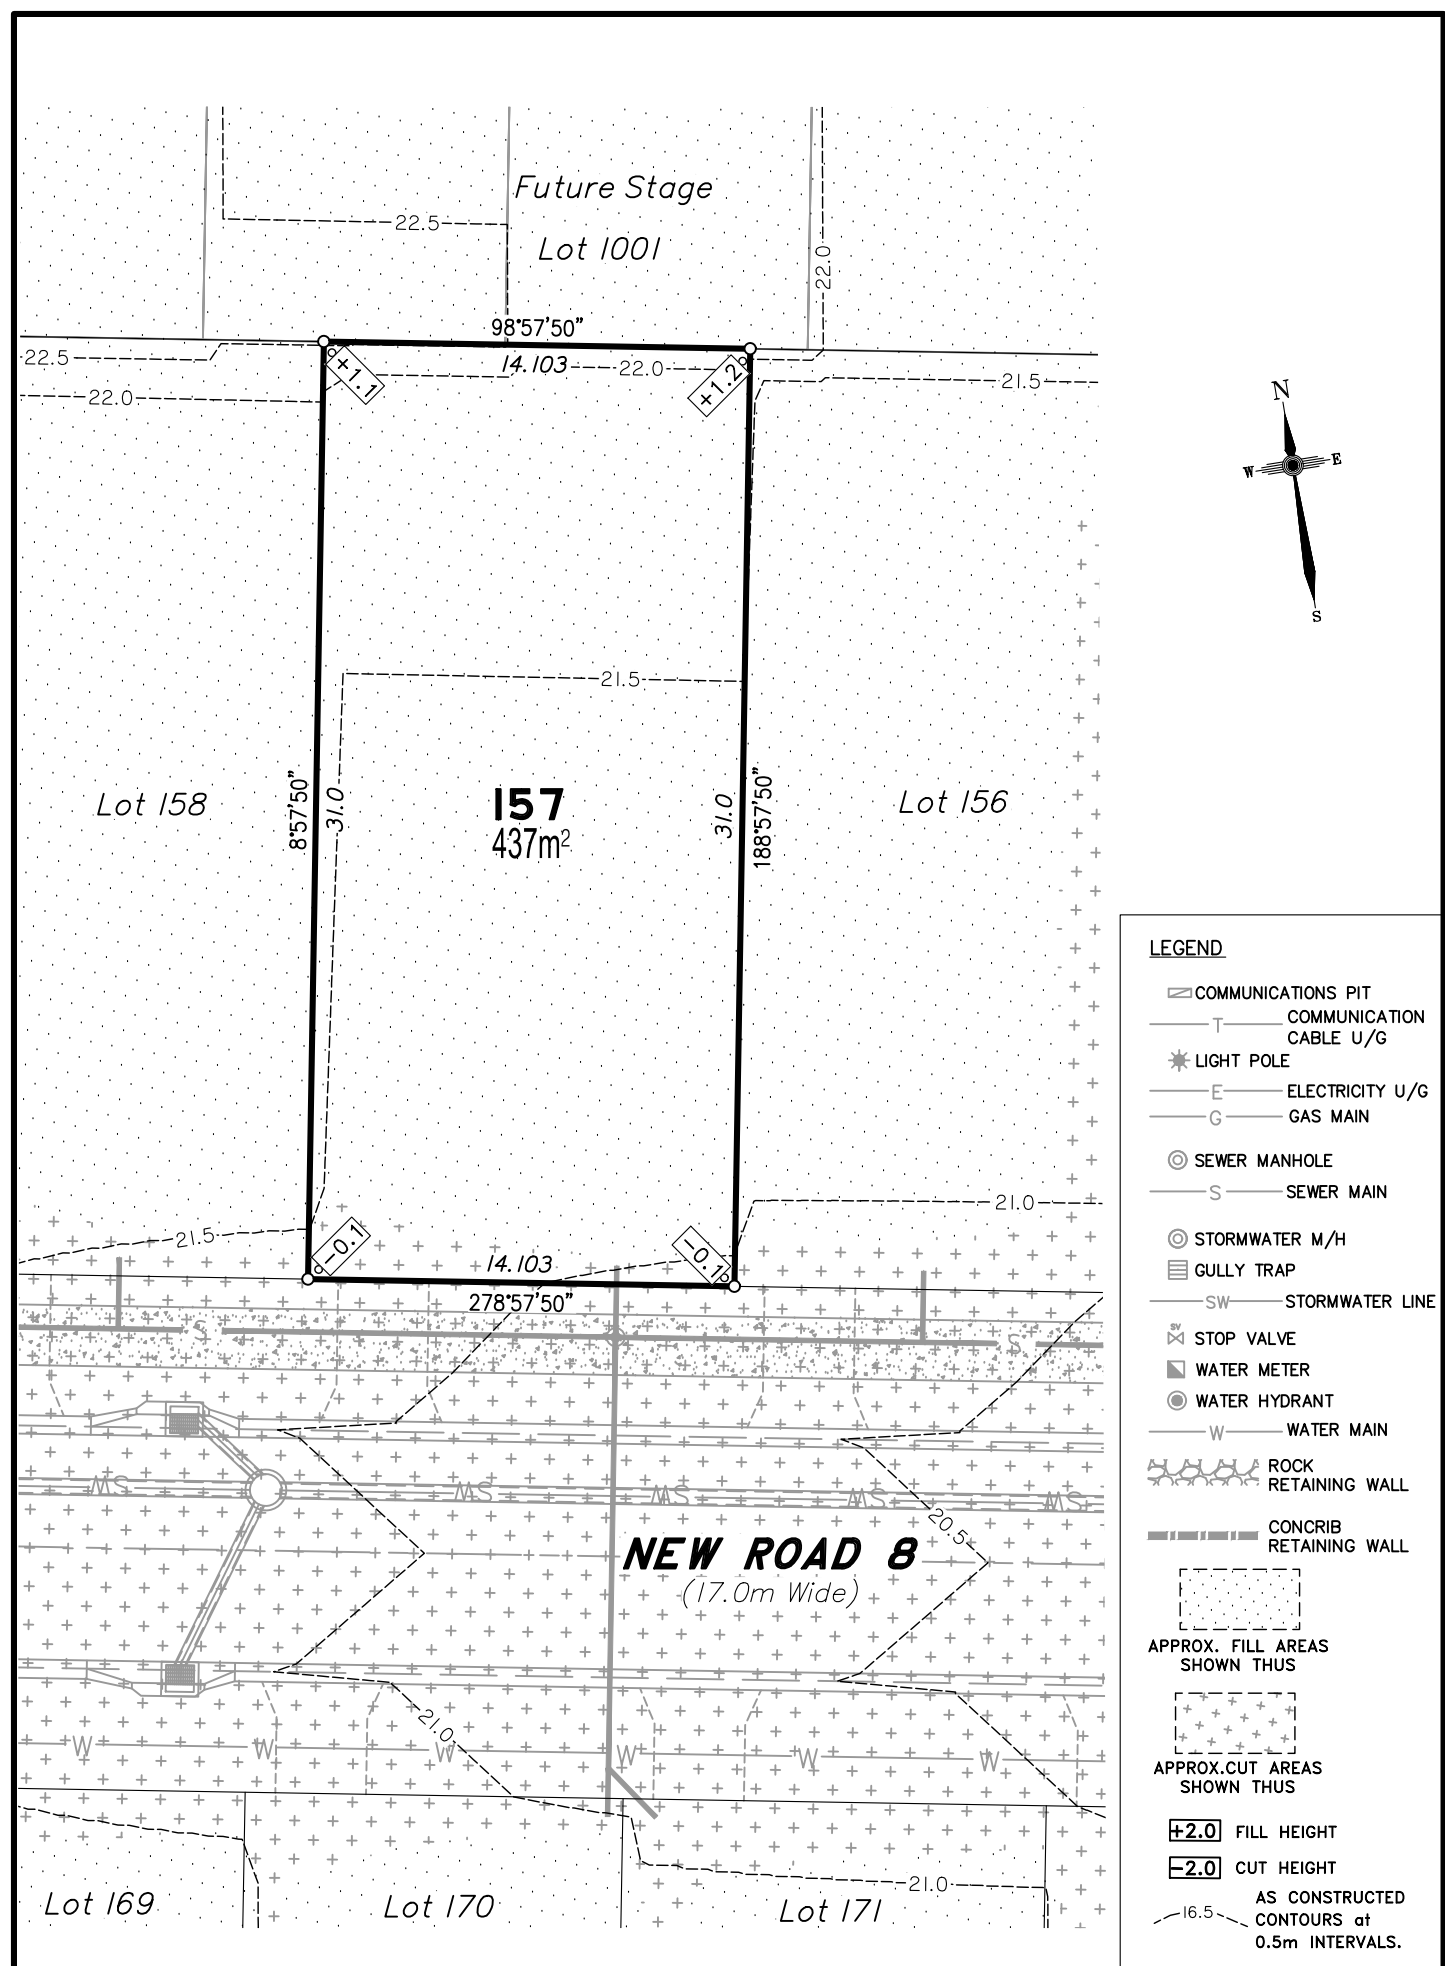


Scale 1:250 - Lengths are in Metres.

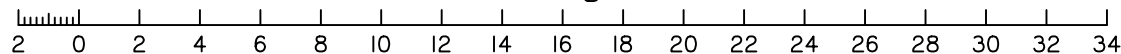


DISCLOSURE PLAN
FOR PROPOSED ALLOTMENT 157
Dated 20th July 2021

This plan shows details of Proposed Allotment 157 on the Proposal Plan 12244-PRO-17 Rev G dated 14/12/2020, which complies with the Development Approval DA/34253/2017/V3RL dated 17th February 2021, approved by Moreton Bay Regional Council, subject to conditions, and associated Judgment by the Planning and Environment Court (1987 of 2018).

The description of the proposed allotment 157, is as part of Lot 1000 on SP324141 (Formally lots 21-24 on RP176393), and situated at Clark Road, Morayfield, commencing at an initial point (A) being the north eastern most point of Lot 20 on RP176393 and thence bounding off on a bearing of 168°12'50" and a distance of 371.136m to point (B) at proposed allotment 157, and containing an area of 437 square metres, more or less.

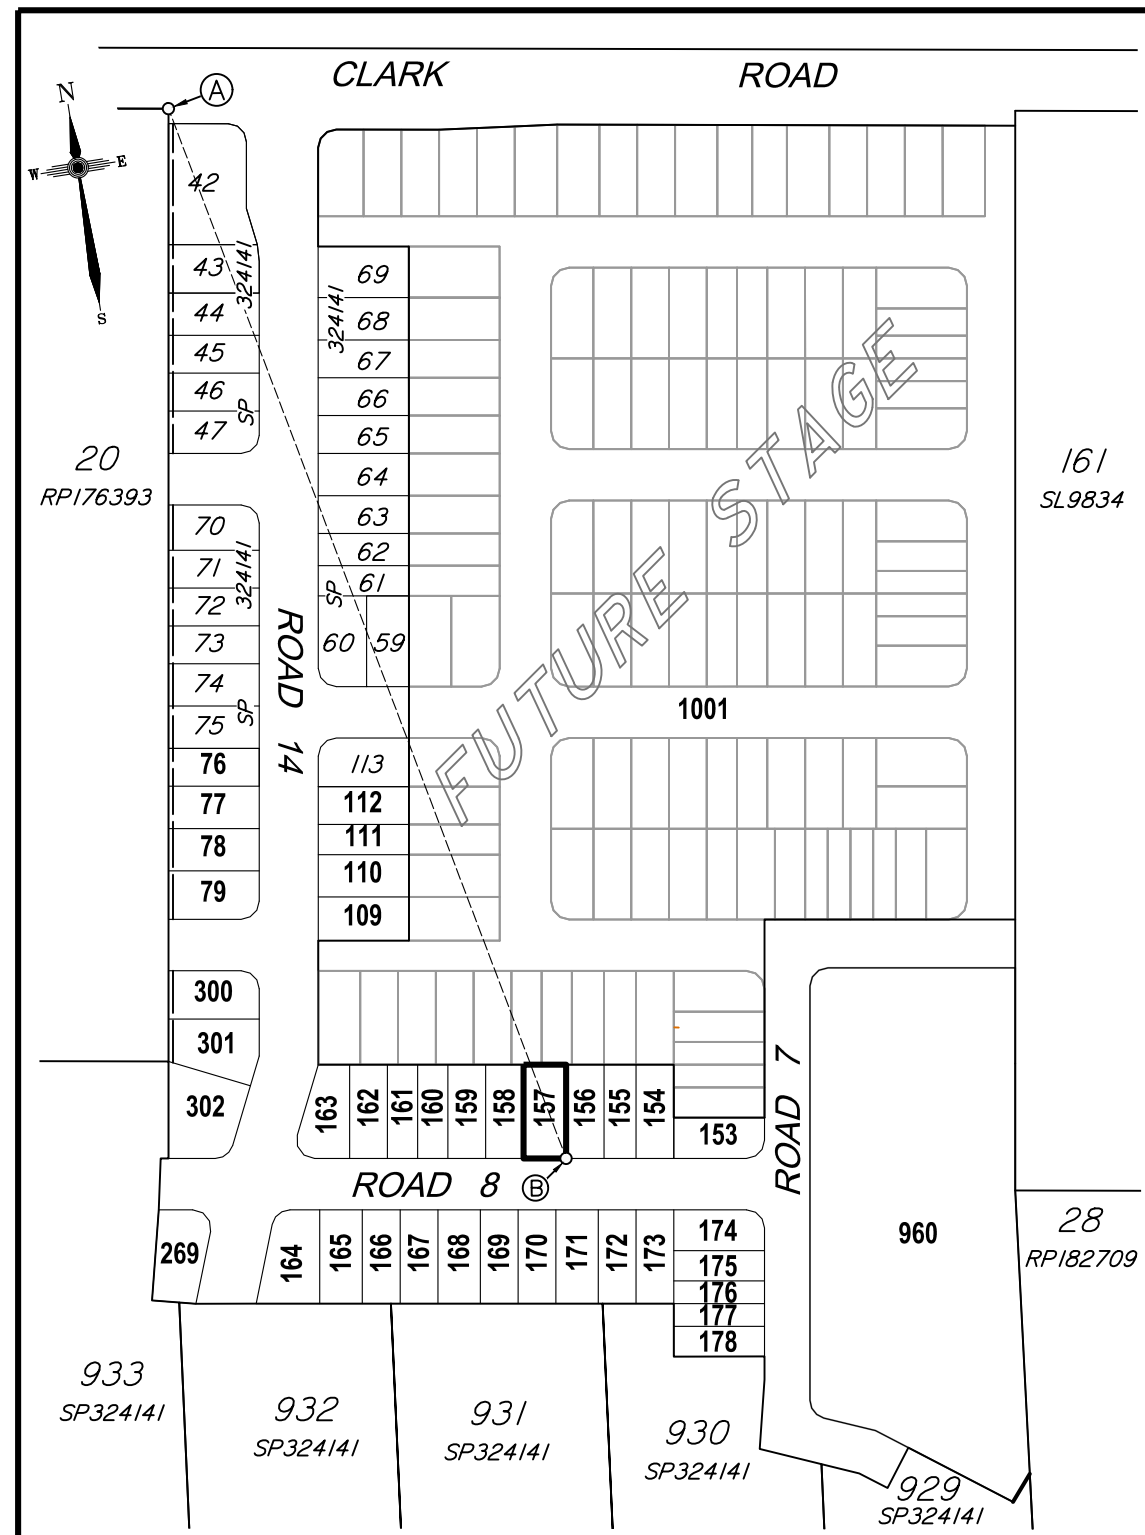


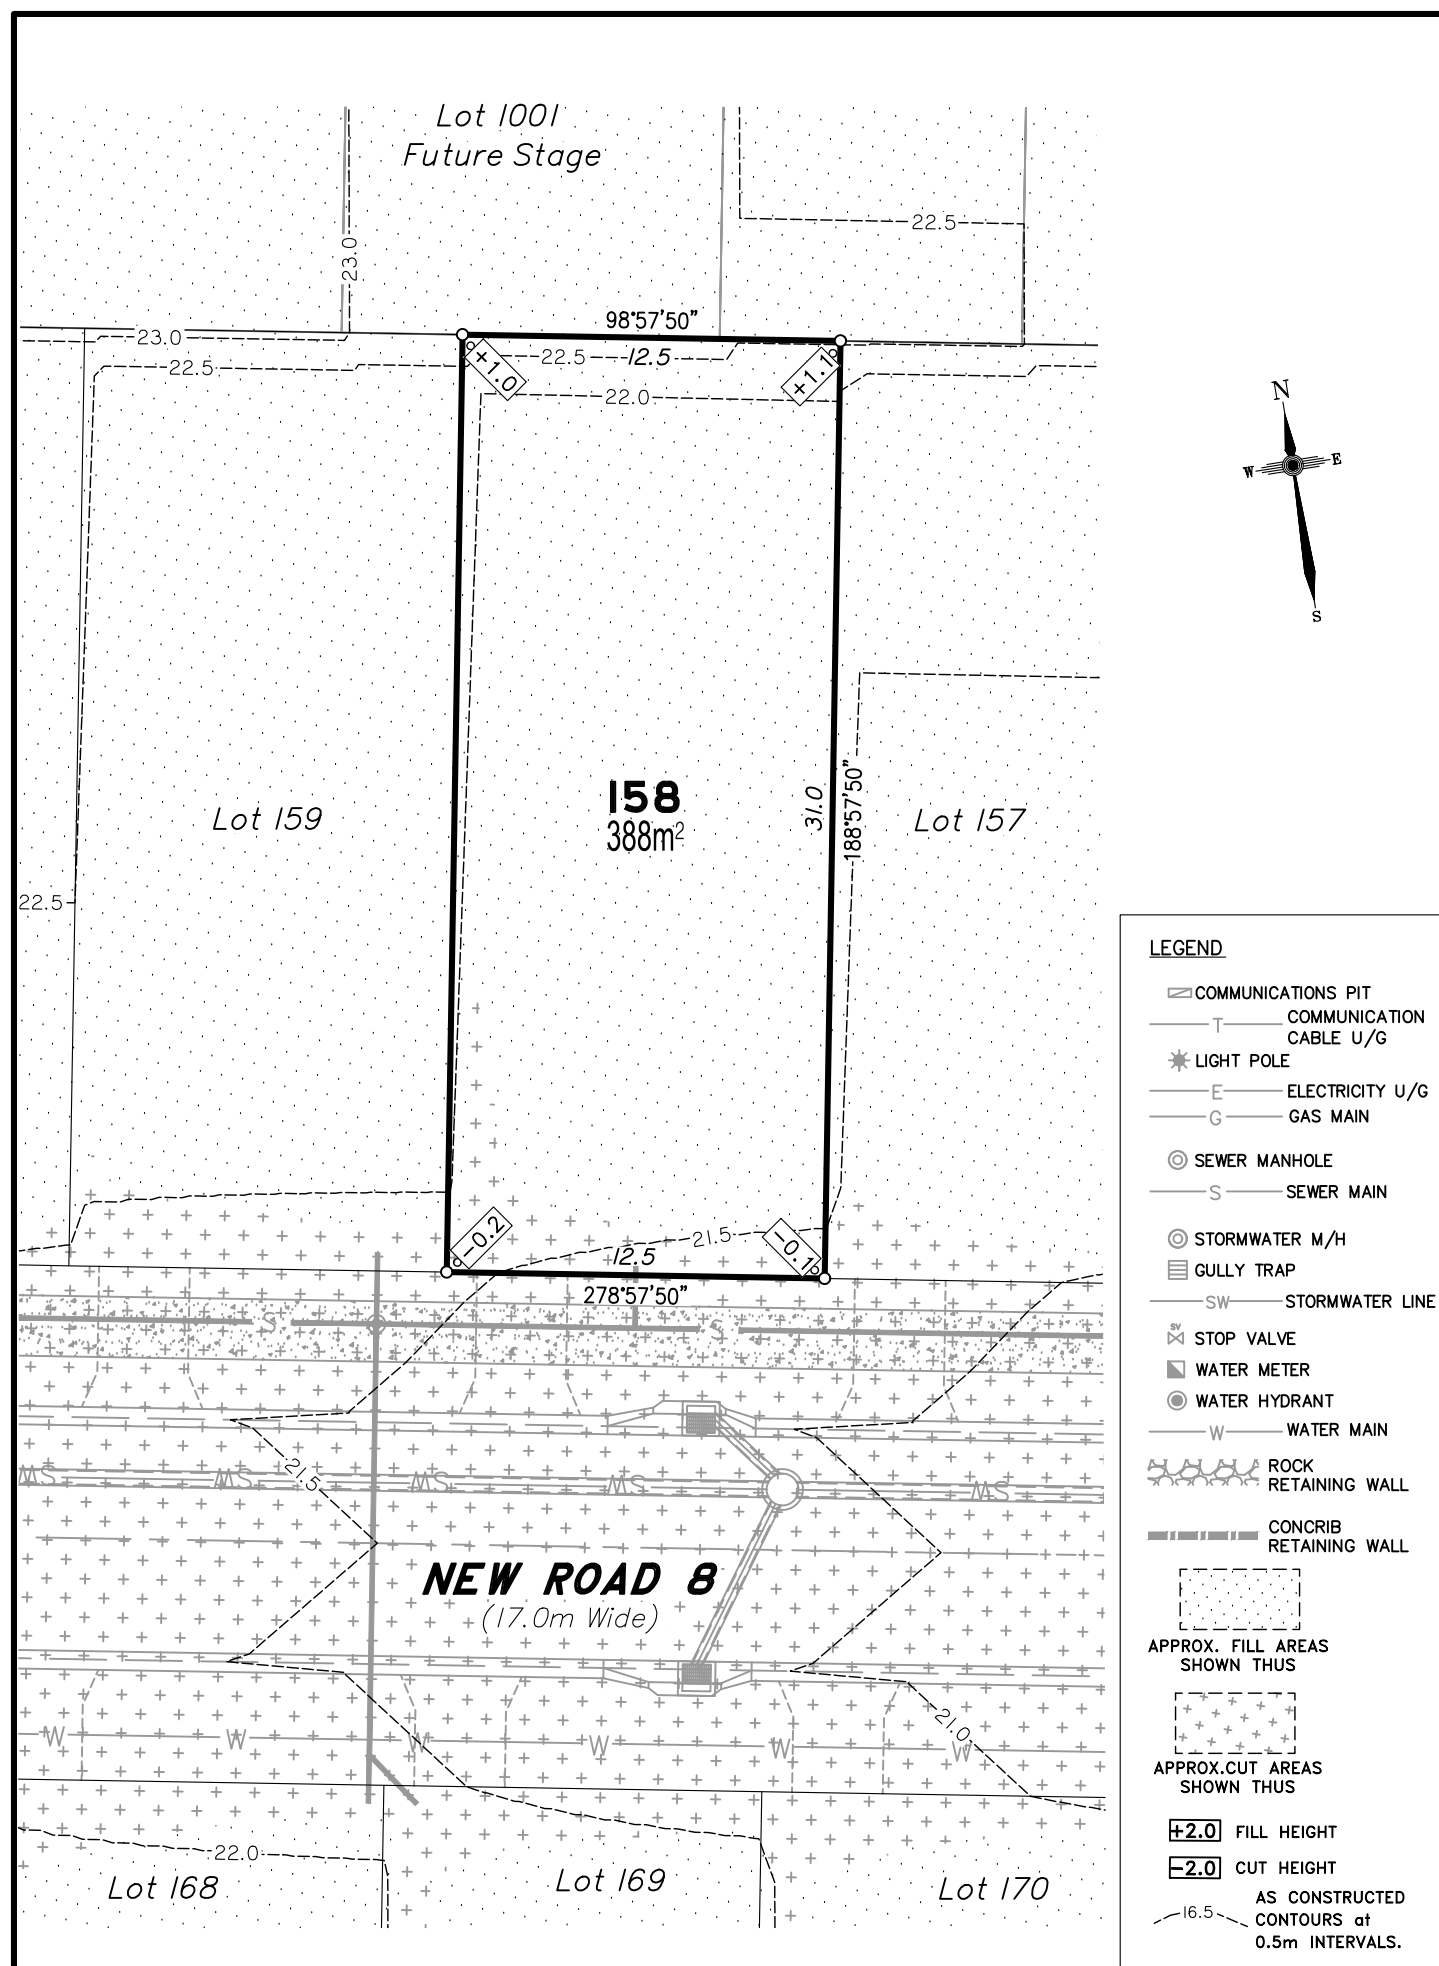


DISCLOSURE PLAN
FOR PROPOSED ALLOTMENT 158
Dated 20th July 2021

This plan shows details of Proposed Allotment 158 on the Proposal Plan 12244-PRO-17 Rev G dated 14/12/2020, which complies with the Development Approval DA/34253/2017/V3RL dated 17th February 2021, approved by Moreton Bay Regional Council, subject to conditions, and associated Judgment by the Planning and Environment Court (1987 of 2018).

The description of the proposed allotment 158, is as part of Lot 1000 on SP324141 (Formally lots 21-24 on RP176393), and situated at Clark Road, Morayfield, commencing at an initial point (A) being the north eastern most point of Lot 20 on RP176393 and thence bounding off on a bearing of 172°08'55" and a distance of 362.565m to point (B) at proposed allotment 158, and containing an area of 388 square metres, more or less.

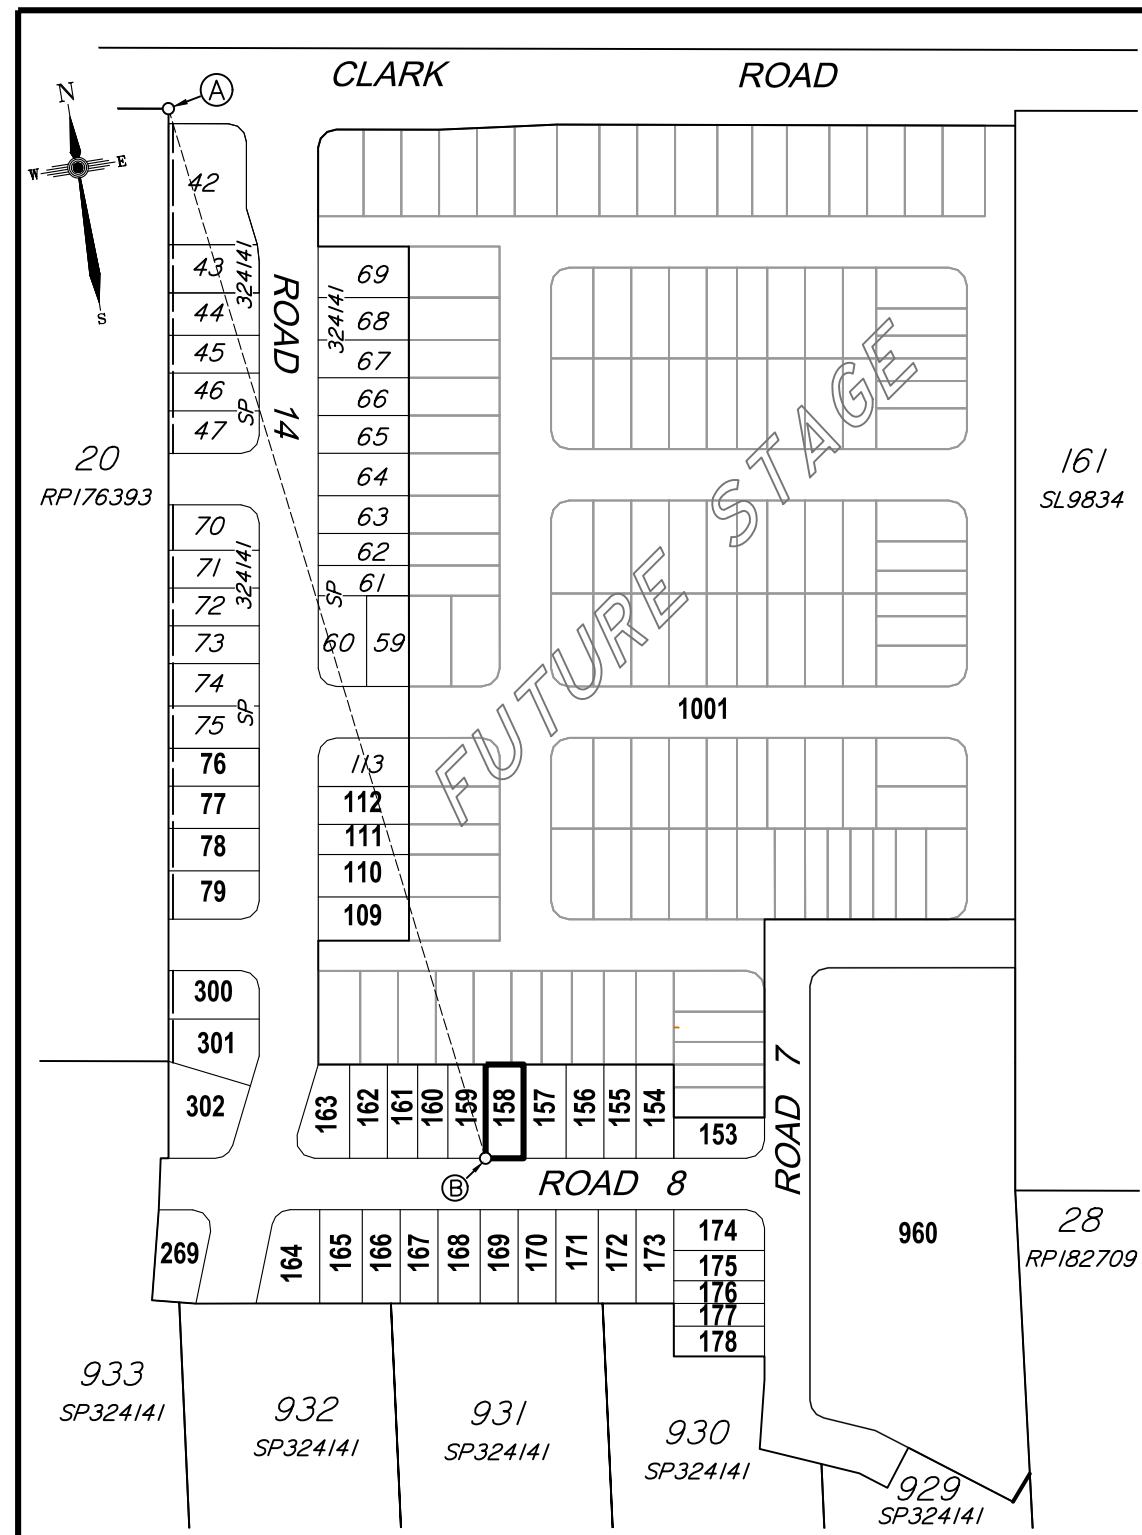

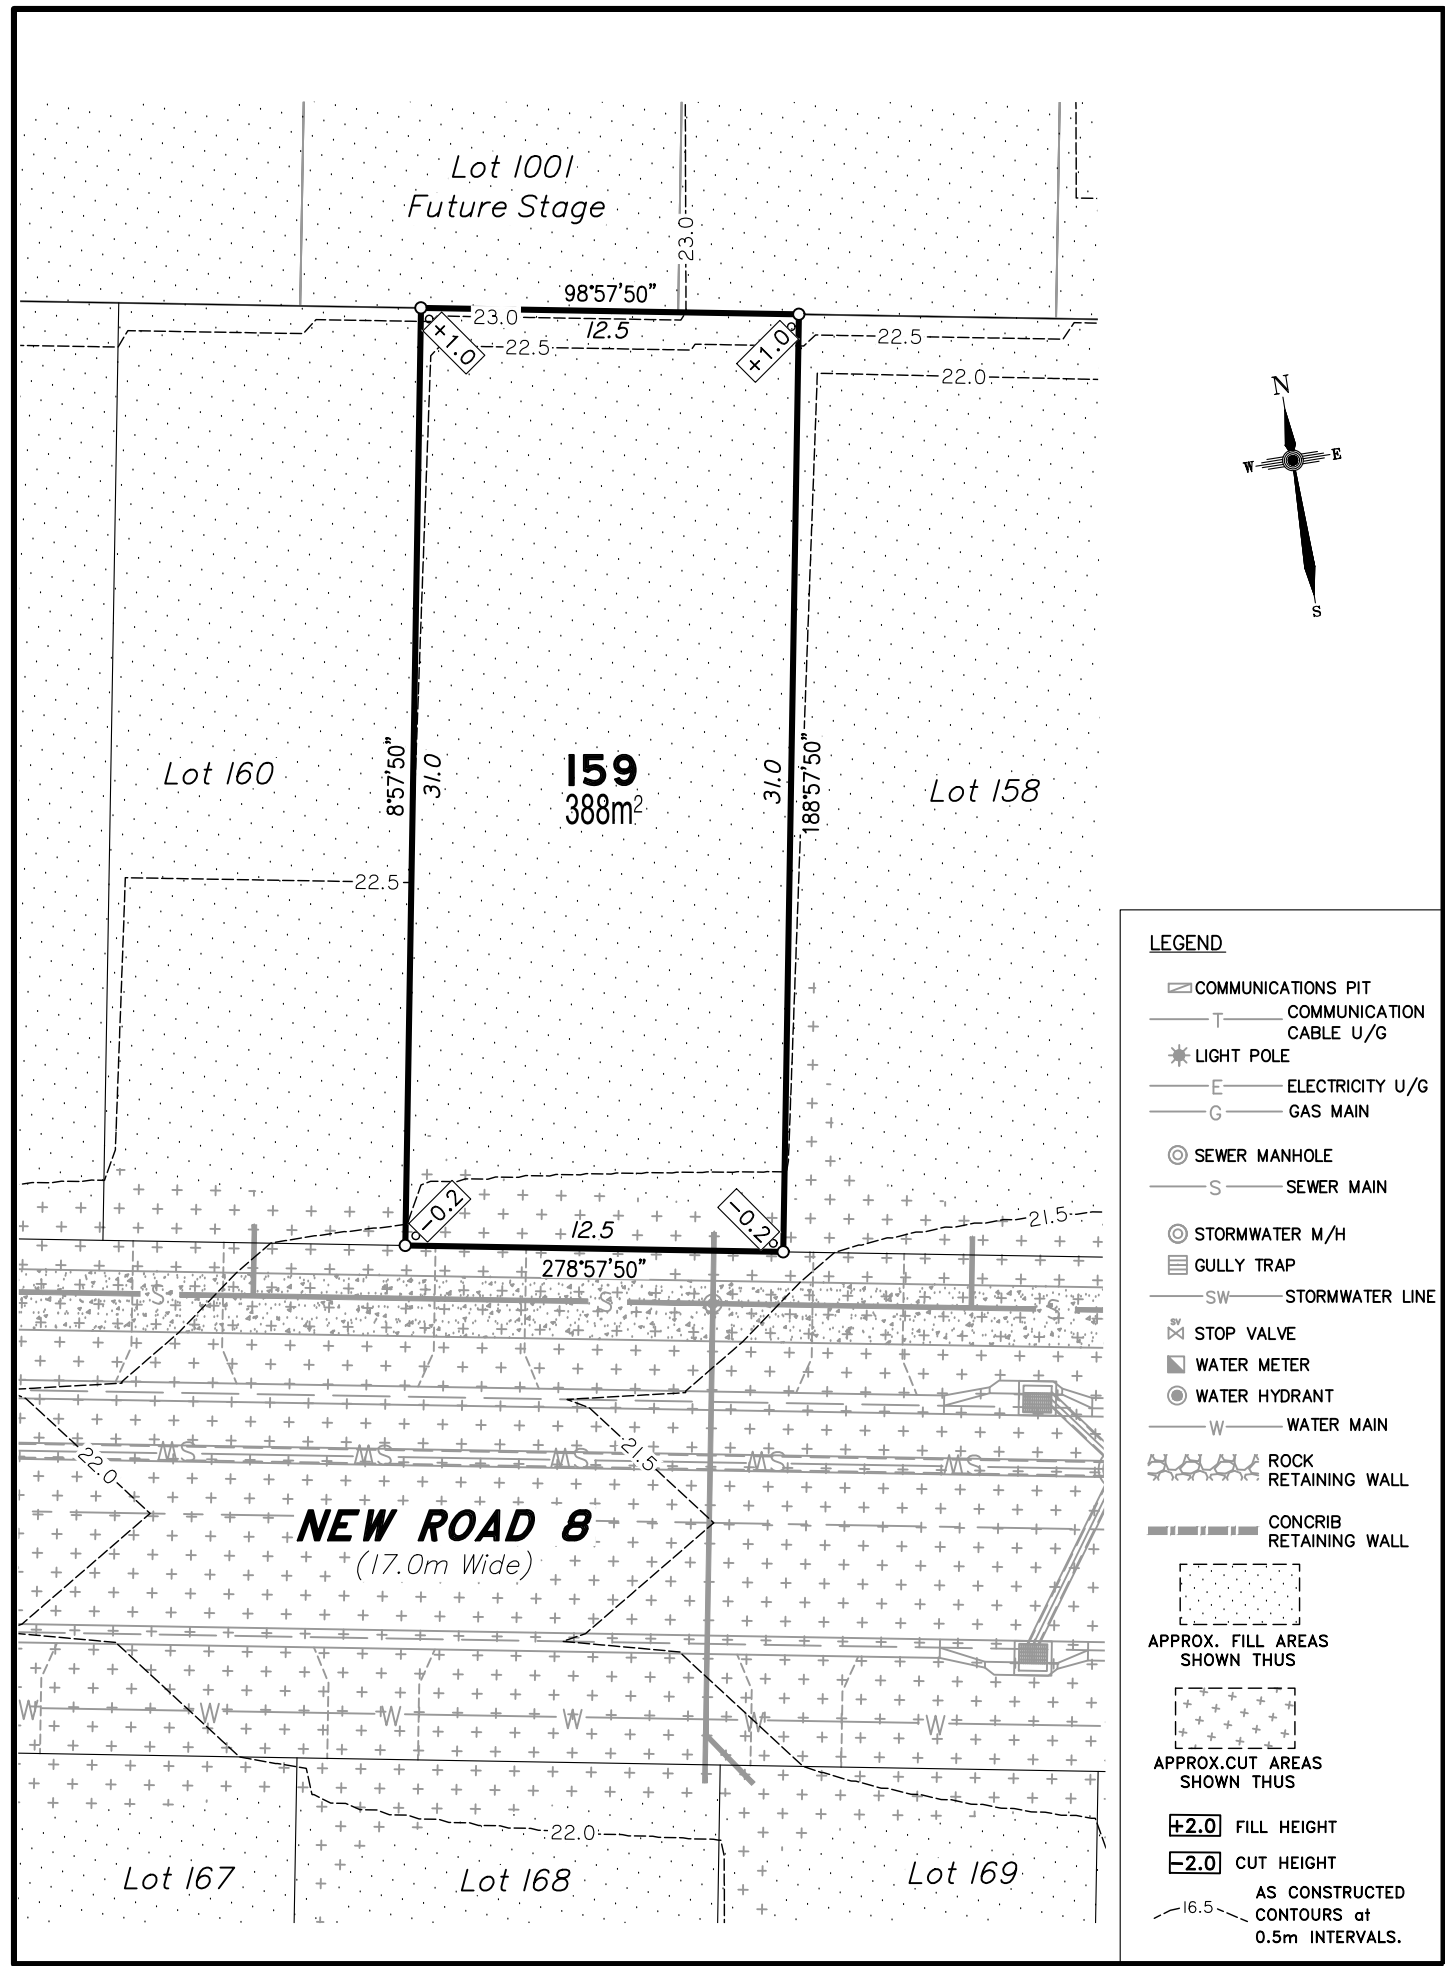


DISCLOSURE PLAN FOR PROPOSED ALLOTMENT 159

Dated 20th July 2021

This plan shows details of Proposed Allotment 159 on the Proposal Plan 12244-PRO-17 Rev G dated 14/12/2020, which complies with the Development Approval DA/34253/2017/V3RL dated 17th February 2021, approved by Moreton Bay Regional Council, subject to conditions, and associated Judgment by the Planning and Environment Court (1987 of 2018).

The description of the proposed allotment 159, is as part of Lot 1000 on SP324141 (Formally lots 21-24 on RP176393), and situated at Clark Road, Morayfield, commencing at an initial point (A) being the north eastern most point of Lot 20 on RP176393 and thence bounding off on a bearing of 172°08'55" and a distance of 362.565m to point (B) at proposed allotment 159, and containing an area of 388 square metres, more or less.

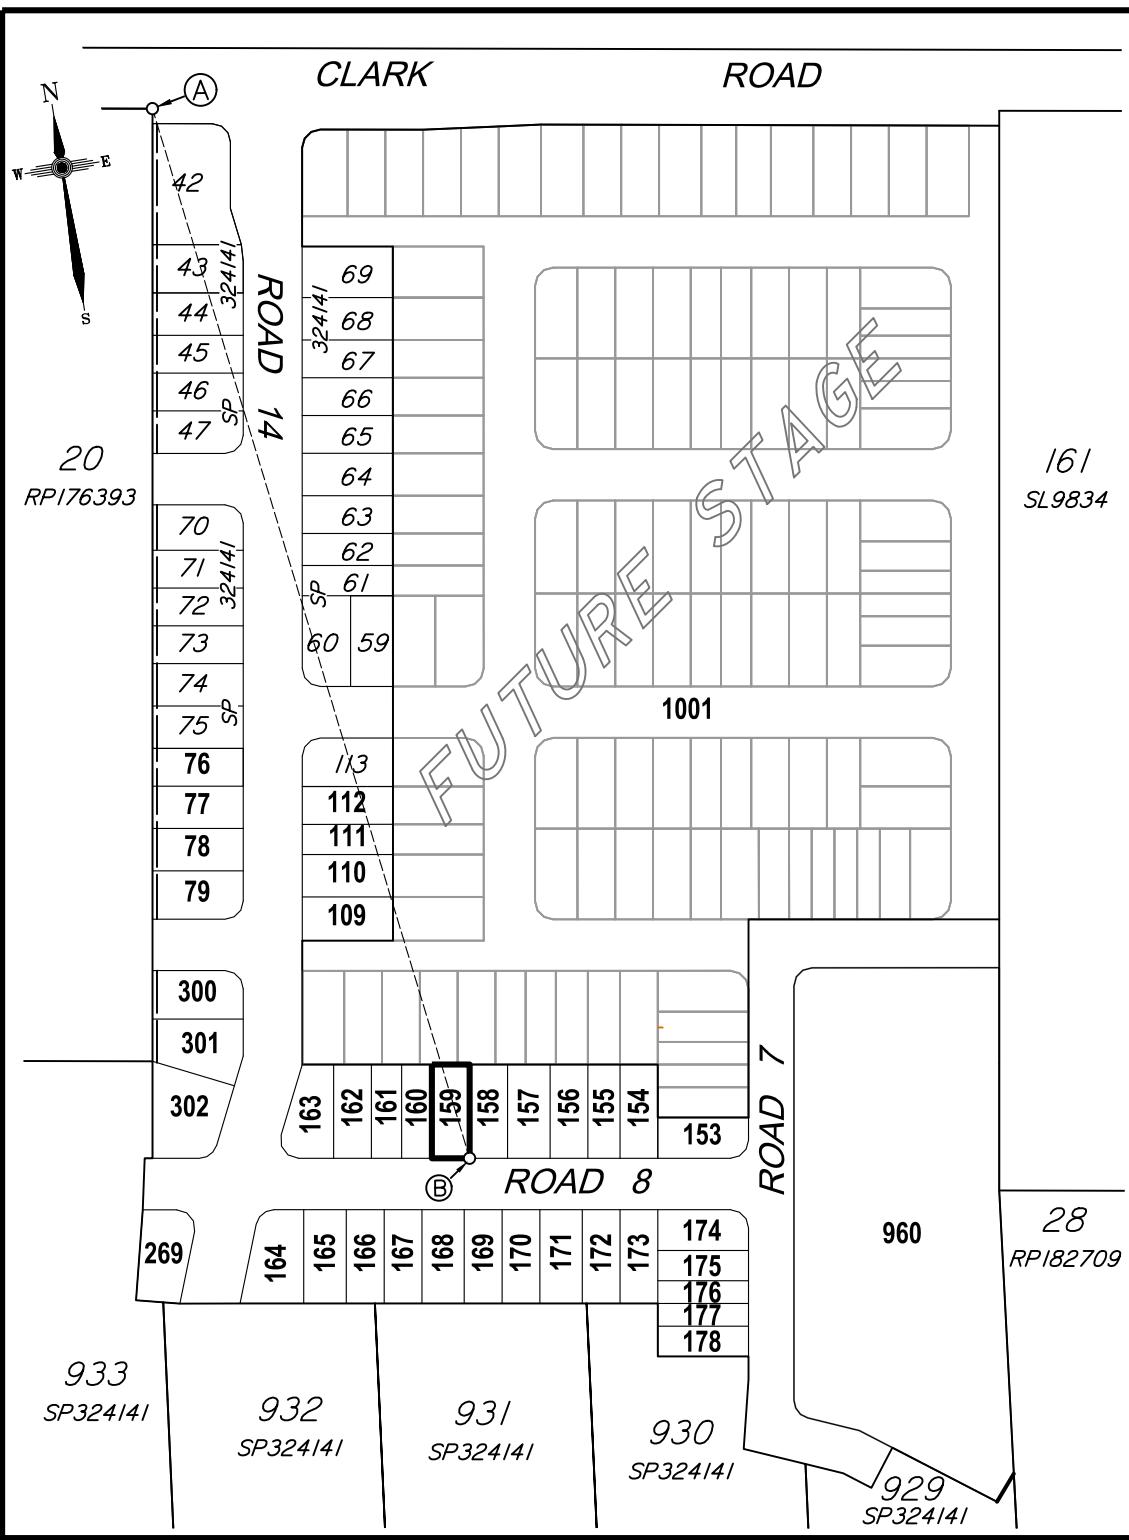

Disclosure Plan

**Summerstone Estate,
Morayfield**

PROPOSED STAGE 2
ALLOTMENTS 76-79, 109-112, 153-178
& 300-302

Cancelling Lot 1000 on SP324141
(Formally Lots 21-24 on RP176393)

PROPOSED LOT 159

DETAIL SURVEY COMPLETED BY LSD 26/06/2021.
ENGINEERING DESIGN BY GREEN-HAVEN PROJECTS.
ANY FILLING ON THIS LOT IS TO BE COMPLETED TO LEVEL ONE SUPERVISION AND TESTING IN ACCORDANCE WITH THE REQUIREMENTS OF AS 3798-2007 "GUIDELINES ON EARTHWORKS FOR COMMERCIAL AND RESIDENTIAL DEVELOPMENTS".

Revisions	Surveyed	Drawn	Checked	Passed	Date
A ORIGINAL PLAN	LSD	LA	MH	LS	20/07/21

PO Box 6334, Maroochydore BC QLD 4558
10/1 Newspaper Place, Maroochydore QLD 4558
Mobile: 0412 666 516
Email: mail@landsurveyingdynamics.com
Web: www.landsurveyingdynamics.com
Land Surveying Dynamics (LSD) Pty Ltd
ACN 154 593 670

Signed
Cadastral Surveyor/Director
Date 20/7/2021

Horiz. Datum MGA20 Z56
Origin GNSS CORS

Vert. Datum AHD
Origin PSM 42642
RL 25.417 AHD


Locality: Morayfield
Local Government: Moreton Bay R.C.

SHEET 1 OF 1
COMPUTER FILE 12244-DIS
DRAWING NUMBER
12116-DIS-159

Scale As shown at A3
REV. A

CADASTRAL CONNECTION
A - B 172°08'55" 362.565


Scale 1:2500 - Lengths are in Metres.

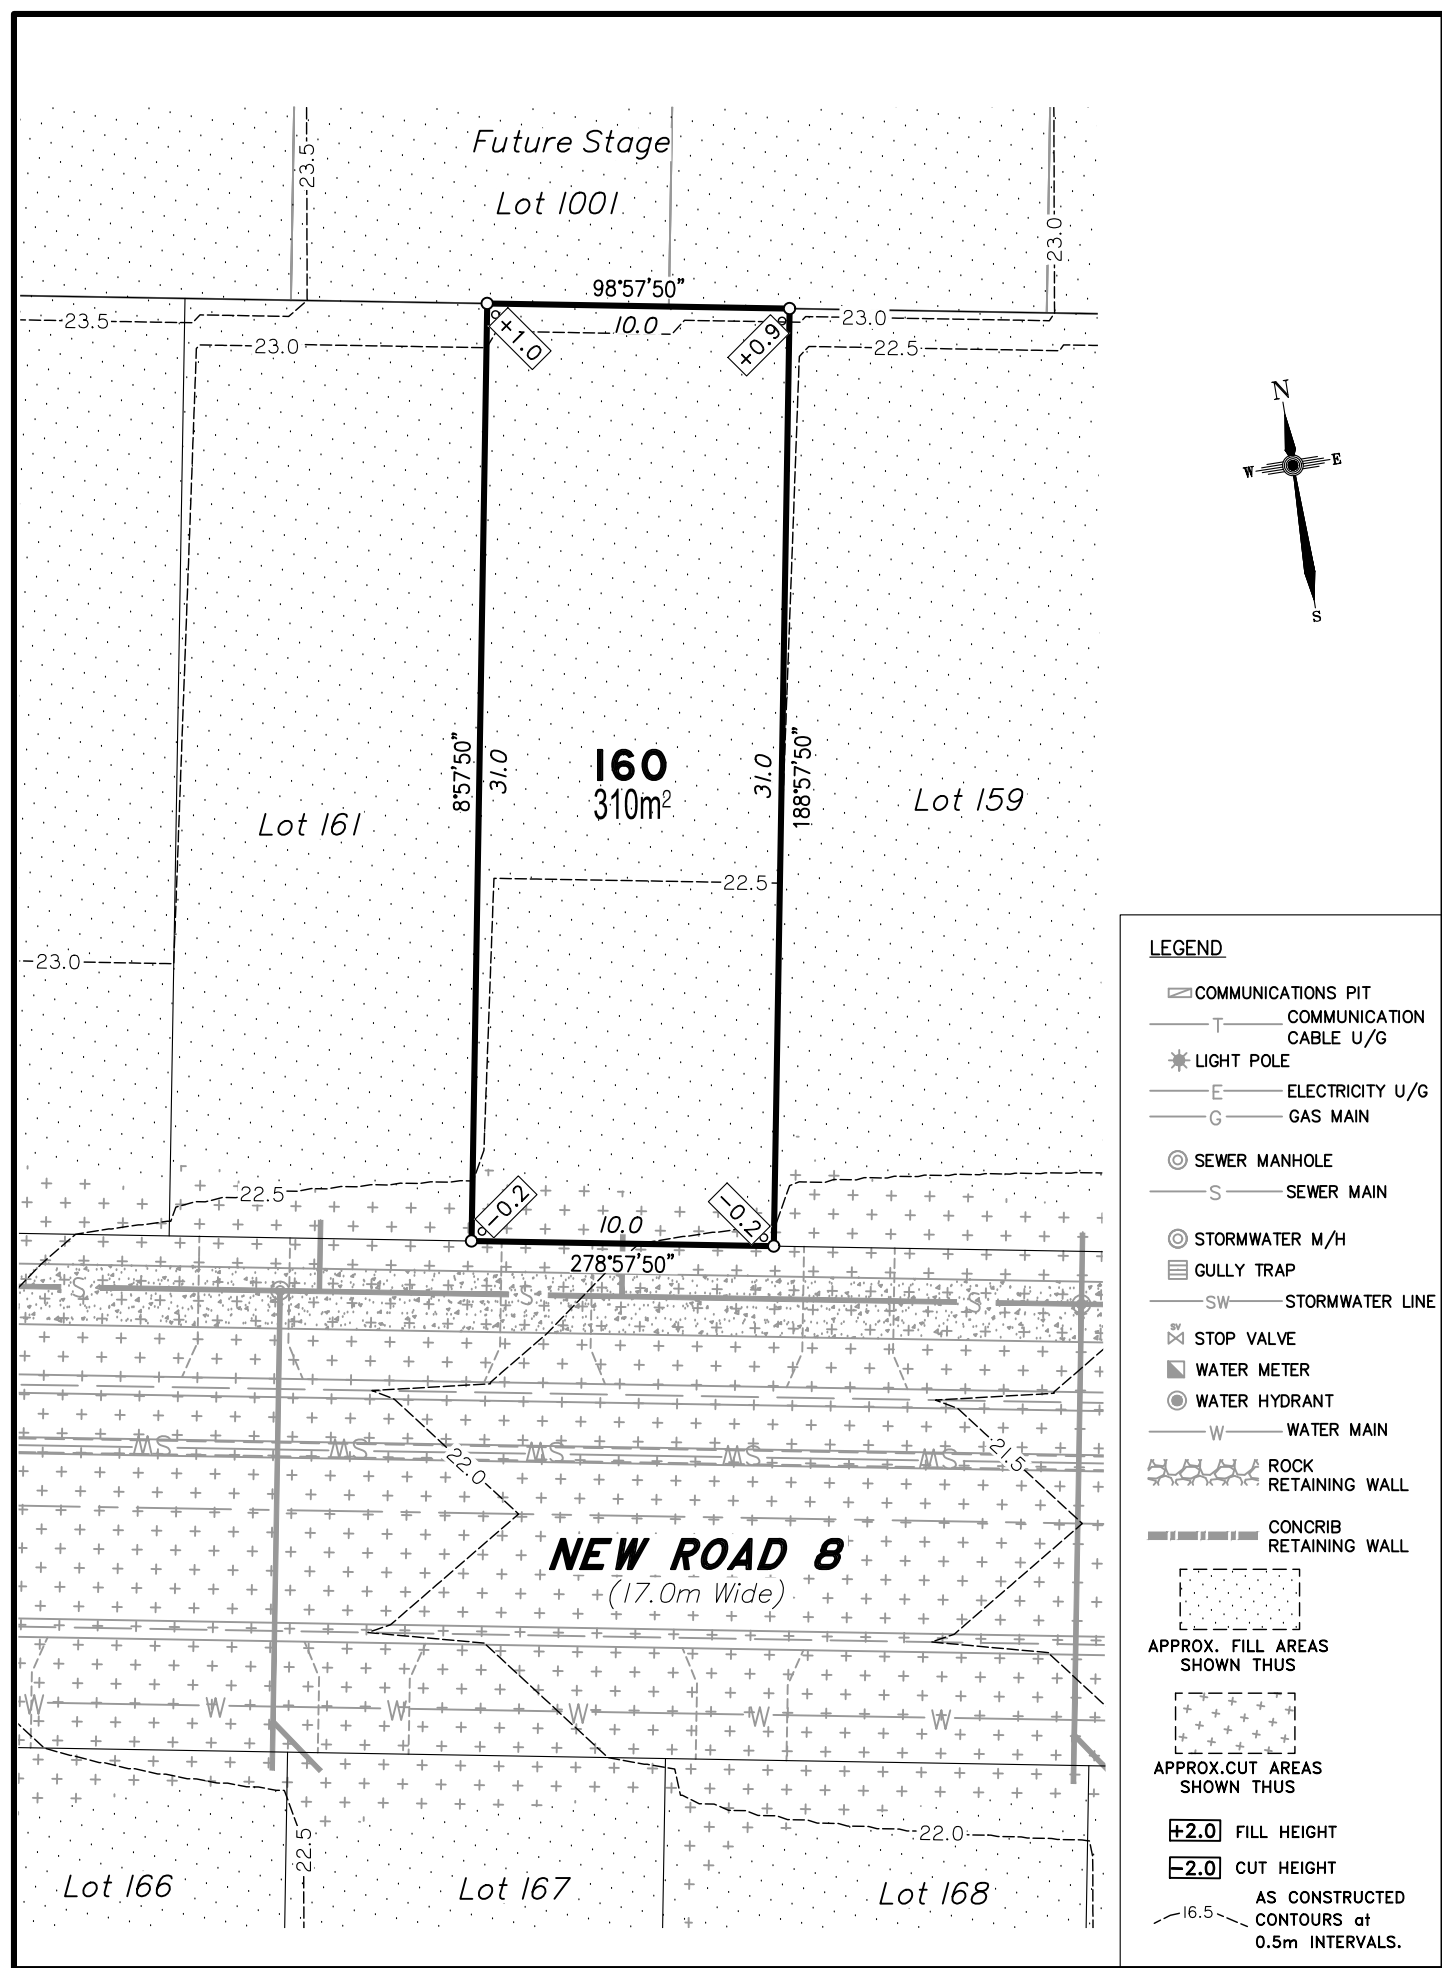


DISCLOSURE PLAN
FOR PROPOSED ALLOTMENT 160
Dated 20th July 2021

This plan shows details of Proposed Allotment 160 on the Proposal Plan 12244-PRO-17 Rev G dated 14/12/2020, which complies with the Development Approval DA/34253/2017/V3RL dated 17th February 2021, approved by Moreton Bay Regional Council, subject to conditions, and associated Judgment by the Planning and Environment Court (1987 of 2018).

The description of the proposed allotment 160, is as part of Lot 1000 on SP324141 (Formally lots 21-24 on RP176393), and situated at Clark Road, Morayfield, commencing at an initial point (A) being the north eastern most point of Lot 20 on RP176393 and thence bounding off on a bearing of 175°36'40" and a distance of 356.707m to point (B) at proposed allotment 160, and containing an area of 310 square metres, more or less.

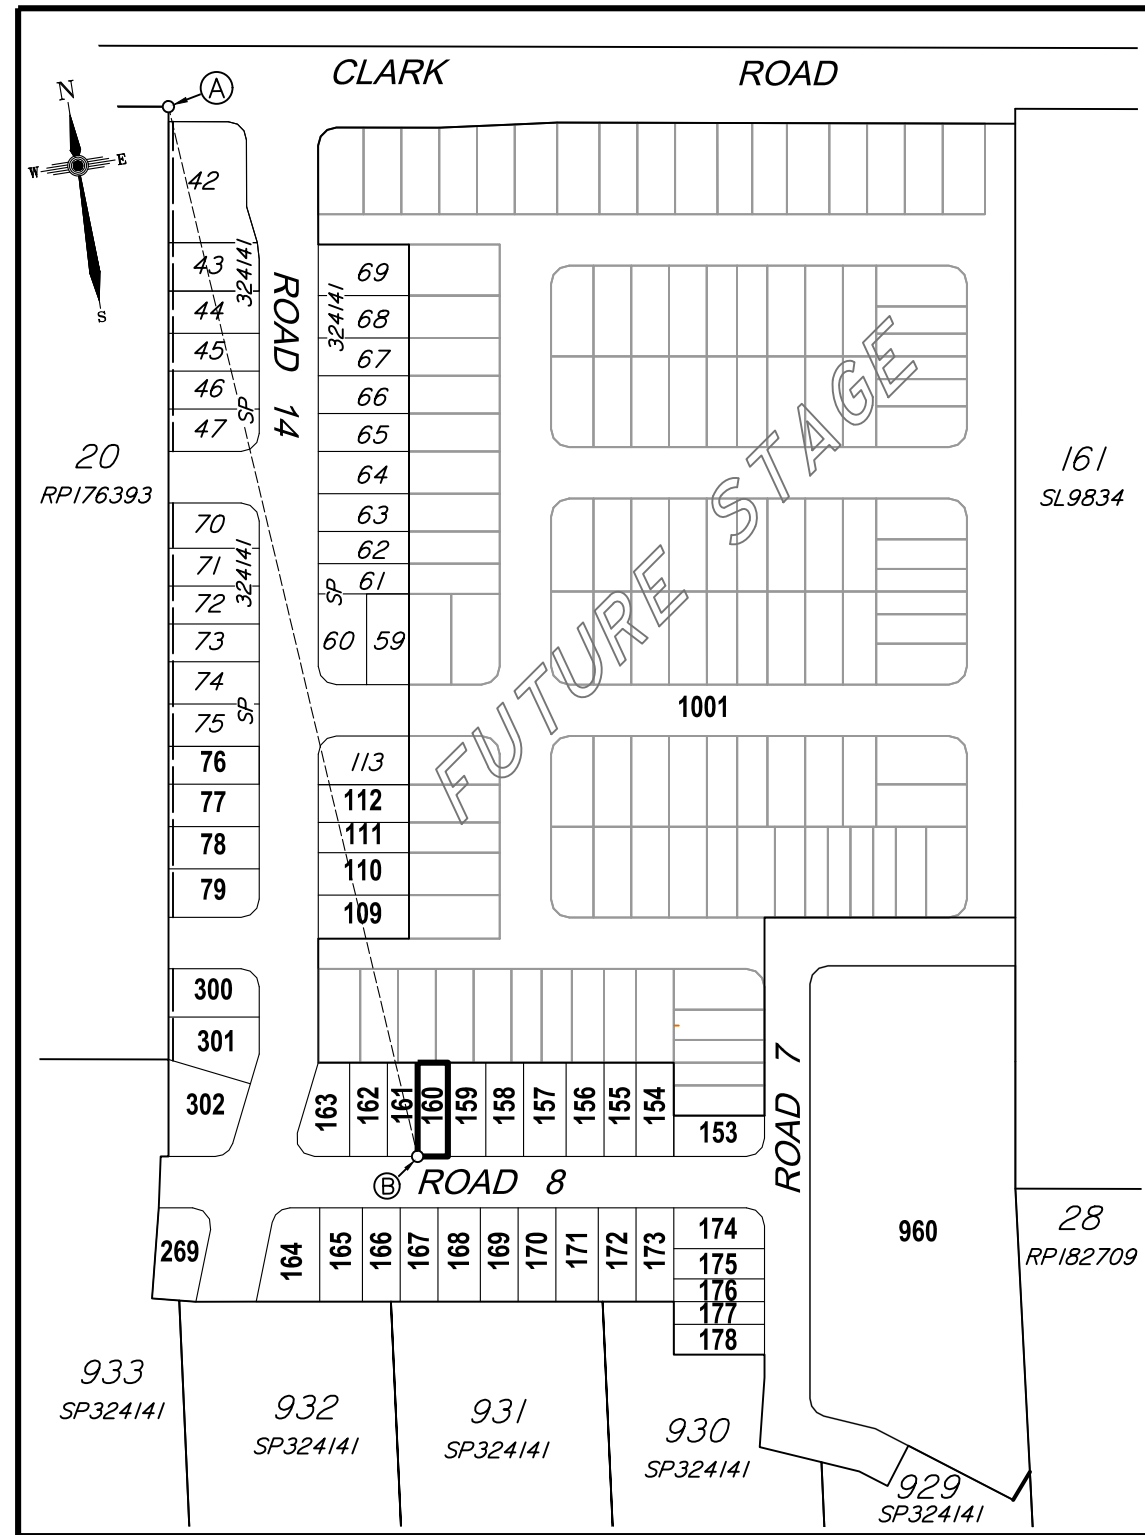


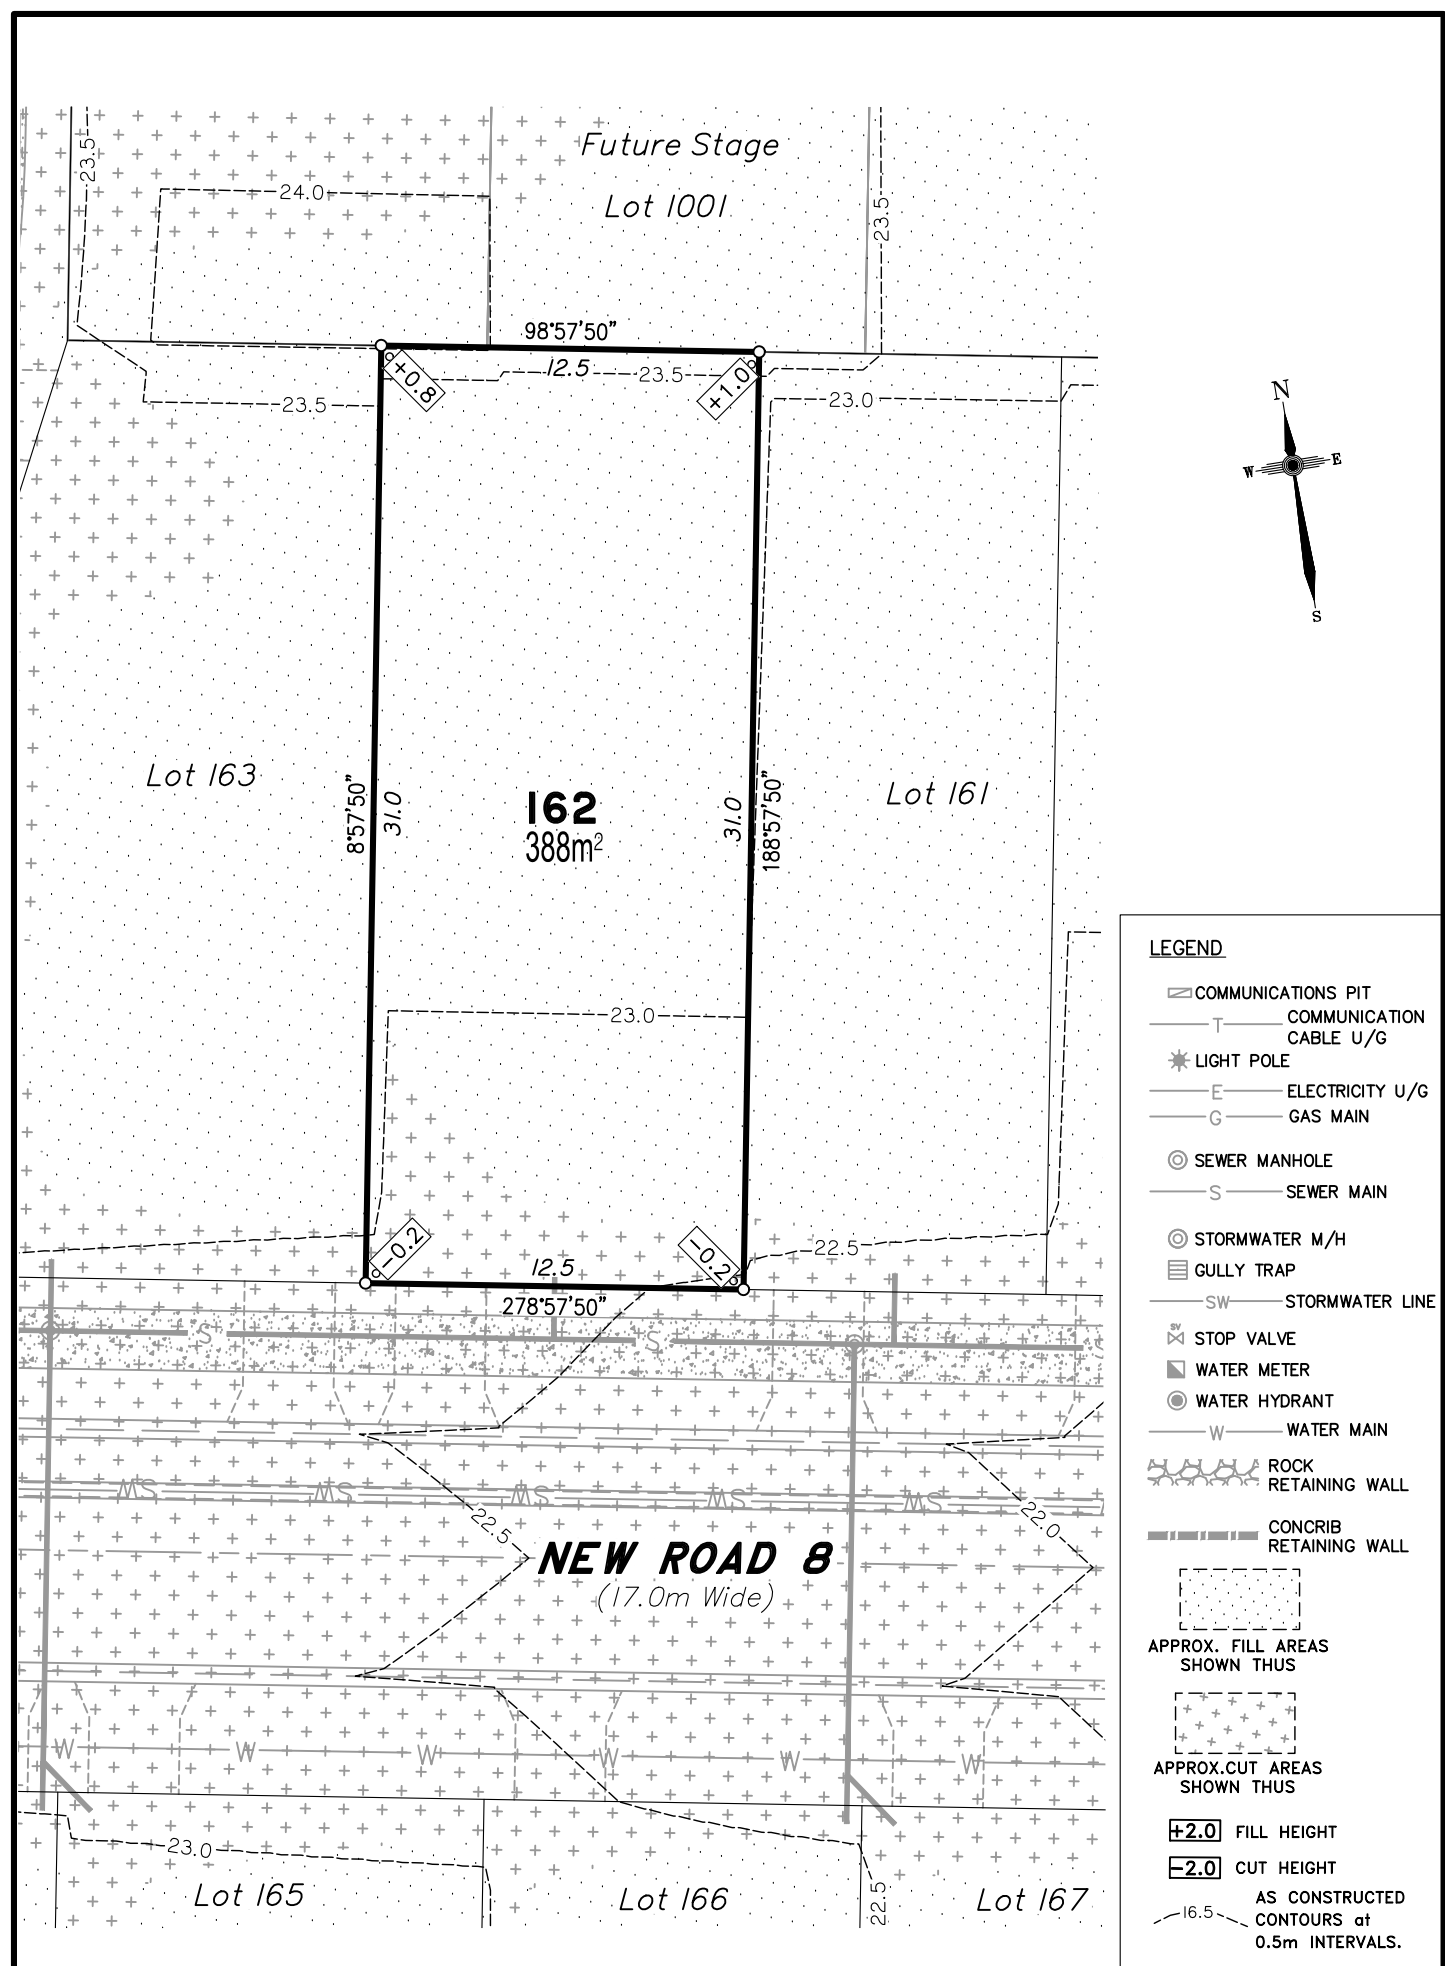

DISCLOSURE PLAN
FOR PROPOSED ALLOTMENT 162
Dated 20th July 2021

This plan shows details of Proposed Allotment 162 on the Proposal Plan 12244-PRO-17 Rev G dated 14/12/2020, which complies with the Development Approval DA/34253/2017/V3RL dated 17th February 2021, approved by Moreton Bay Regional Council, subject to conditions, and associated Judgment by the Planning and Environment Court (1987 of 2018).

The description of the proposed allotment 162, is as part of Lot 1000 on SP324141 (Formally lots 21-24 on RP176393), and situated at Clark Road, Morayfield, commencing at an initial point (A) being the north eastern most point of Lot 20 on RP176393 and thence bounding off on a bearing of 179°10'30" and a distance of 352.192m to point (B) at proposed allotment 162, and containing an area of 388 square metres, more or less.

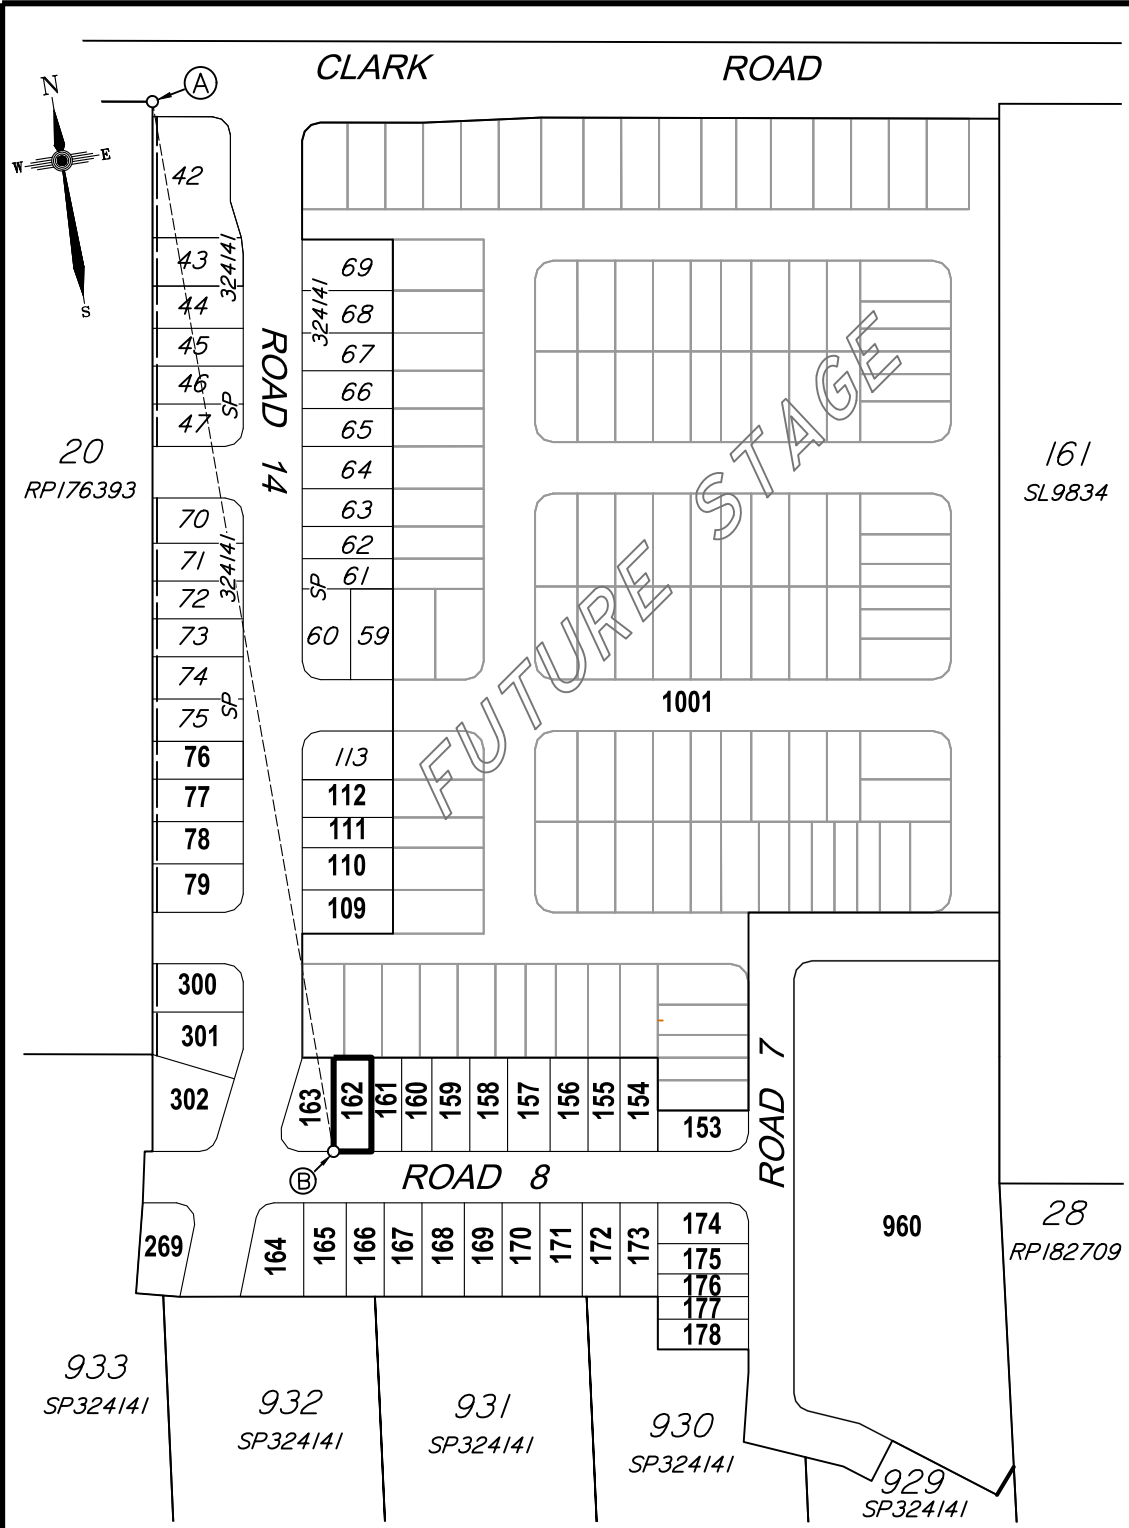

Disclosure Plan
Summerstone Estate,
Morayfield
PROPOSED STAGE 2
ALLOTMENTS 76-79, 109-112, 153-178
& 300-302
 Cancelling Lot 1000 on SP324141
 (Formally Lots 21-24 on RP176393)
PROPOSED LOT 162

DETAIL SURVEY COMPLETED BY LSD 26/06/2021.
 ENGINEERING DESIGN BY GREEN-HAVEN PROJECTS.
 ANY FILLING ON THIS LOT IS TO BE COMPLETED TO LEVEL ONE SUPERVISION AND TESTING IN ACCORDANCE WITH THE REQUIREMENTS OF AS 3798-2007 "GUIDELINES ON EARTHWORKS FOR COMMERCIAL AND RESIDENTIAL DEVELOPMENTS".

Revisions	Surveyed	Drawn	Checked	Passed	Date
A ORIGINAL PLAN	LSD	LA	MH	LS	20/07/21

PO Box 6334, Maroochydore BC QLD 4558
 10/1 Newspaper Place, Maroochydore QLD 4558
 Mobile: 0412 666 516
 Email: mail@landsurveyingdynamics.com
 Web: www.landsurveyingdynamics.com
 Land Surveying Dynamics (LSD) Pty Ltd
 ACN 154 593 670

Signed
 Cadastral Surveyor/Director
 Date 20/7/2021



Horiz. Datum MGA20 Z56
 Origin GNSS CORS


Vert. Datum AHD
 Origin PSM 42642
 RL 25.417 AHD

Locality: Morayfield
 Local Government: Moreton Bay R.C.

Scale
 SHEET 1 OF 1 **As shown at A3**

COMPUTER FILE 12244-DIS
 DRAWING NUMBER **12116-DIS-162** REV. **A**

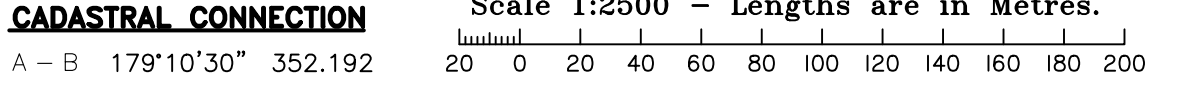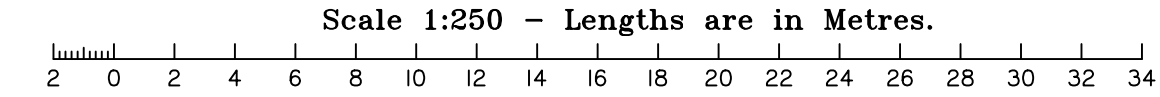

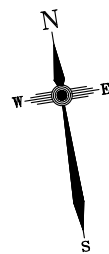

CLARK ROAD

ROAD 14

ROAD 8

ROAD 7

20 RPI76393

161 SL9834

933 SP324141

932 SP324141

931 SP324141

930 SP324141

929 SP324141

163

164 165 166 167 168 169 170 171 172 173 174 175 176 177 178

153 154 155 156 157 158 159 160 161 162

109 110 111 112 113

60 59 61 62 63 64 65 66 67 68 69

47 46 45 44 43 42

79 78 77 76 75 74 73 72 71 70

302 301 300

1001

960

28 RPI82709

FUTURE STAGE

A

B




N

E

S

W

A

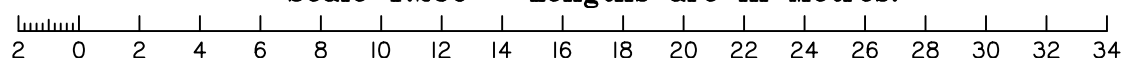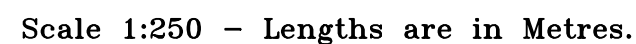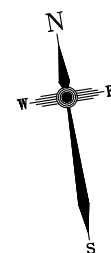

CLARK ROAD

ROAD 14

ROAD 7

ROAD 8

FUTURE STAGE

20
RP176393

161
SL9834

933
SP324141

932
SP324141

931
SP324141

930
SP324141

929
SP324141

164

163

162

161

160

159

158

157

156

155

154

153

174

175

176

177

178

1001

960

161
SL9834

933
SP324141

932
SP324141

931
SP324141

930
SP324141

929
SP324141

164

165

166

1001

960

161
SL9834

933
SP324141

932
SP324141

931
SP324141

930
SP324141

929
SP324141

164

165

166

167

168

169

170

171

172

173


174

175

176


177

12116-DIS-164 A

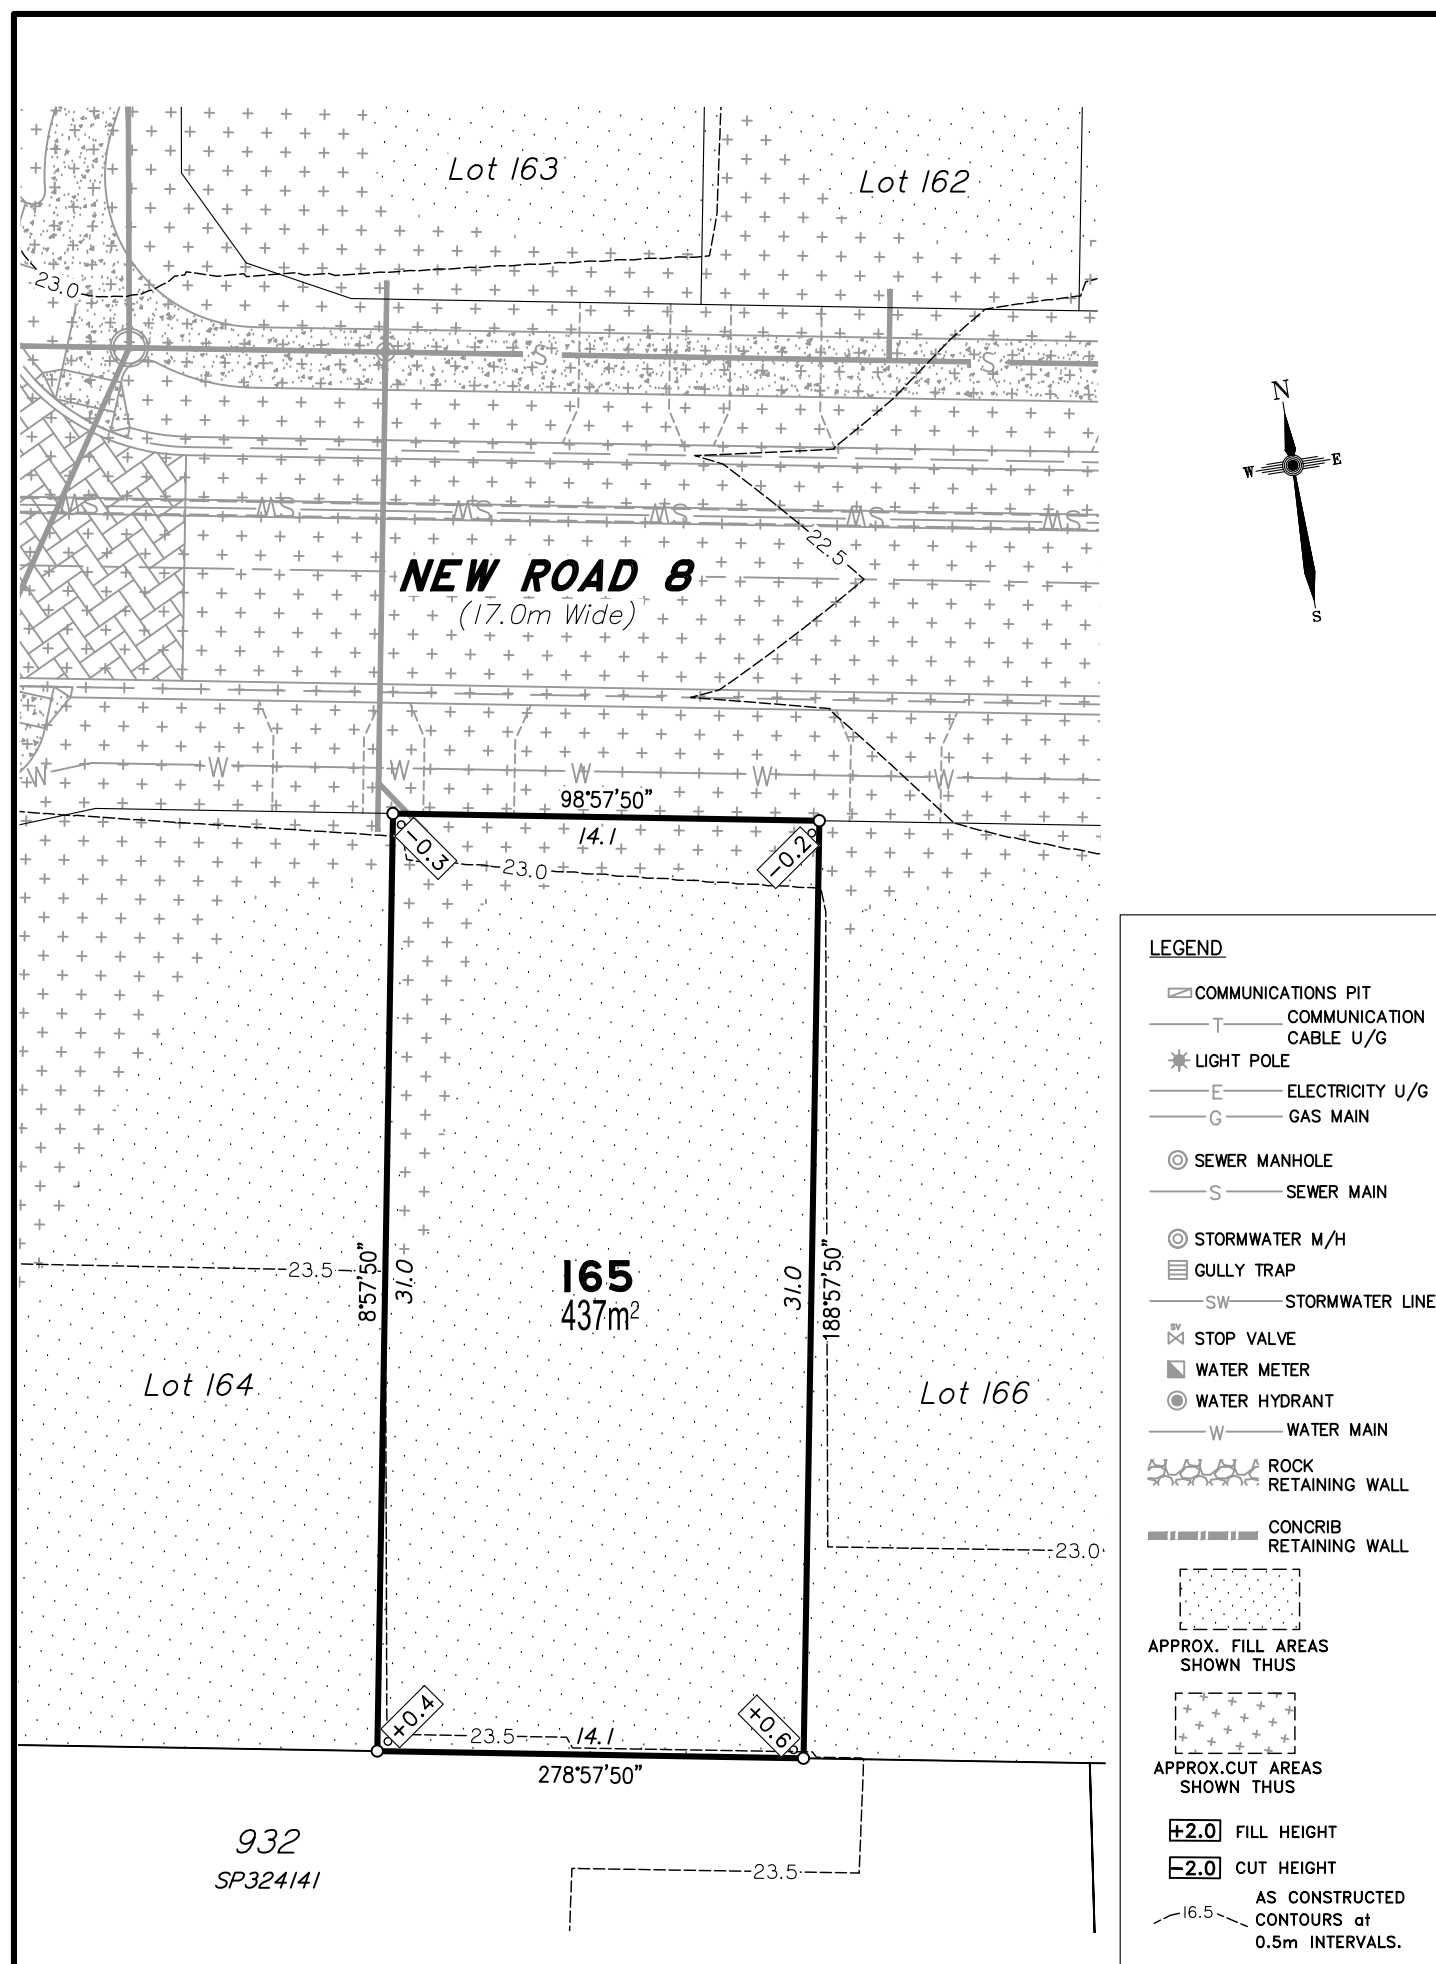

- LEGEND**
- ☐ COMMUNICATIONS PIT
 - T — COMMUNICATION CABLE U/G
 - ★ LIGHT POLE
 - E — ELECTRICITY U/G
 - G — GAS MAIN
 - ⊙ SEWER MANHOLE
 - S — SEWER MAIN
 - ⊙ STORMWATER M/H
 - ☐ GULLY TRAP
 - SW — STORMWATER LINE
 - ✕ STOP VALVE
 - ⊠ WATER METER
 - ⊙ WATER HYDRANT
 - W — WATER MAIN
 - ⚡ ROCK RETAINING WALL
 - ⚡ CONCRIB RETAINING WALL
 - ⚡ APPROX. FILL AREAS SHOWN THUS
 - ⚡ APPROX. CUT AREAS SHOWN THUS
 - +2.0 FILL HEIGHT
 - 2.0 CUT HEIGHT
 - AS CONSTRUCTED CONTOURS at 0.5m INTERVALS.


Scale 1:250 - Lengths are in Metres.

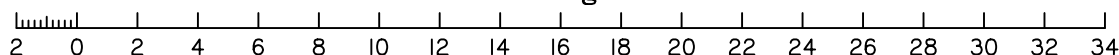

DISCLOSURE PLAN
FOR PROPOSED ALLOTMENT 165
Dated 20th July 2021

This plan shows details of Proposed Allotment 165 on the Proposal Plan 12244-PRO-17 Rev G dated 14/12/2020, which complies with the Development Approval DA/34253/2017/V3RL dated 17th February 2021, approved by Moreton Bay Regional Council, subject to conditions, and associated Judgment by the Planning and Environment Court (1987 of 2018).


The description of the proposed allotment 165, is as part of Lot 1000 on SP324141 (Formally lots 21-24 on RP176393), and situated at Clark Road, Morayfield, commencing at an initial point (A) being the north eastern most point of Lot 20 on RP176393 and thence bounding off on a bearing of 181°08'45" and a distance of 367.479m to point (B) at proposed allotment 165, and containing an area of 437 square metres, more or less.

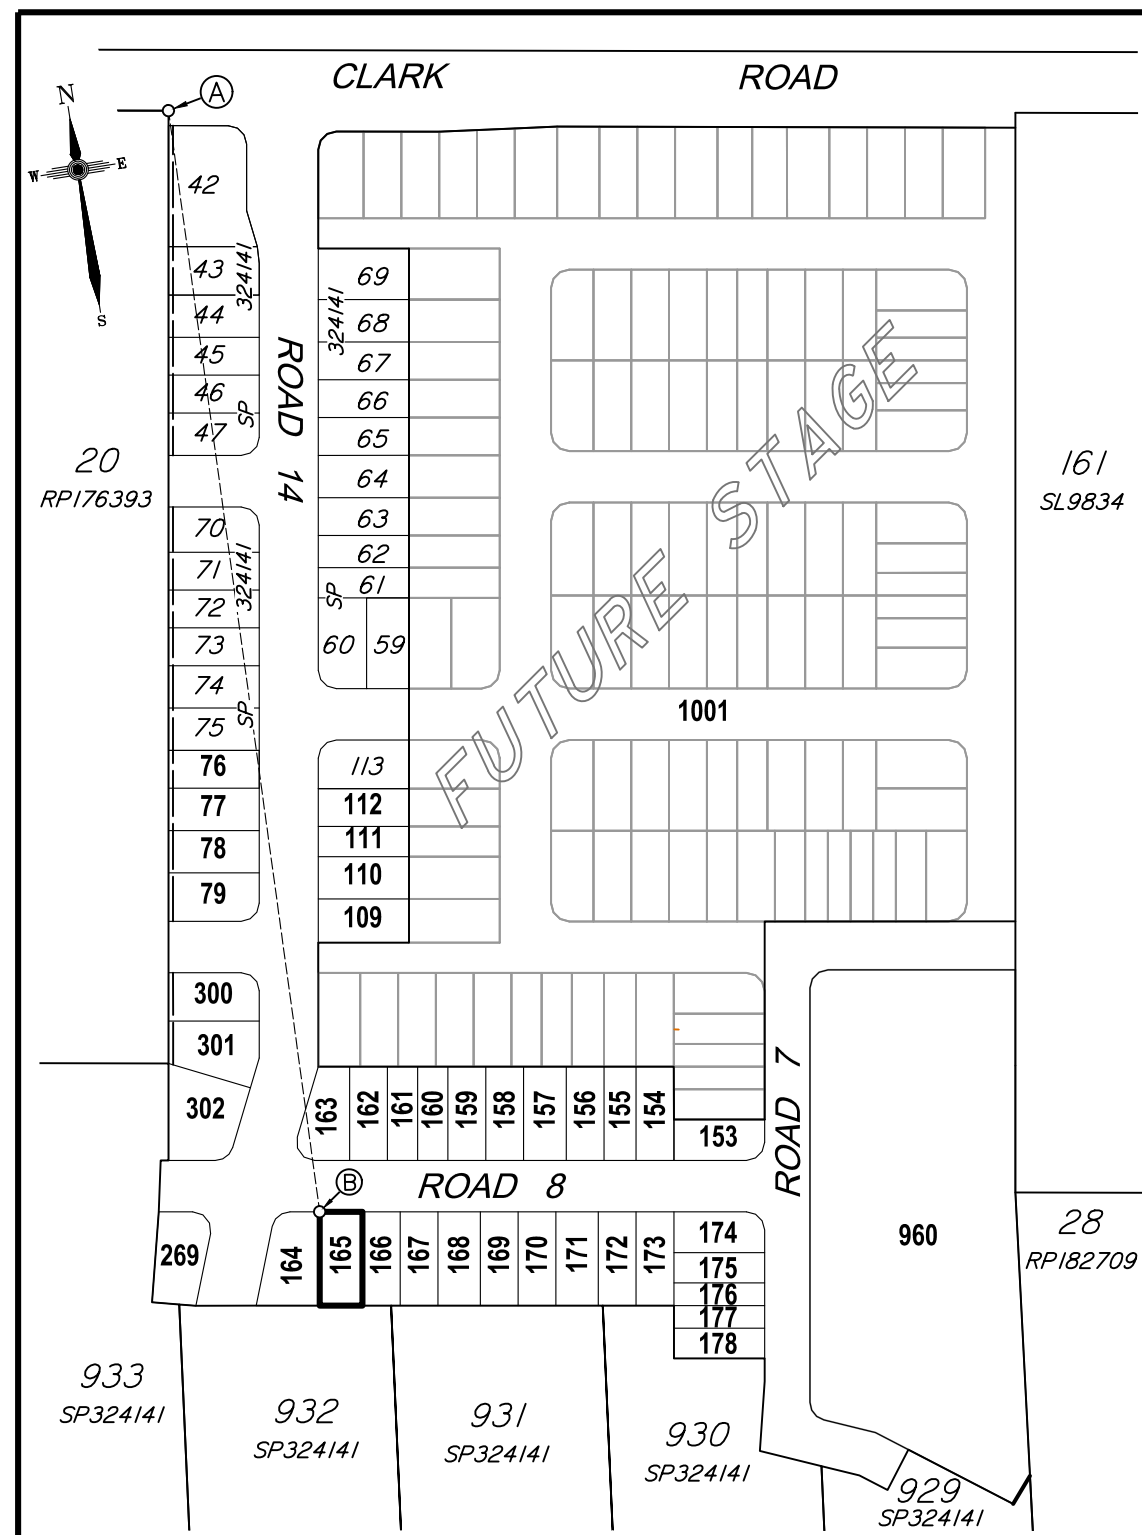

CADASTRAL CONNECTION

A - B 181°08'45" 367.479

Scale 1:2500 - Lengths are in Metres.

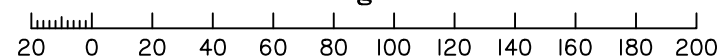

Disclosure Plan

**Summerstone Estate,
Morayfield**


PROPOSED STAGE 2
ALLOTMENTS 76-79, 109-112, 153-178
& 300-302
 Cancelling Lot 1000 on SP324141
 (Formally Lots 21-24 on RP176393)
PROPOSED LOT 165

DETAIL SURVEY COMPLETED BY LSD
 26/06/2021.
 ENGINEERING DESIGN BY GREEN-HAVEN PROJECTS.
 ANY FILLING ON THIS LOT IS TO BE COMPLETED TO LEVEL ONE SUPERVISION AND TESTING IN ACCORDANCE WITH THE REQUIREMENTS OF AS 3798-2007 "GUIDELINES ON EARTHWORKS FOR COMMERCIAL AND RESIDENTIAL DEVELOPMENTS".

Revisions	Surveyed	Drawn	Checked	Passed	Date
A ORIGINAL PLAN	LSD	LA	MH	LS	20/07/21



PO Box 6334, Maroochydore BC QLD 4558
 10/1 Newspaper Place, Maroochydore QLD 4558
 Mobile: 0412 666 516
 Email: mail@landsurveyingdynamics.com
 Web: www.landsurveyingdynamics.com
 Land Surveying Dynamics (LSD) Pty Ltd
 ACN 154 593 870

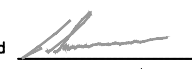Signed 
 Cadastral Surveyor/Director
 Date 20/7/2021

Horiz. Datum MGA20 Z56
 Origin GNSS CORS

Vert. Datum AHD
 Origin PSM 42642
 RL 25.417 AHD


Locality: Morayfield

Local Government: Moreton Bay R.C.


SHEET 1 OF 1 Scale As shown at A3

COMPUTER FILE 12244-DIS
 DRAWING NUMBER REV.

12116-DIS-165 **A**

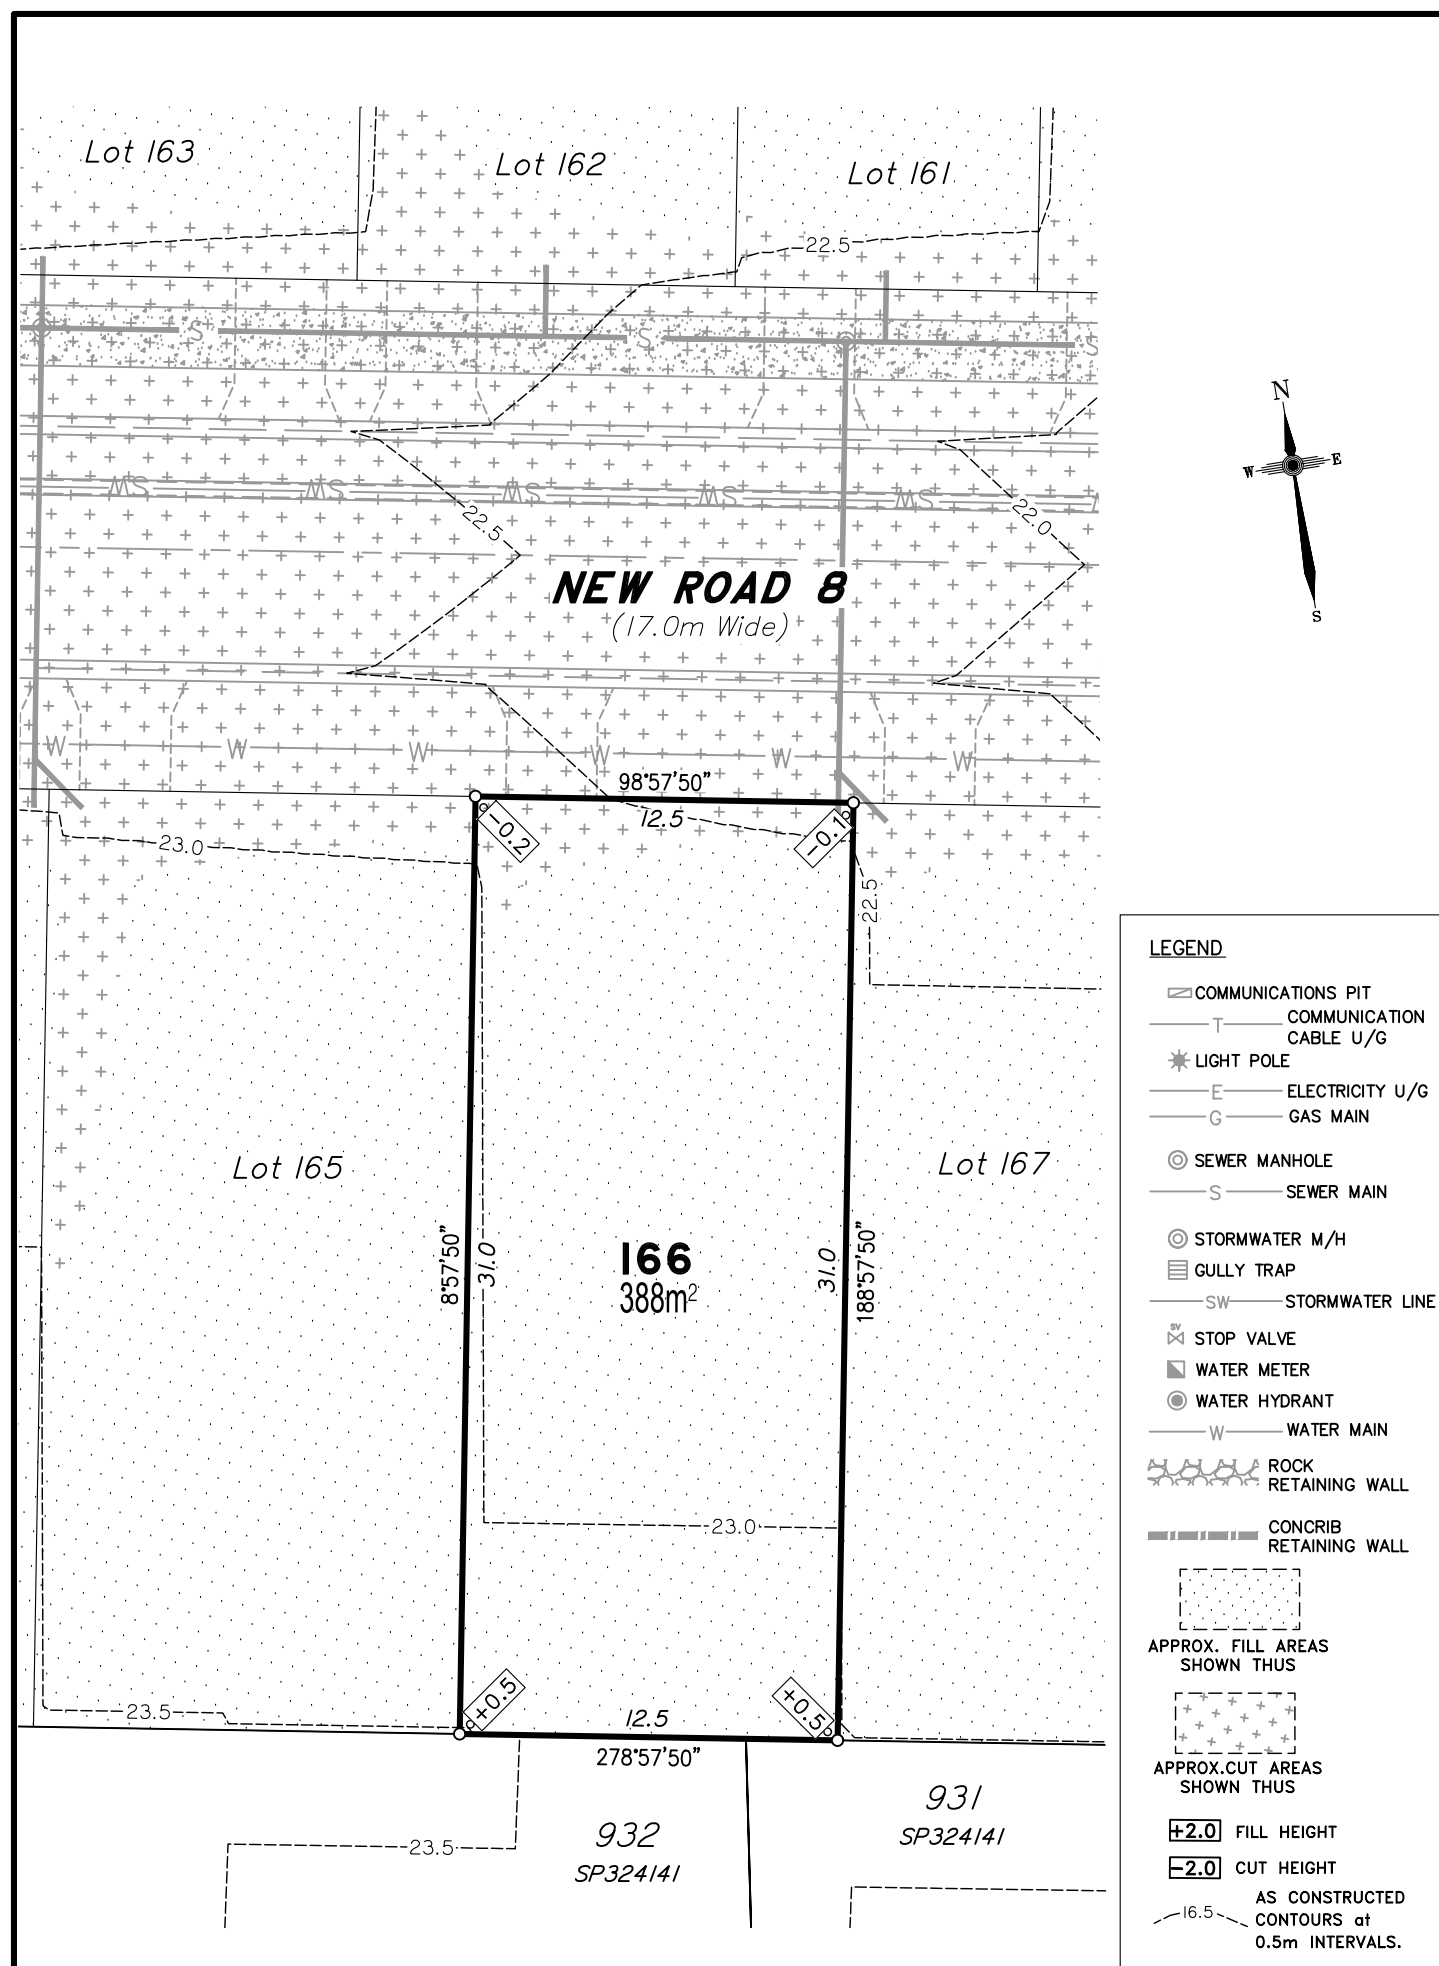


Scale 1:250 - Lengths are in Metres.

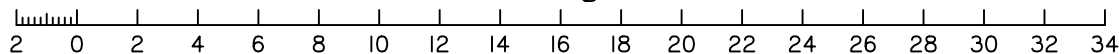


DISCLOSURE PLAN
FOR PROPOSED ALLOTMENT 166
Dated 20th July 2021

This plan shows details of Proposed Allotment 166 on the Proposal Plan 12244-PRO-17 Rev G dated 14/12/2020, which complies with the Development Approval DA/34253/2017/V3RL dated 17th February 2021, approved by Moreton Bay Regional Council, subject to conditions, and associated Judgment by the Planning and Environment Court (1987 of 2018).

The description of the proposed allotment 166, is as part of Lot 1000 on SP324141 (Formally lots 21-24 on RP176393), and situated at Clark Road, Morayfield, commencing at an initial point (A) being the north eastern most point of Lot 20 on RP176393 and thence bounding off on a bearing of 178°58'50" and a distance of 369.661m to point (B) at proposed allotment 166, and containing an area of 388 square metres, more or less.

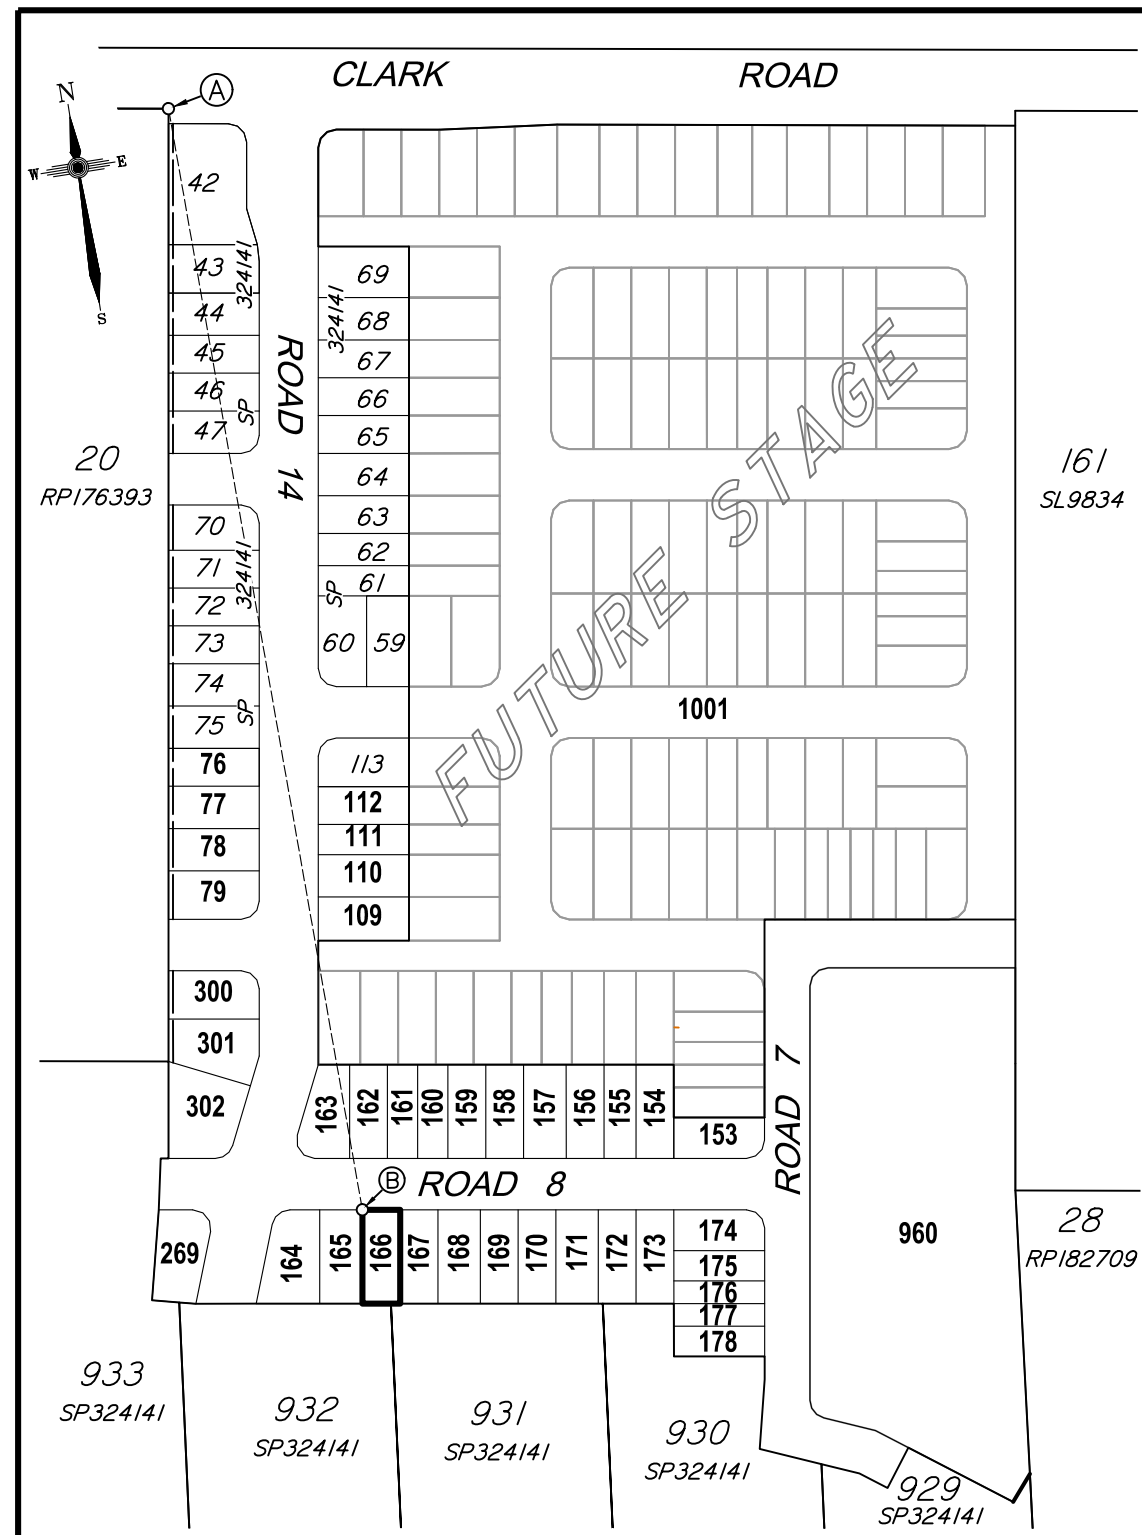


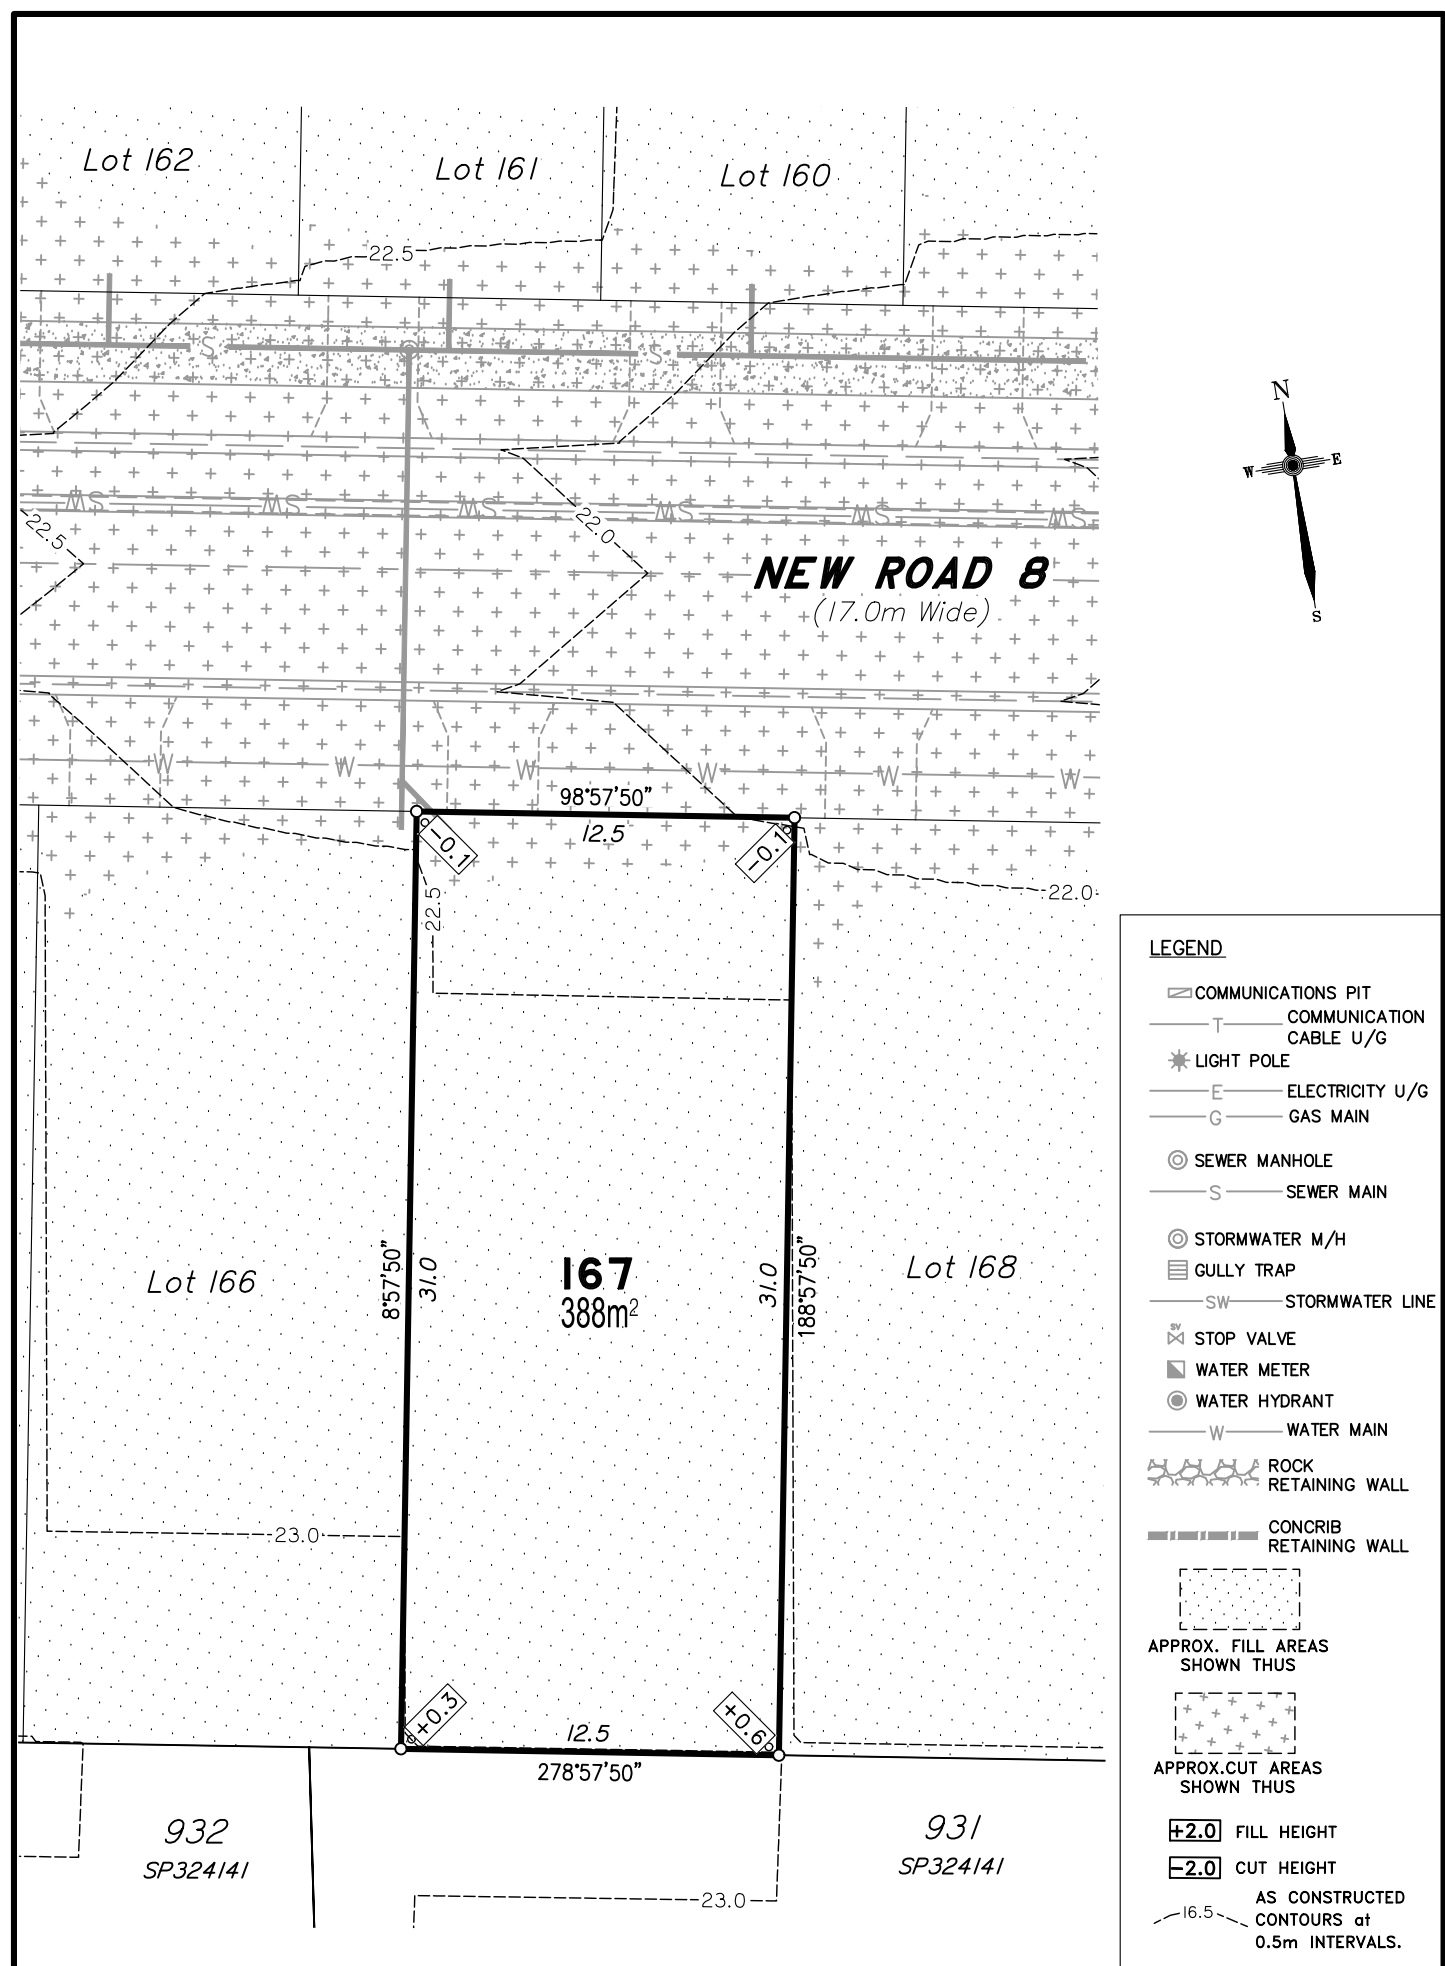

DISCLOSURE PLAN
FOR PROPOSED ALLOTMENT 167
Dated 20th July 2021

This plan shows details of Proposed Allotment 167 on the Proposal Plan 12244-PRO-17 Rev G dated 14/12/2020, which complies with the Development Approval DA/34253/2017/V3RL dated 17th February 2021, approved by Moreton Bay Regional Council, subject to conditions, and associated Judgment by the Planning and Environment Court (1987 of 2018).

The description of the proposed allotment 167, is as part of Lot 1000 on SP324141 (Formally lots 21-24 on RP176393), and situated at Clark Road, Morayfield, commencing at an initial point (A) being the north eastern most point of Lot 20 on RP176393 and thence bounding off on a bearing of 175°12'50" and a distance of 374.805m to point (B) at proposed allotment 167, and containing an area of 388 square metres, more or less.

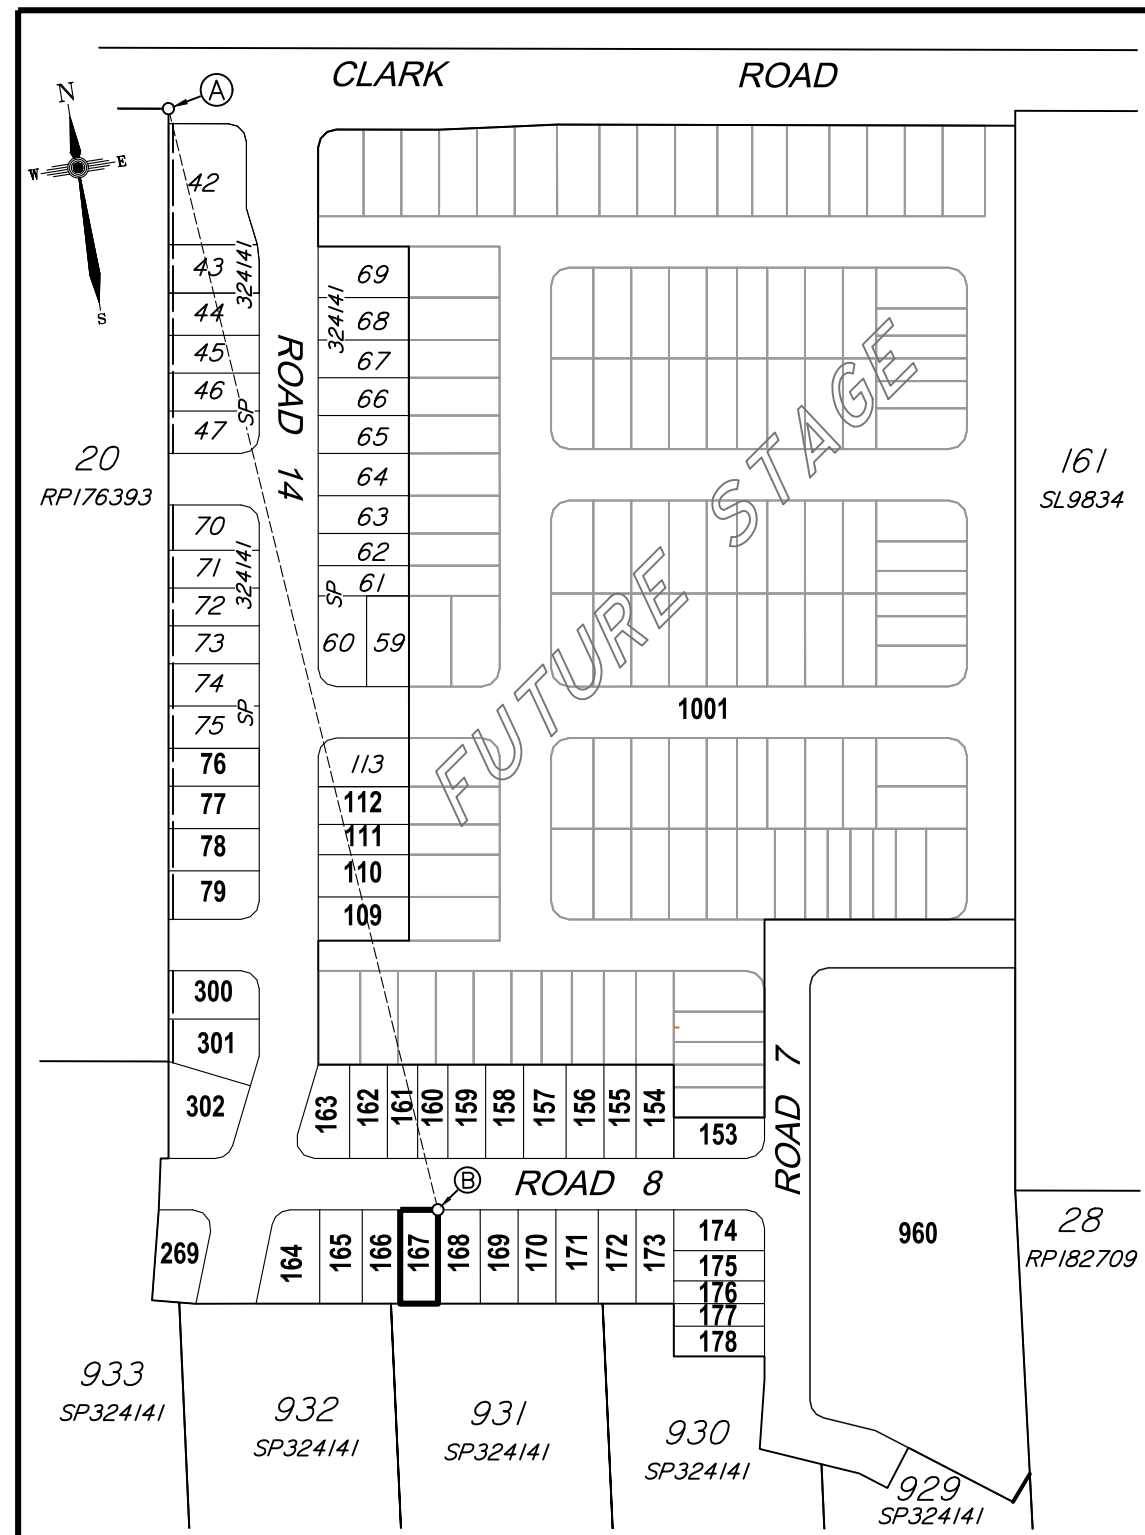

Disclosure Plan
Summerstone Estate,
Morayfield
PROPOSED STAGE 2
ALLOTMENTS 76-79, 109-112, 153-178
& 300-302
Cancelling Lot 1000 on SP324141
(Formally Lots 21-24 on RP176393)
PROPOSED LOT 167

DETAIL SURVEY COMPLETED BY LSD 26/06/2021.
ENGINEERING DESIGN BY GREEN-HAVEN PROJECTS.
ANY FILLING ON THIS LOT IS TO BE COMPLETED TO LEVEL ONE SUPERVISION AND TESTING IN ACCORDANCE WITH THE REQUIREMENTS OF AS 3798-2007 "GUIDELINES ON EARTHWORKS FOR COMMERCIAL AND RESIDENTIAL DEVELOPMENTS".

Revisions	Surveyed	Drawn	Checked	Passed	Date

LSD
LAND SURVEYING DYNAMICS

PO Box 6334, Maroochydore BC QLD 4558
10/1 Newspaper Place, Maroochydore QLD 4558
Mobile: 0412 666 516
Email: mail@landsurveyingdynamics.com
Web: www.landsurveyingdynamics.com
Land Surveying Dynamics (LSD) Pty Ltd
ACN 154 593 870


Signed **Cadastral Surveyor/Director**
Date **20/7/2021**

Horiz. Datum MGA20 Z56
Origin GNSS CORS
Vert. Datum AHD
Origin PSM 42642
RL 25.417 AHD
Locality: Morayfield
Local Government: Moreton Bay R.C.


Scale **As shown at A3**
SHEET 1 OF 1
COMPUTER FILE 12244-DIS
DRAWING NUMBER **12116-DIS-167**
REV. **A**

CADASTRAL CONNECTION
A - B 175°12'50" 374.805

Scale 1:2500 - Lengths are in Metres.
20 0 20 40 60 80 100 120 140 160 180 200

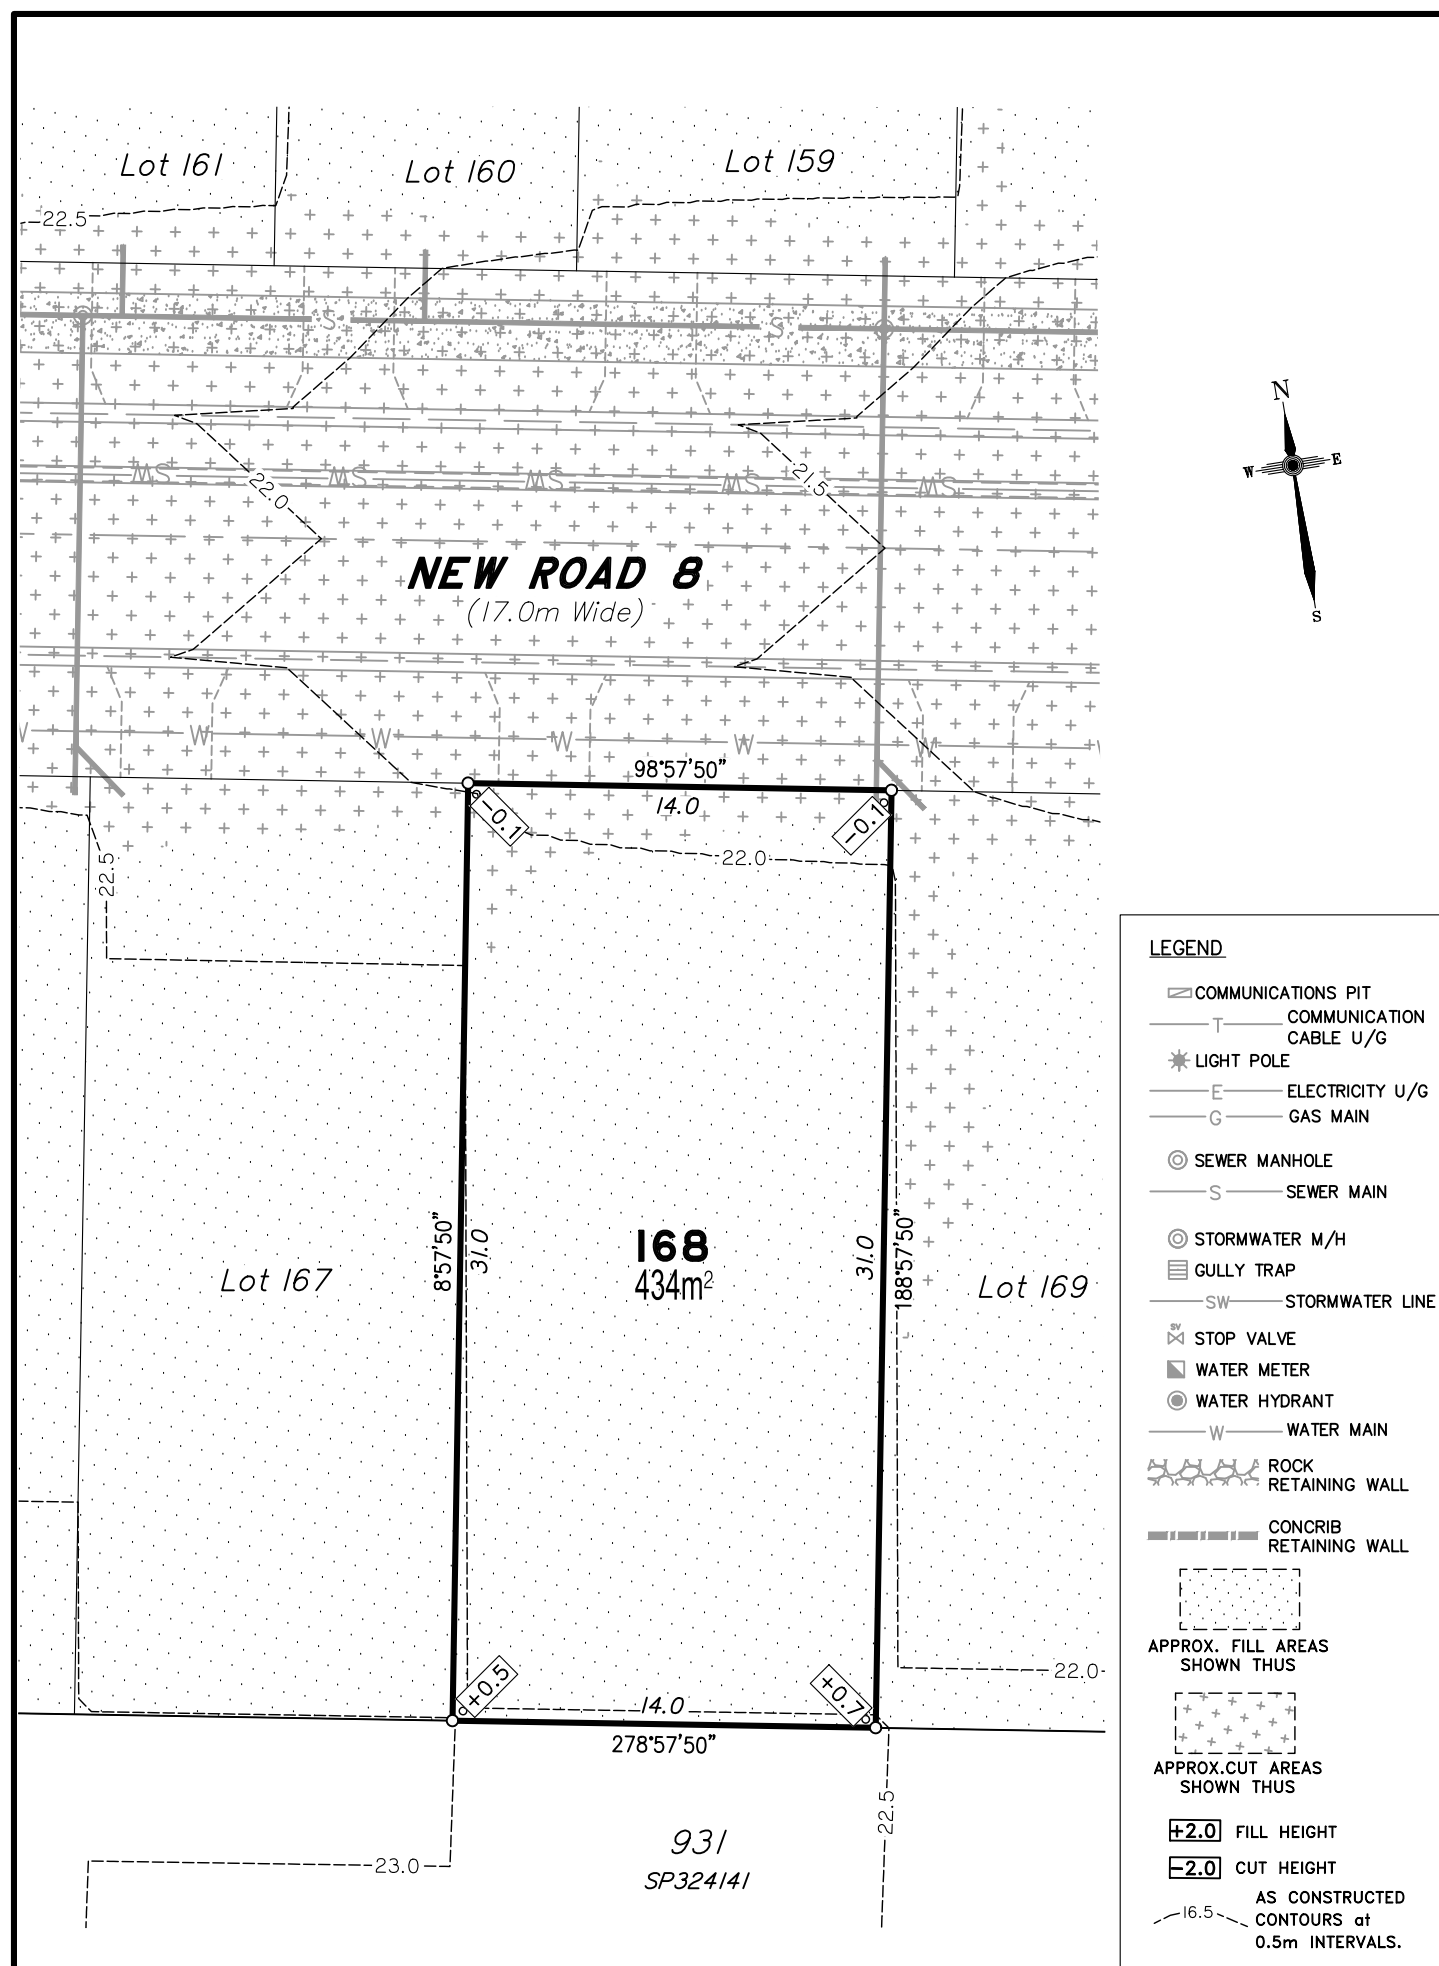


Scale 1:250 - Lengths are in Metres.

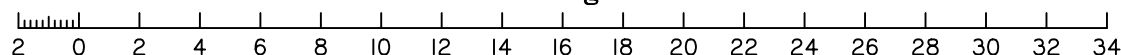

DISCLOSURE PLAN
FOR PROPOSED ALLOTMENT 168
Dated 20th July 2021

This plan shows details of Proposed Allotment 168 on the Proposal Plan 12244-PRO-17 Rev G dated 14/12/2020, which complies with the Development Approval DA/34253/2017/V3RL dated 17th February 2021, approved by Moreton Bay Regional Council, subject to conditions, and associated Judgment by the Planning and Environment Court (1987 of 2018).


The description of the proposed allotment 168, is as part of Lot 1000 on SP324141 (Formally lots 21-24 on RP176393), and situated at Clark Road, Morayfield, commencing at an initial point (A) being the north eastern most point of Lot 20 on RP176393 and thence bounding off on a bearing of 175°12'50" and a distance of 374.805m to point (B) at proposed allotment 168, and containing an area of 434 square metres, more or less.

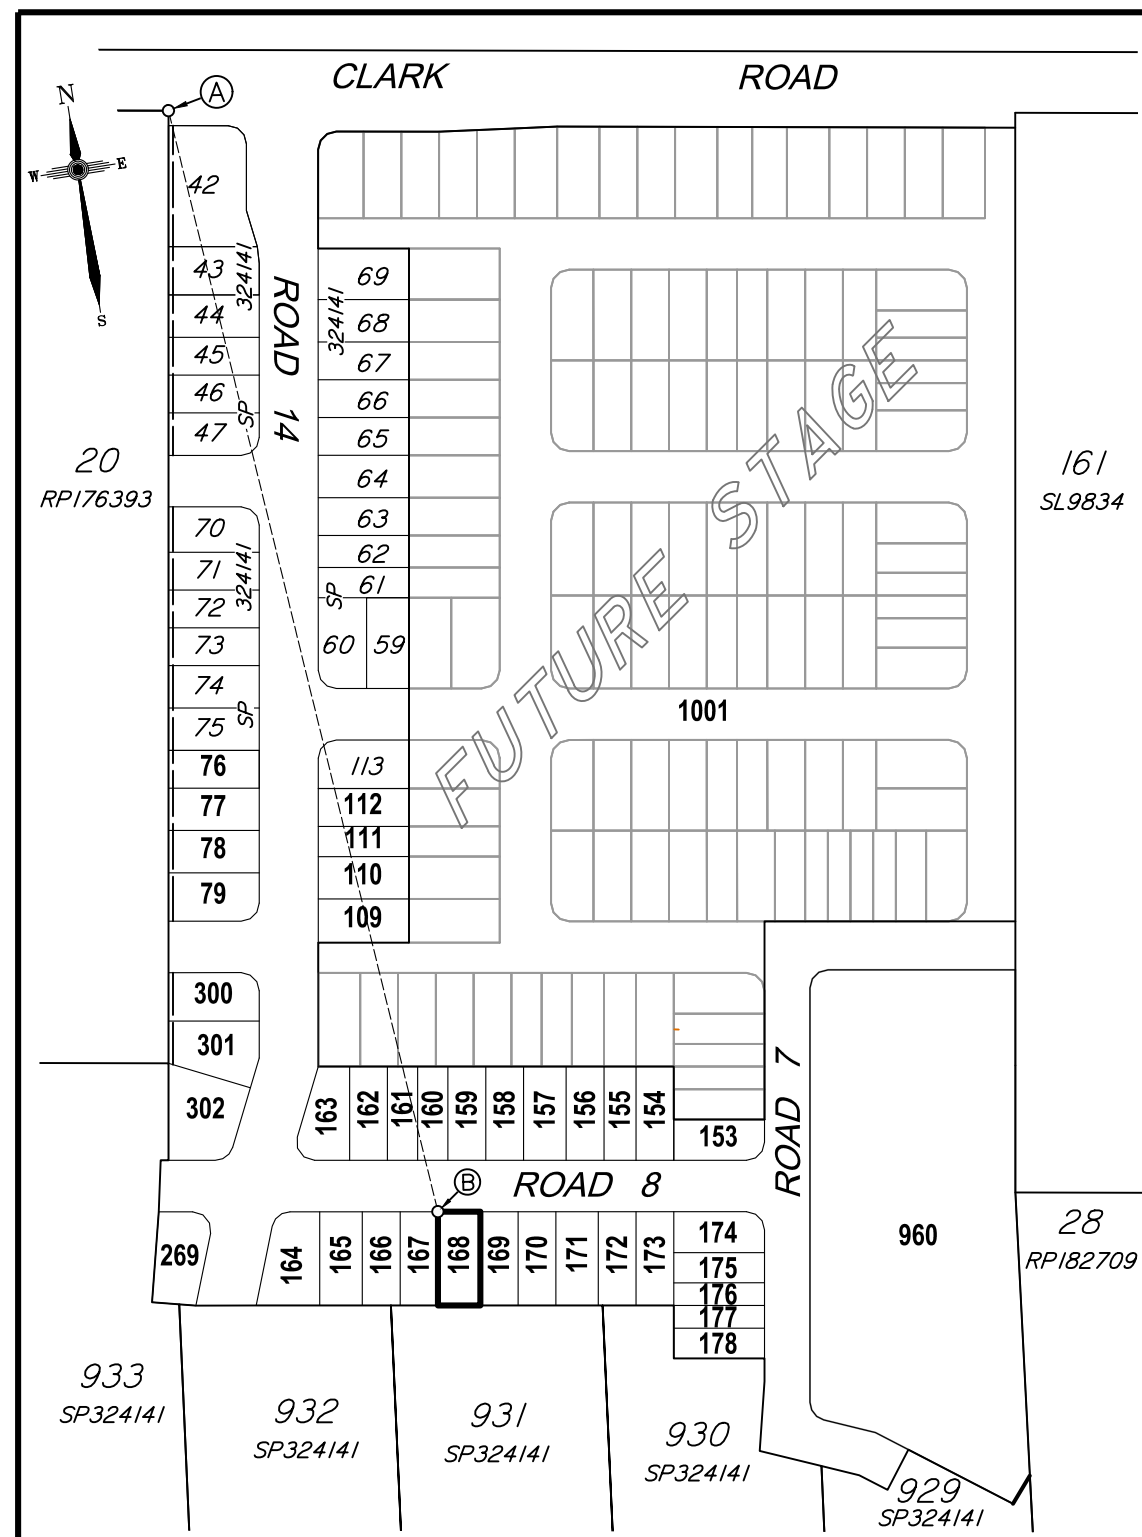

CADASTRAL CONNECTION

A - B 175°12'50" 374.805

Scale 1:2500 - Lengths are in Metres.

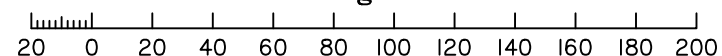

Disclosure Plan

**Summerstone Estate,
Morayfield**

PROPOSED STAGE 2

ALLOTMENTS 76-79, 109-112, 153-178
& 300-302

Cancelling Lot 1000 on SP324141
(Formally Lots 21-24 on RP176393)

PROPOSED LOT 168

DETAIL SURVEY COMPLETED BY LSD
26/06/2021.
ENGINEERING DESIGN BY GREEN-
HAVEN PROJECTS.
ANY FILLING ON THIS LOT IS TO BE
COMPLETED TO LEVEL ONE
SUPERVISION AND TESTING IN
ACCORDANCE WITH THE
REQUIREMENTS OF AS 3798-2007
"GUIDELINES ON EARTHWORKS FOR
COMMERCIAL AND RESIDENTIAL
DEVELOPMENTS".

Revisions	Surveyed	Drawn	Checked	Passed	Date

A ORIGINAL PLAN LSD LA MH LS 20/07/21



PO Box 6334, Maroochydore BC QLD 4558
10/1 Newspaper Place, Maroochydore QLD 4558
Mobile: 0412 666 516
Email: mail@landsurveyingdynamics.com
Web: www.landsurveyingdynamics.com
Land Surveying Dynamics (LSD) Pty Ltd
ACN 154 593 870

Signed
Cadastral Surveyor/Director
Date 20/7/2021

Horiz. Datum MGA20 Z56
Origin GNSS CORS

Vert. Datum AHD
Origin PSM 42642
RL 25.417 AHD




Locality: Morayfield

Local Government: Moreton Bay R.C.

SHEET 1 OF 1 Scale As shown at A3

COMPUTER FILE 12244-DIS
DRAWING NUMBER

12116-DIS-168 REV. **A**

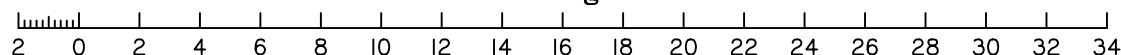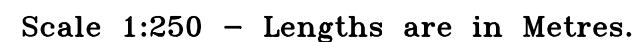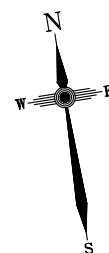

CLARK ROAD

ROAD 14

ROAD 7

ROAD 8

FUTURE STAGE

Lot Numbers:


- 42, 43, 44, 45, 46, 47, 70, 71, 72, 73, 74, 75, 76, 77, 78, 79, 300, 301, 302, 269, 164, 165, 166, 167, 168, 169, 170, 171, 172, 173, 174, 175, 176, 177, 178, 153, 154, 155, 156, 157, 158, 159, 160, 161, 162, 163, 113, 112, 111, 110, 109, 60, 59, 61, 62, 63, 64, 65, 66, 67, 68, 69, 1001, 960, 929


Point A is located at the intersection of Clark Road and Road 14. **Point B** is located at the intersection of Road 8 and Road 14.

Watermark: FUTURE STAGE

Other Labels: 20, RPI76393, 161, SL9834, 933, SP324141, 932, SP324141, 931, SP324141, 930, SP324141, 929, SP324141

SHEET 1 OF 1		Scale As shown at A3
COMPUTER FILE		12244--DIS
DRAWING NUMBER		REV.
12116-DIS-169		A

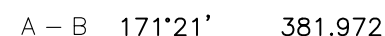


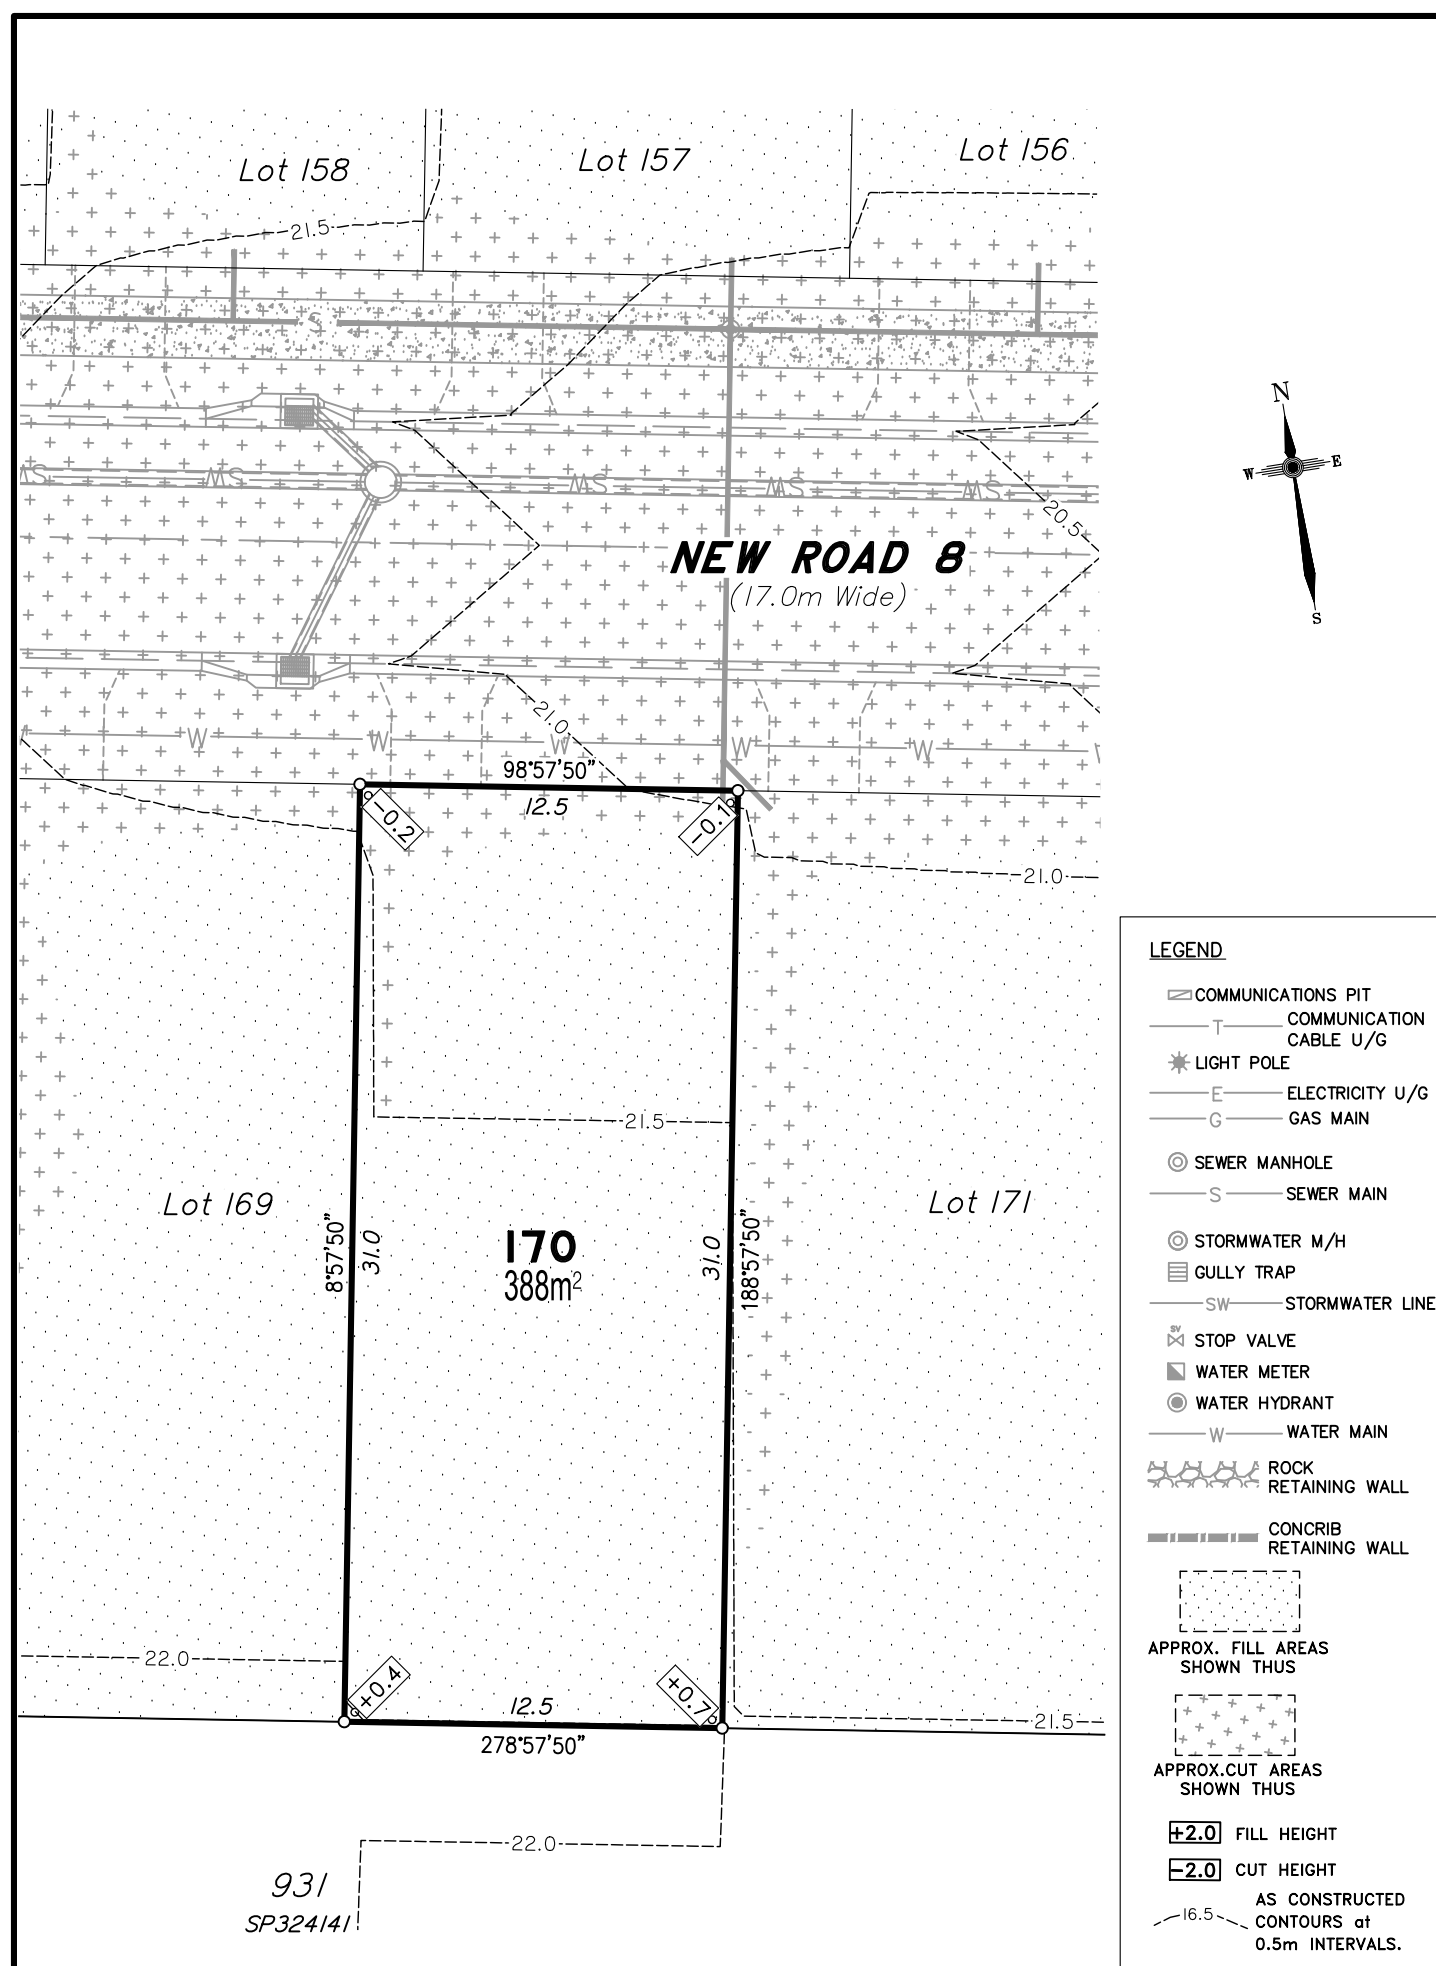

DISCLOSURE PLAN
FOR PROPOSED ALLOTMENT 170
Dated 20th July 2021

This plan shows details of Proposed Allotment 170 on the Proposal Plan 12244-PRO-17 Rev G dated 14/12/2020, which complies with the Development Approval DA/34253/2017/V3RL dated 17th February 2021, approved by Moreton Bay Regional Council, subject to conditions, and associated Judgment by the Planning and Environment Court (1987 of 2018).

The description of the proposed allotment 170, is as part of Lot 1000 on SP324141 (Formally lots 21-24 on RP176393), and situated at Clark Road, Morayfield, commencing at an initial point (A) being the north eastern most point of Lot 20 on RP176393 and thence bounding off on a bearing of 171°21' and a distance of 381.972m to point (B) at proposed allotment 170, and containing an area of 388 square metres, more or less.

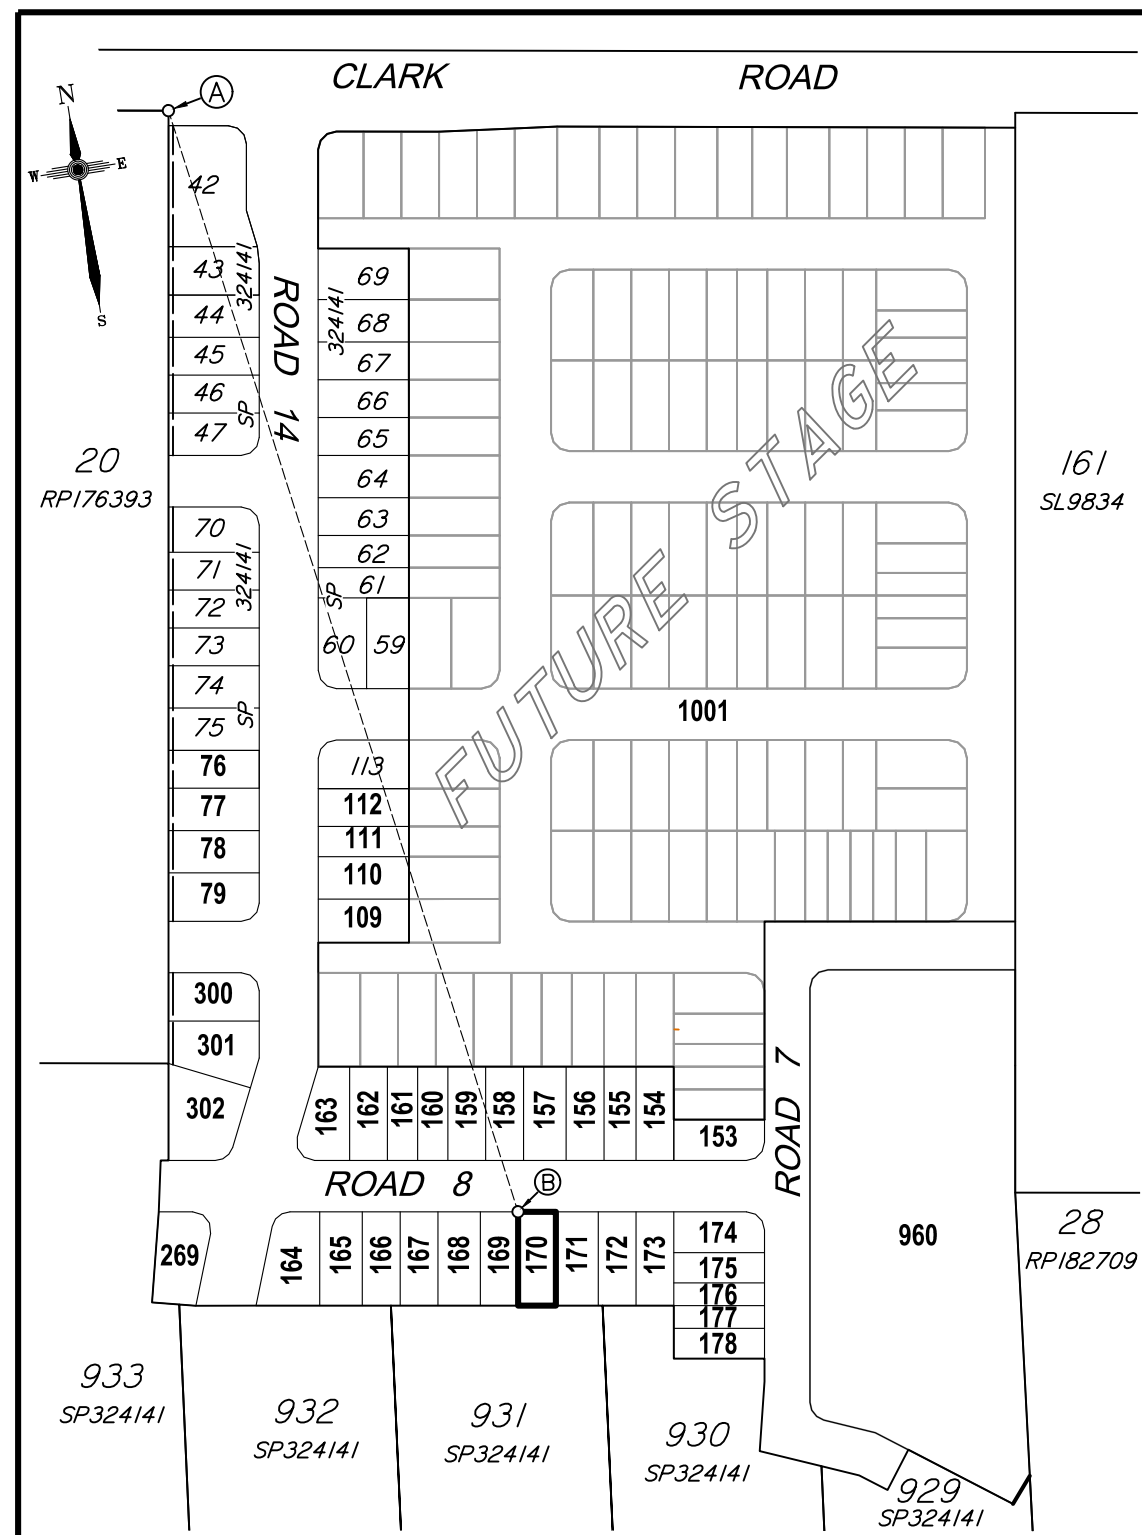

Disclosure Plan

**Summerstone Estate,
Morayfield**

PROPOSED STAGE 2
ALLOTMENTS 76-79, 109-112, 153-178
& 300-302
Cancelling Lot 1000 on SP324141
(Formally Lots 21-24 on RP176393)
PROPOSED LOT 170

DETAIL SURVEY COMPLETED BY LSD
26/06/2021.
ENGINEERING DESIGN BY GREEN-
HAVEN PROJECTS.
ANY FILLING ON THIS LOT IS TO BE
COMPLETED TO LEVEL ONE
SUPERVISION AND TESTING IN
ACCORDANCE WITH THE
REQUIREMENTS OF AS 3798-2007
"GUIDELINES ON EARTHWORKS FOR
COMMERCIAL AND RESIDENTIAL
DEVELOPMENTS".

Revisions	Surveyed	Drawn	Checked	Passed	Date
A ORIGINAL PLAN	LSD	LA	MH	LS	20/07/21



PO Box 6334, Maroochydore BC QLD 4558
10/1 Newspaper Place, Maroochydore QLD 4558
Mobile: 0412 666 516
Email: mail@landsurveyingdynamics.com
Web: www.landsurveyingdynamics.com
Land Surveying Dynamics (LSD) Pty Ltd
ACN 154 593 870


Signed
Cadastral Surveyor/Director
Date 20/7/2021

Horiz. Datum MGA20 Z56
Origin GNSS CORS


Vert. Datum AHD
Origin PSM 42642
RL 25.417 AHD

Locality: Morayfield
Local Government: Moreton Bay R.C.

Scale
SHEET 1 OF 1 **As shown at A3**
COMPUTER FILE 12244-DIS
DRAWING NUMBER **12116-DIS-170** REV. **A**

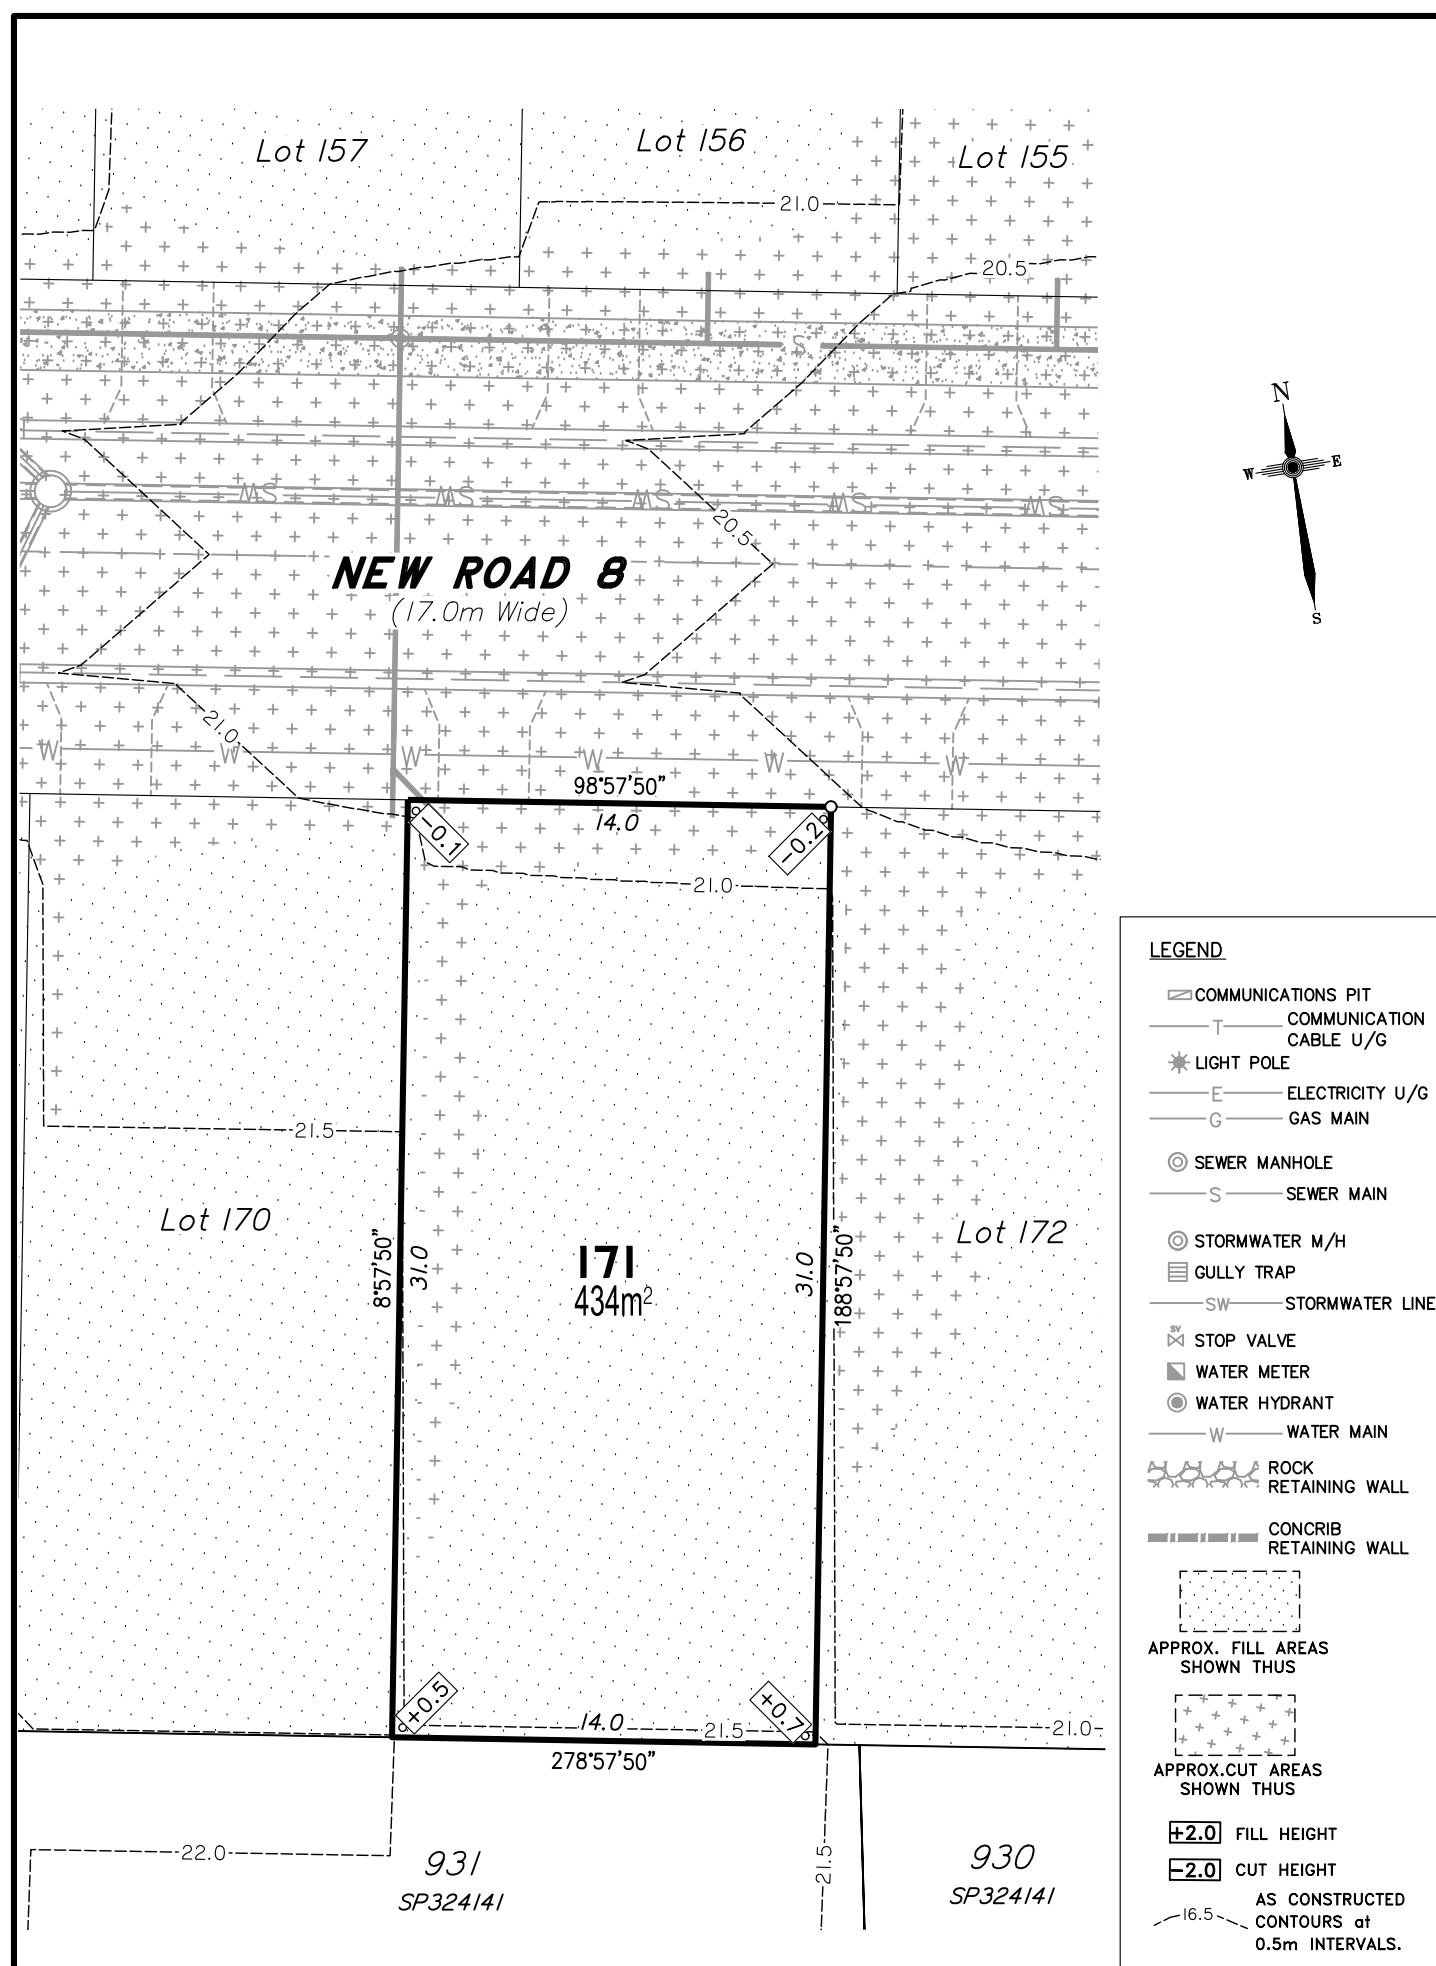


Scale 1:250 - Lengths are in Metres.

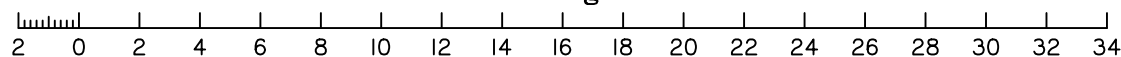

DISCLOSURE PLAN
FOR PROPOSED ALLOTMENT 171
Dated 20th July 2021

This plan shows details of Proposed Allotment 171 on the Proposal Plan 12244-PRO-17 Rev G dated 14/12/2020, which complies with the Development Approval DA/34253/2017/V3RL dated 17th February 2021, approved by Moreton Bay Regional Council, subject to conditions, and associated Judgment by the Planning and Environment Court (1987 of 2018).


The description of the proposed allotment 171, is as part of Lot 1000 on SP324141 (Formally lots 21-24 on RP176393), and situated at Clark Road, Morayfield, commencing at an initial point (A) being the north eastern most point of Lot 20 on RP176393 and thence bounding off on a bearing of 167°38'40" and a distance of 390.808m to point (B) at proposed allotment 171, and containing an area of 434 square metres, more or less.

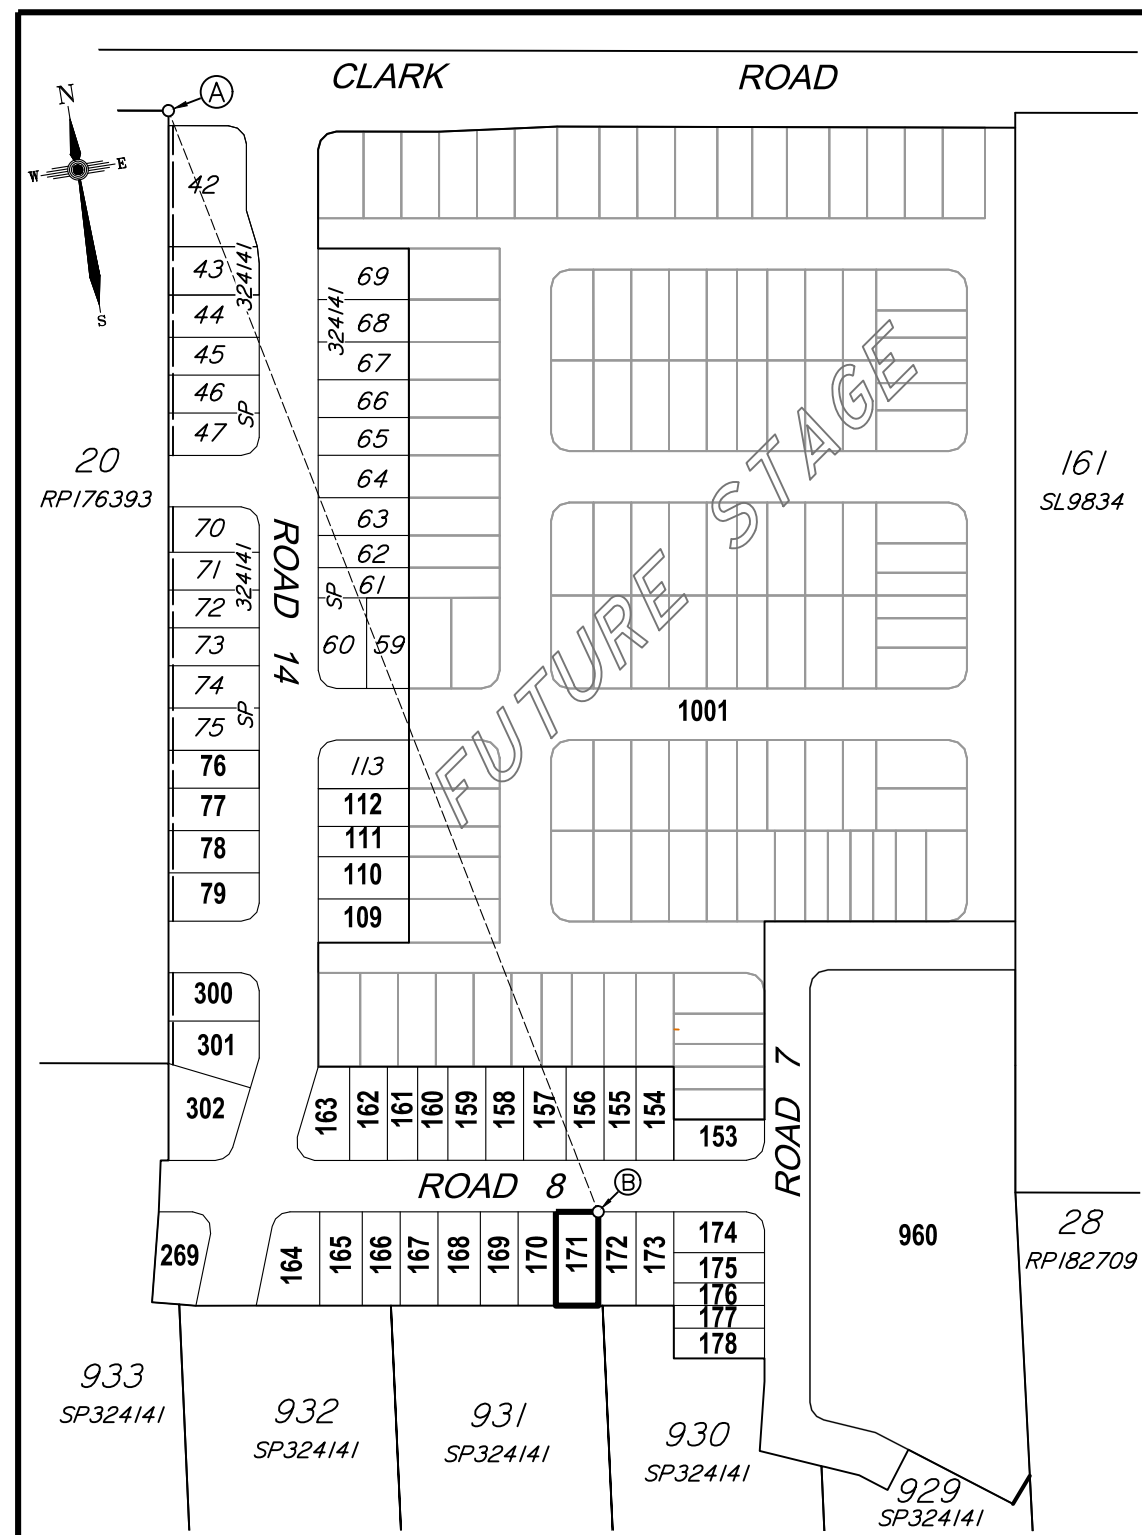

CADASTRAL CONNECTION

A - B 167°38'40" 390.808

Scale 1:2500 - Lengths are in Metres.

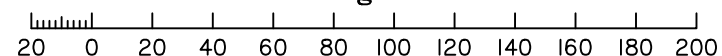

Disclosure Plan

**Summerstone Estate,
Morayfield**

PROPOSED STAGE 2
ALLOTMENTS 76-79, 109-112, 153-178
& 300-302

Cancelling Lot 1000 on SP324141
(Formally Lots 21-24 on RP176393)

PROPOSED LOT 171

DETAIL SURVEY COMPLETED BY LSD
26/06/2021.
ENGINEERING DESIGN BY GREEN-
HAVEN PROJECTS.
ANY FILLING ON THIS LOT IS TO BE
COMPLETED TO LEVEL ONE
SUPERVISION AND TESTING IN
ACCORDANCE WITH THE
REQUIREMENTS OF AS 3798-2007
"GUIDELINES ON EARTHWORKS FOR
COMMERCIAL AND RESIDENTIAL
DEVELOPMENTS".

Revisions	Surveyed	Drawn	Checked	Passed	Date

A ORIGINAL PLAN LSD LA MH LS 20/07/21



PO Box 6334, Maroochydore BC QLD 4558
10/1 Newspaper Place, Maroochydore QLD 4558
Mobile: 0412 666 516
Email: mail@landsurveyingdynamics.com
Web: www.landsurveyingdynamics.com
Land Surveying Dynamics (LSD) Pty Ltd
ACN 154 593 670

Signed
Cadastral Surveyor/Director
Date 20/7/2021

Horiz. Datum MGA20 Z56
Origin GNSS CORS

Vert. Datum AHD
Origin PSM 42642
RL 25.417 AHD


Locality: Morayfield

Local Government: Moreton Bay R.C.


Scale
SHEET 1 OF 1 **As shown at A3**

COMPUTER FILE 12244-DIS
DRAWING NUMBER

12116-DIS-171 REV. **A**

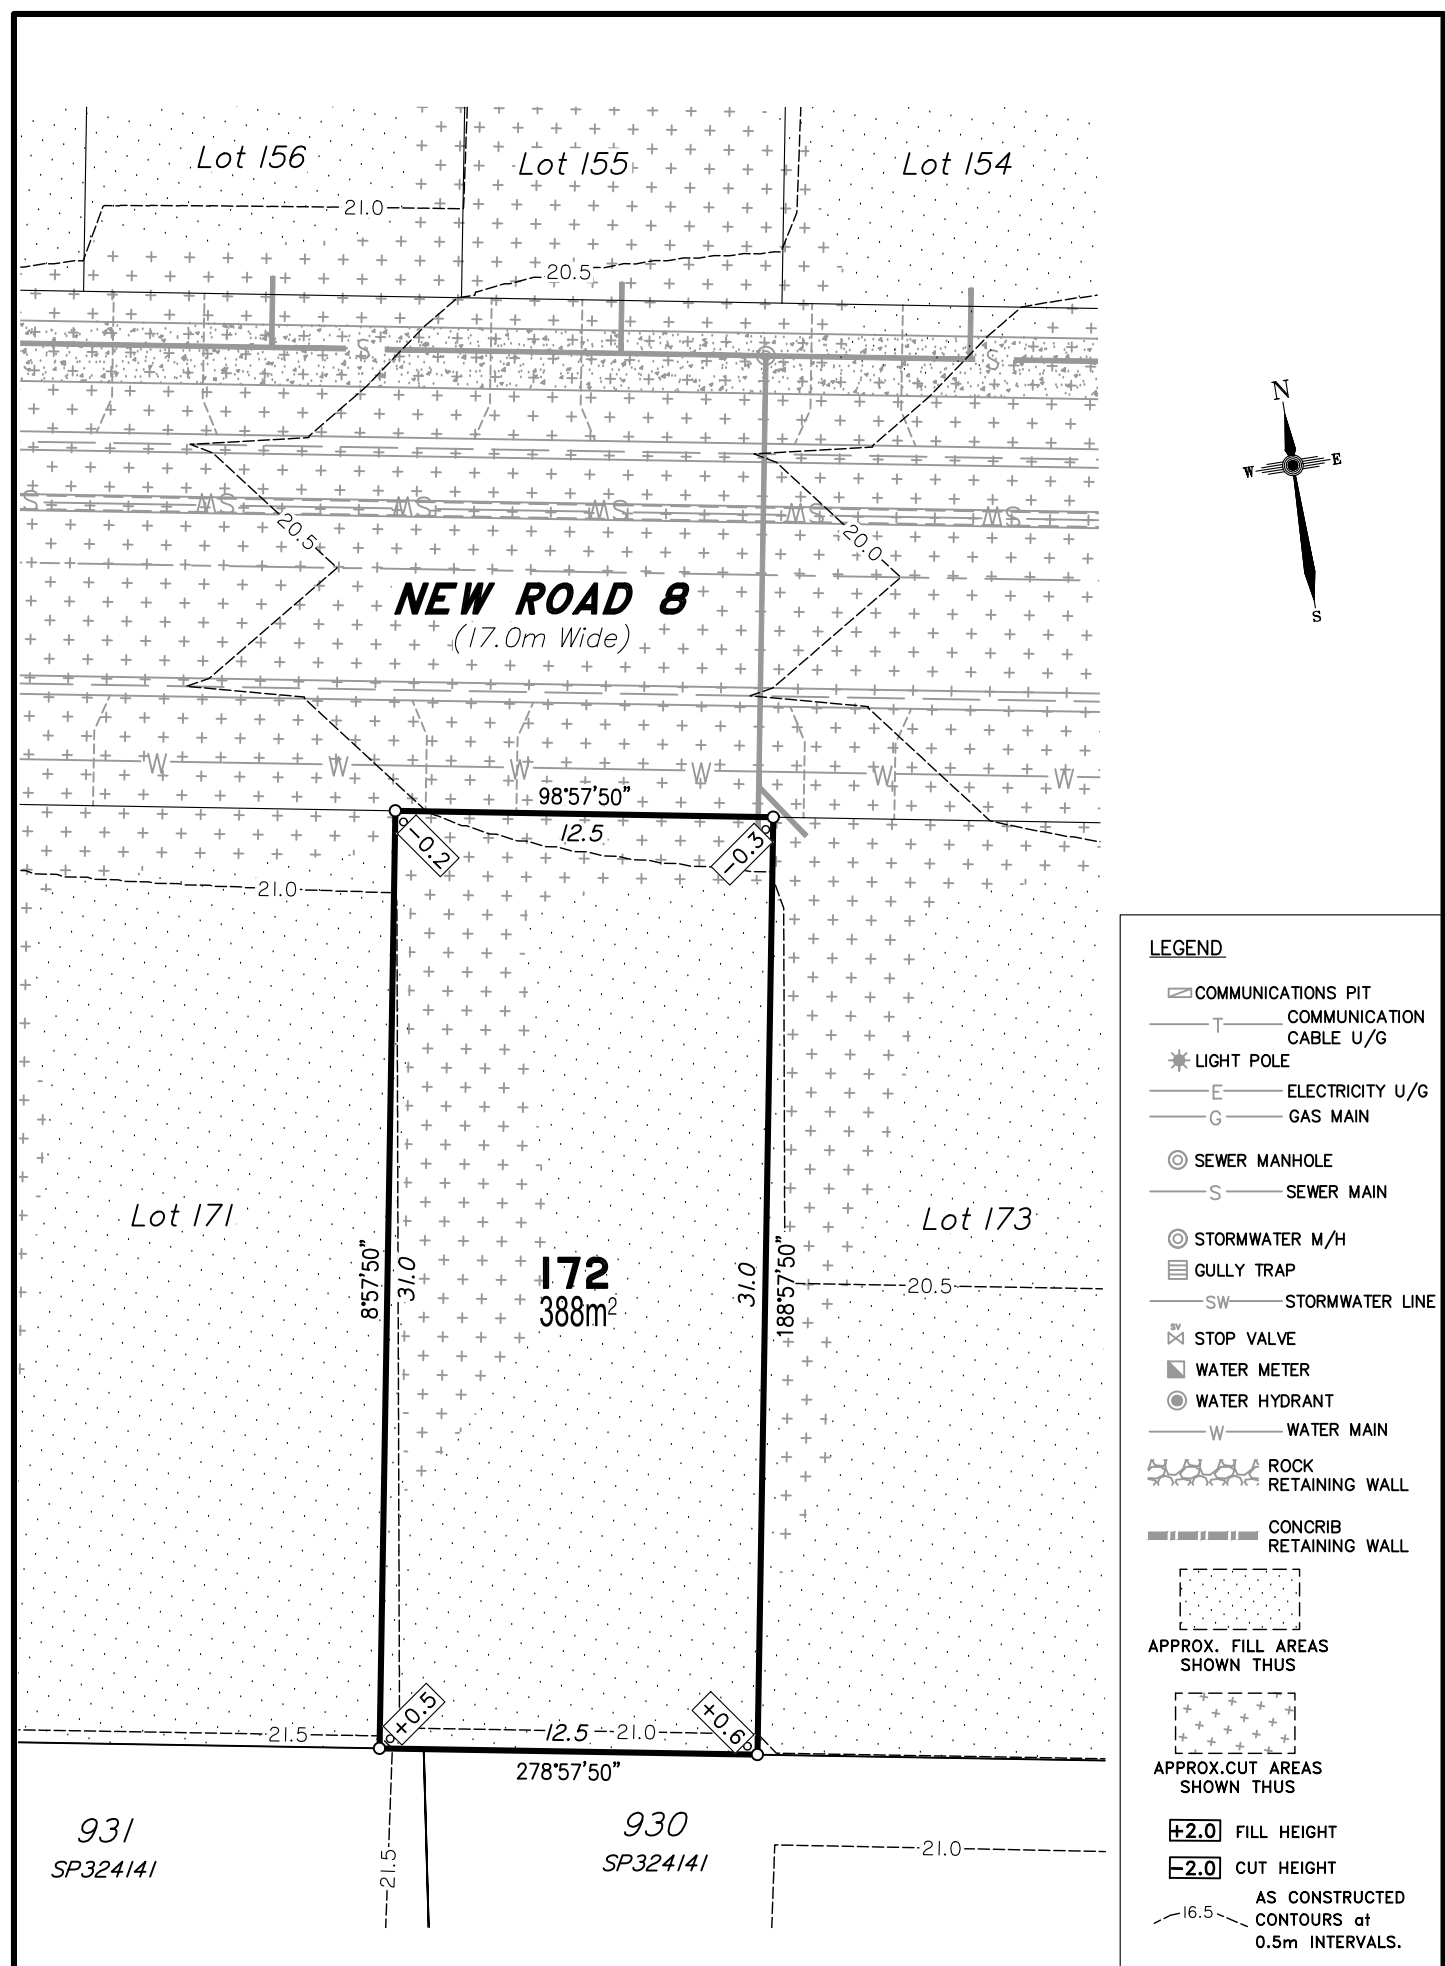


Scale 1:250 - Lengths are in Metres.

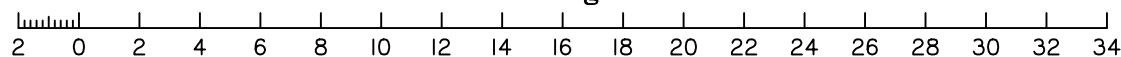

DISCLOSURE PLAN
FOR PROPOSED ALLOTMENT 172
Dated 20th July 2021

This plan shows details of Proposed Allotment 172 on the Proposal Plan 12244-PRO-17 Rev G dated 14/12/2020, which complies with the Development Approval DA/34253/2017/V3RL dated 17th February 2021, approved by Moreton Bay Regional Council, subject to conditions, and associated Judgment by the Planning and Environment Court (1987 of 2018).


The description of the proposed allotment 172, is as part of Lot 1000 on SP324141 (Formally lots 21-24 on RP176393), and situated at Clark Road, Morayfield, commencing at an initial point (A) being the north eastern most point of Lot 20 on RP176393 and thence bounding off on a bearing of 167°38'40" and a distance of 390.808m to point (B) at proposed allotment 172, and containing an area of 388 square metres, more or less.

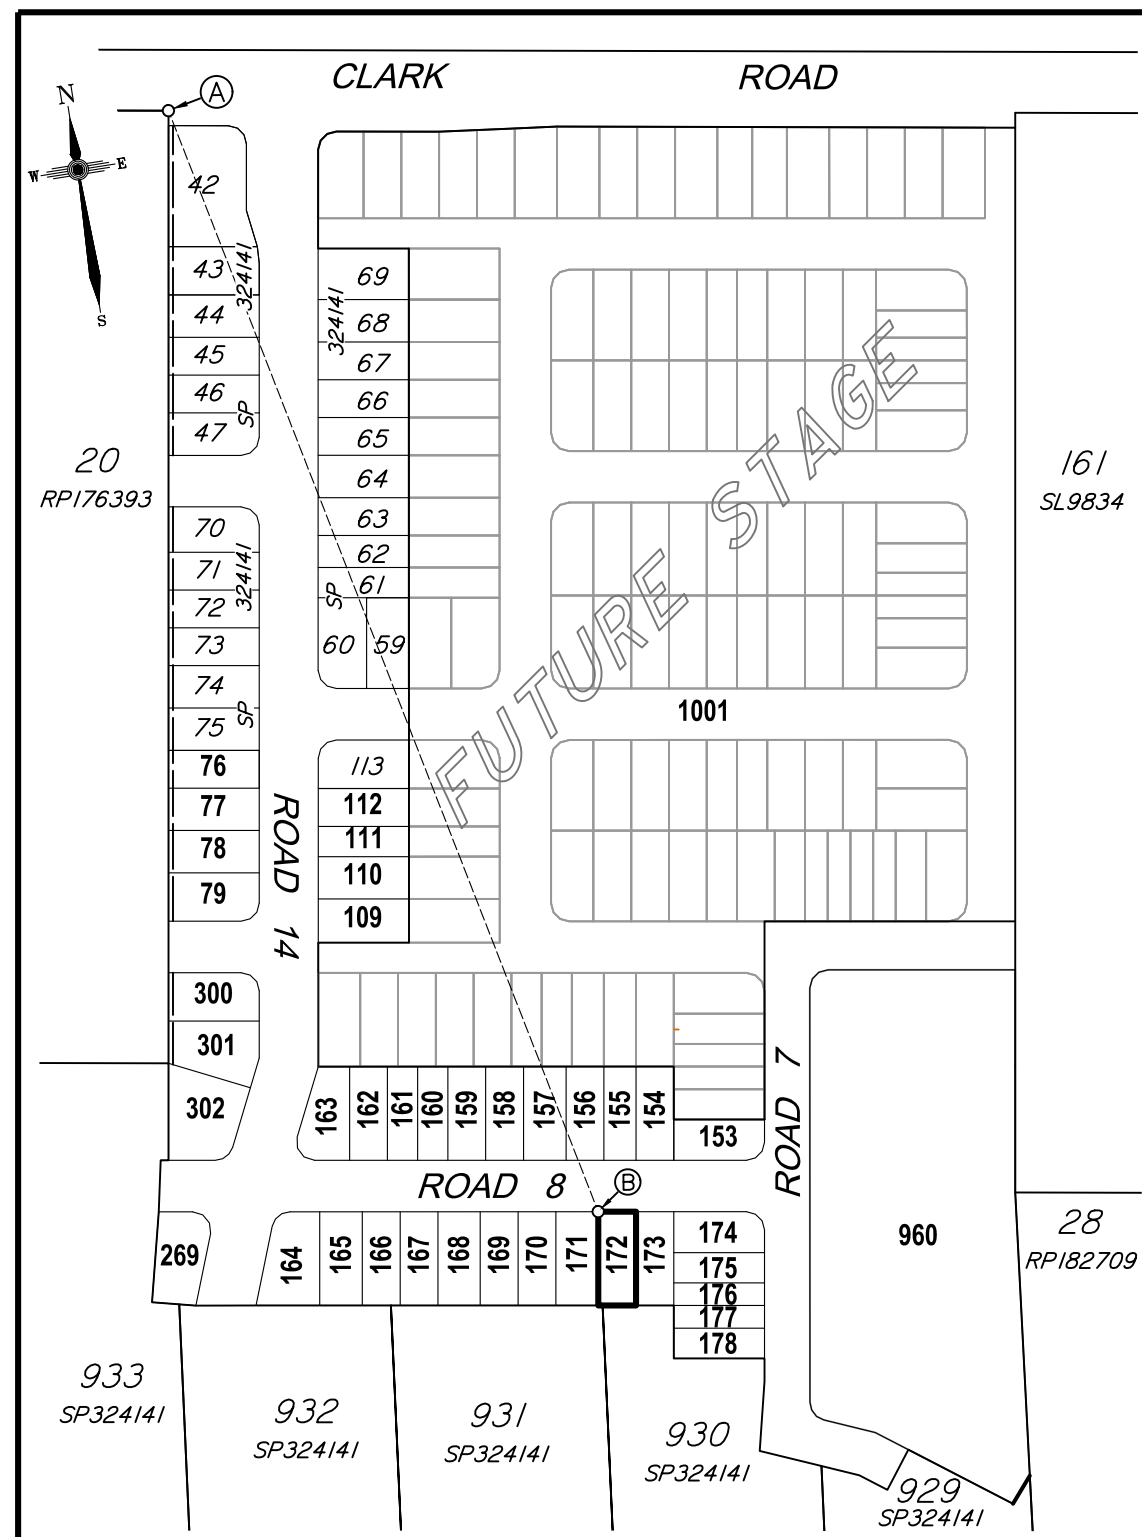

CADASTRAL CONNECTION

A - B 167°38'40" 390.808

Scale 1:2500 - Lengths are in Metres.

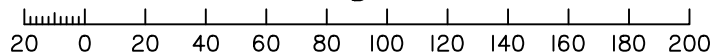

Disclosure Plan

**Summerstone Estate,
Morayfield**

PROPOSED STAGE 2
ALLOTMENTS 76-79, 109-112, 153-178
& 300-302
Cancelling Lot 1000 on SP324141
(Formally Lots 21-24 on RP176393)
PROPOSED LOT 172

DETAIL SURVEY COMPLETED BY LSD
26/06/2021.
ENGINEERING DESIGN BY GREEN-
HAVEN PROJECTS.
ANY FILLING ON THIS LOT IS TO BE
COMPLETED TO LEVEL ONE
SUPERVISION AND TESTING IN
ACCORDANCE WITH THE
REQUIREMENTS OF AS 3798-2007
"GUIDELINES ON EARTHWORKS FOR
COMMERCIAL AND RESIDENTIAL
DEVELOPMENTS".

Revisions	Surveyed	Drawn	Checked	Passed	Date
A ORIGINAL PLAN	LSD	LA	MH	LS	20/07/21



PO Box 6334, Maroochydore BC QLD 4558
10/1 Newspaper Place, Maroochydore QLD 4558
Mobile: 0412 666 516
Email: mail@landsurveyingdynamics.com
Web: www.landsurveyingdynamics.com
Land Surveying Dynamics (LSD) Pty Ltd
ACN 154 593 670


Signed
Cadastral Surveyor/Director
Date 20/7/2021

Horiz. Datum MGA20 Z56
Origin GNSS CORS

Vert. Datum AHD
Origin PSM 42642
RL 25.417 AHD

Locality: Morayfield
Local Government: Moreton Bay R.C.


SHEET 1 OF 1
COMPUTER FILE 12244-DIS
DRAWING NUMBER
12116-DIS-172
Scale
As shown at A3
REV.
A

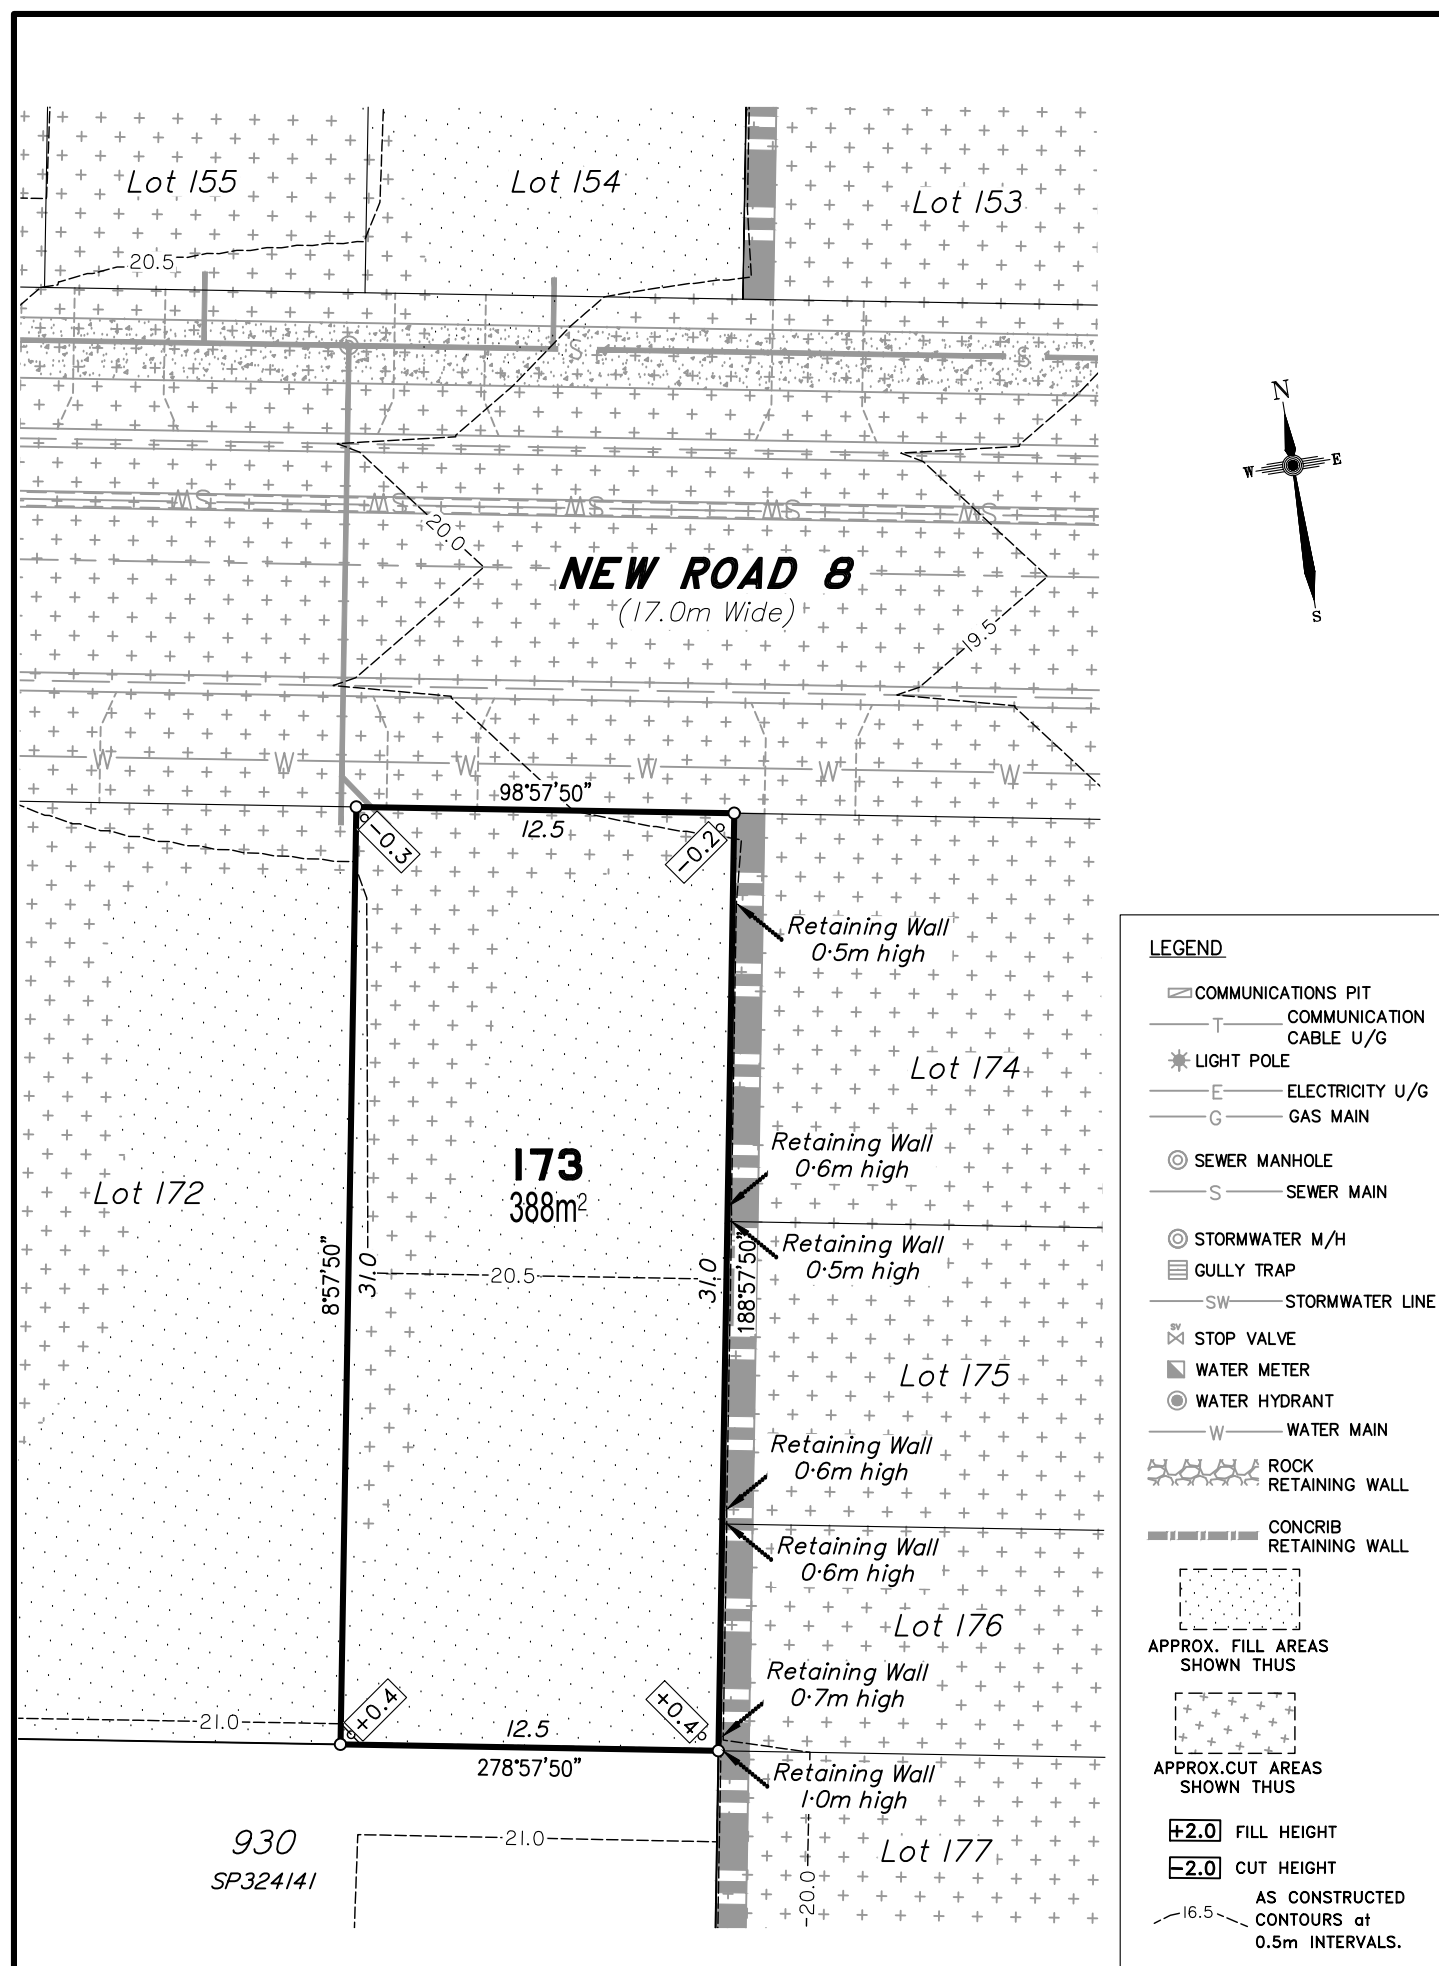

DISCLOSURE PLAN
FOR PROPOSED ALLOTMENT 173
Dated 20th July 2021

This plan shows details of Proposed Allotment 173 on the Proposal Plan 12244-PRO-17 Rev G dated 14/12/2020, which complies with the Development Approval DA/34253/2017/V3RL dated 17th February 2021, approved by Moreton Bay Regional Council, subject to conditions, and associated Judgment by the Planning and Environment Court (1987 of 2018).

The description of the proposed allotment 173, is as part of Lot 1000 on SP324141 (Formally lots 21-24 on RP176393), and situated at Clark Road, Morayfield, commencing at an initial point (A) being the north eastern most point of Lot 20 on RP176393 and thence bounding off on a bearing of 164°18'40" and a distance of 400.575m to point (B) at proposed allotment 173, and containing an area of 388 square metres, more or less.

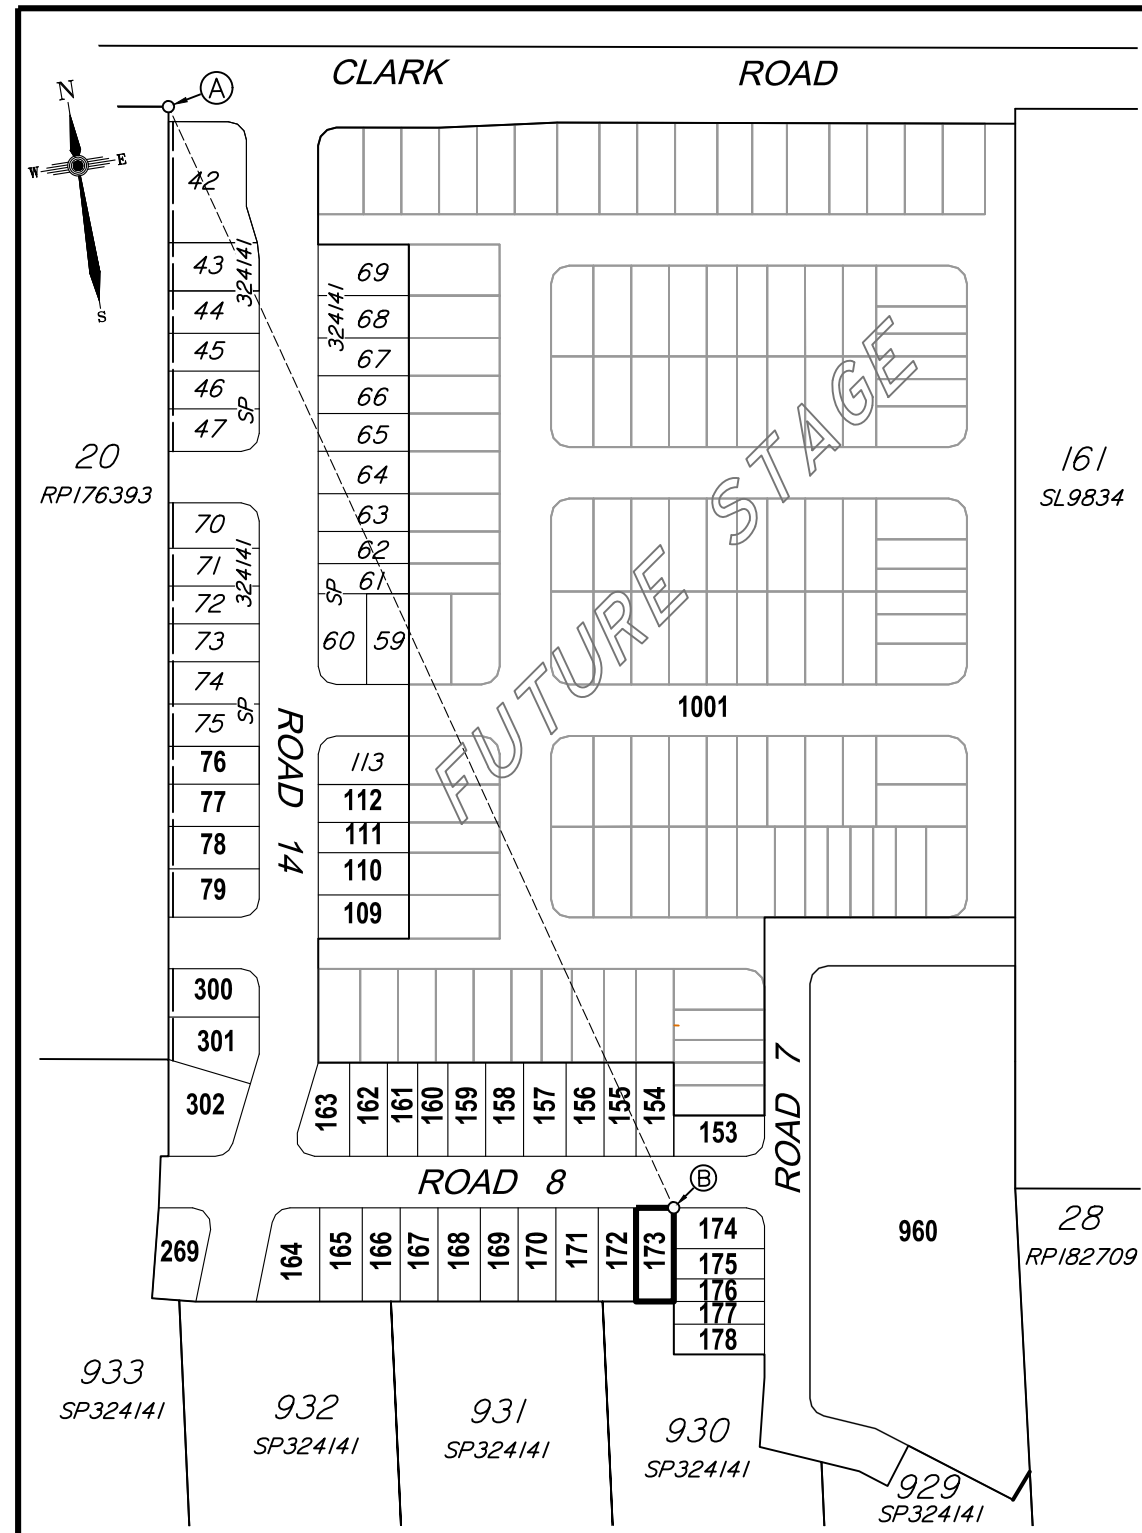

Disclosure Plan
Summerstone Estate,
Morayfield

PROPOSED STAGE 2
ALLOTMENTS 76-79, 109-112, 153-178
& 300-302
Cancelling Lot 1000 on SP324141
(Formally Lots 21-24 on RP176393)
PROPOSED LOT 173

DETAIL SURVEY COMPLETED BY LSD 26/06/2021.
ENGINEERING DESIGN BY GREEN-HAVEN PROJECTS.
ANY FILLING ON THIS LOT IS TO BE COMPLETED TO LEVEL ONE SUPERVISION AND TESTING IN ACCORDANCE WITH THE REQUIREMENTS OF AS 3798-2007 "GUIDELINES ON EARTHWORKS FOR COMMERCIAL AND RESIDENTIAL DEVELOPMENTS".

Revisions	Surveyed	Drawn	Checked	Passed	Date

A ORIGINAL PLAN LSD LA MH LS 20/07/21



PO Box 6334, Maroochydore BC QLD 4558
10/1 Newspaper Place, Maroochydore QLD 4558
Mobile: 0412 666 516
Email: mail@landsurveyingdynamics.com
Web: www.landsurveyingdynamics.com
Land Surveying Dynamics (LSD) Pty Ltd
ACN 154 593 670



Signed
Cadastral Surveyor/Director
Date 20/7/2021

Horiz. Datum MGA20 Z56
Origin GNSS CORS

Vert. Datum AHD
Origin PSM 42642
RL 25.417 AHD

Locality: Morayfield
Local Government: Moreton Bay R.C.



Scale
SHEET 1 OF 1 **As shown at A3**
COMPUTER FILE 12244-DIS
DRAWING NUMBER **12116-DIS-173** REV. **A**

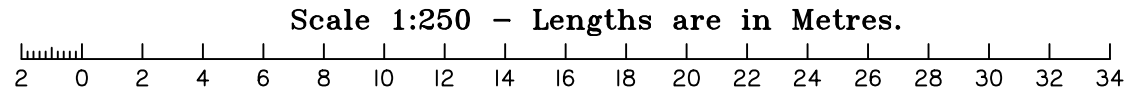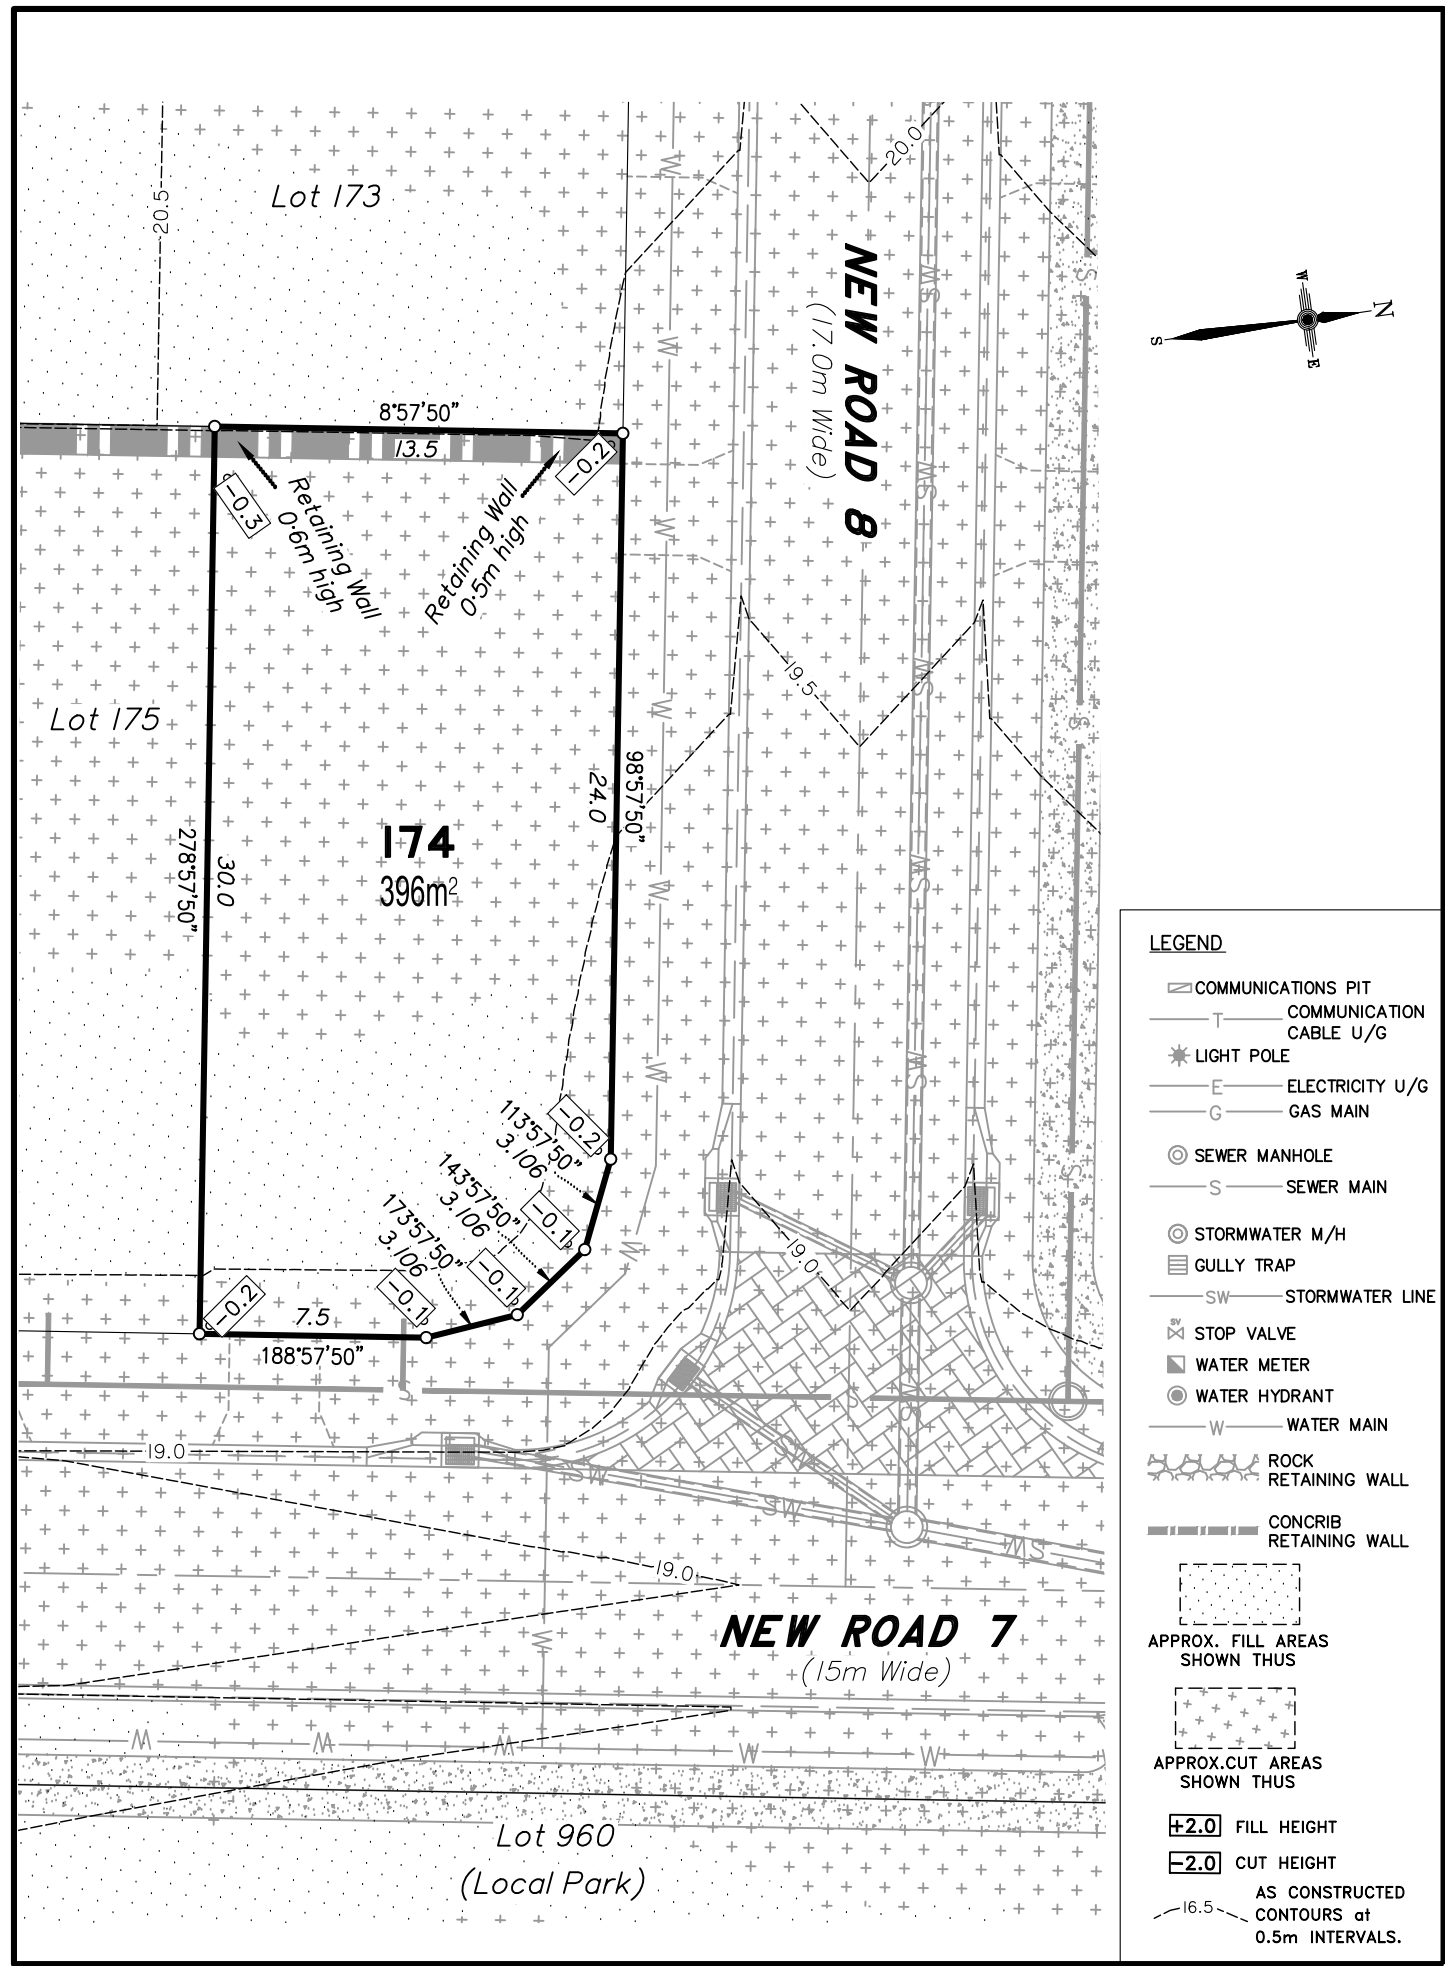

DISCLOSURE PLAN
FOR PROPOSED ALLOTMENT 174
Dated 20th July 2021

This plan shows details of Proposed Allotment 174 on the Proposal Plan 12244-PRO-17 Rev G dated 14/12/2020, which complies with the Development Approval DA/34253/2017/V3RL dated 17th February 2021, approved by Moreton Bay Regional Council, subject to conditions, and associated Judgment by the Planning and Environment Court (1987 of 2018).

The description of the proposed allotment 174, is as part of Lot 1000 on SP324141 (Formally lots 21-24 on RP176393), and situated at Clark Road, Morayfield, commencing at an initial point (A) being the north eastern most point of Lot 20 on RP176393 and thence bounding off on a bearing of 164°18'40" and a distance of 400.575m to point (B) at proposed allotment 174, and containing an area of 396 square metres, more or less.

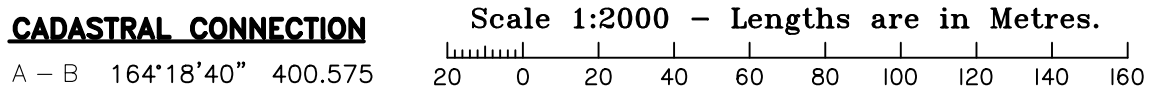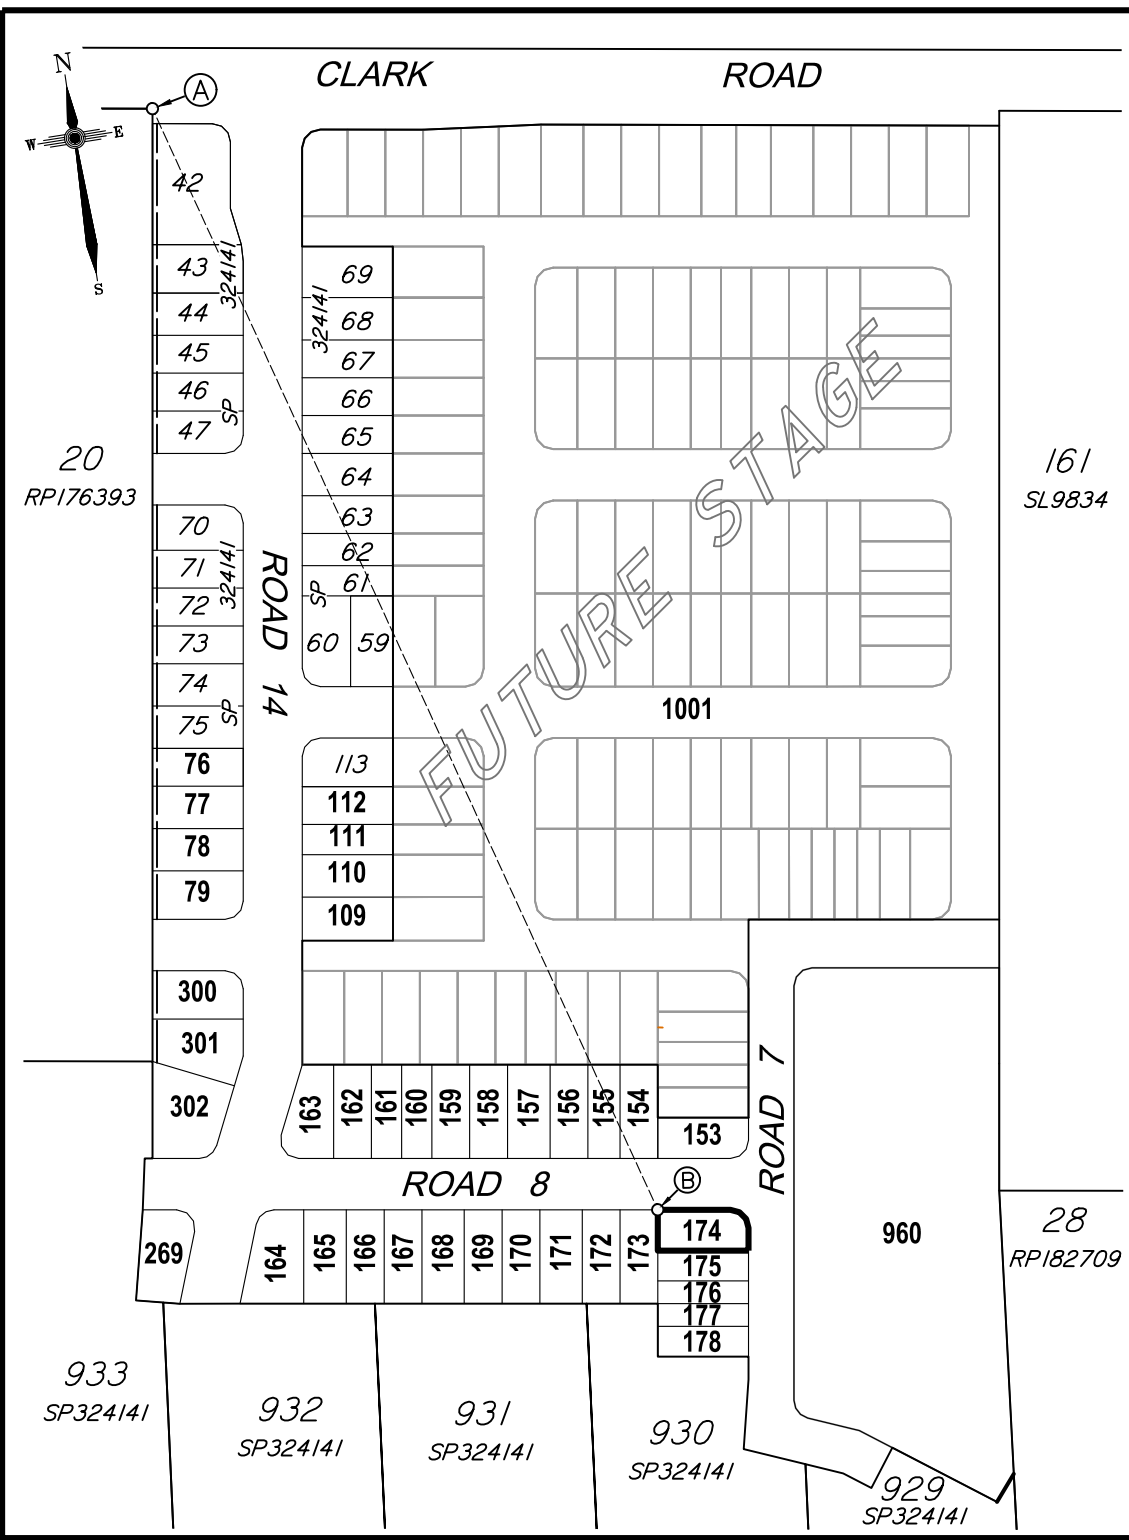

Disclosure Plan
Summerstone Estate,
Morayfield
PROPOSED STAGE 2
ALLOTMENTS 76-79, 109-112, 153-178
& 300-302
Cancelling Lot 1000 on SP324141
(Formally Lots 21-24 on RP176393)
PROPOSED LOT 174


DETAIL SURVEY COMPLETED BY LSD 26/06/2021.
ENGINEERING DESIGN BY GREEN-HAVEN PROJECTS.
ANY FILLING ON THIS LOT IS TO BE COMPLETED TO LEVEL ONE SUPERVISION AND TESTING IN ACCORDANCE WITH THE REQUIREMENTS OF AS 3798-2007 "GUIDELINES ON EARTHWORKS FOR COMMERCIAL AND RESIDENTIAL DEVELOPMENTS".

Revisions	Surveyed	Drawn	Checked	Passed	Date
A ORIGINAL PLAN	LSD	LA	MH	LS	20/07/21

PO Box 6334, Maroochydore BC QLD 4558
10/1 Newspaper Place, Maroochydore QLD 4558
Mobile: 0412 666 516
Email: mail@landsurveyingdynamics.com
Web: www.landsurveyingdynamics.com
Land Surveying Dynamics (LSD) Pty Ltd
ACN 154 593 670

Signed
Cadastral Surveyor/Director
Date 20/7/2021


Horiz. Datum MGA20 Z56
Origin GNSS CORS
Vert. Datum AHD
Origin PSM 42642
RL 25.417 AHD
Locality: Morayfield
Local Government: Moreton Bay R.C.

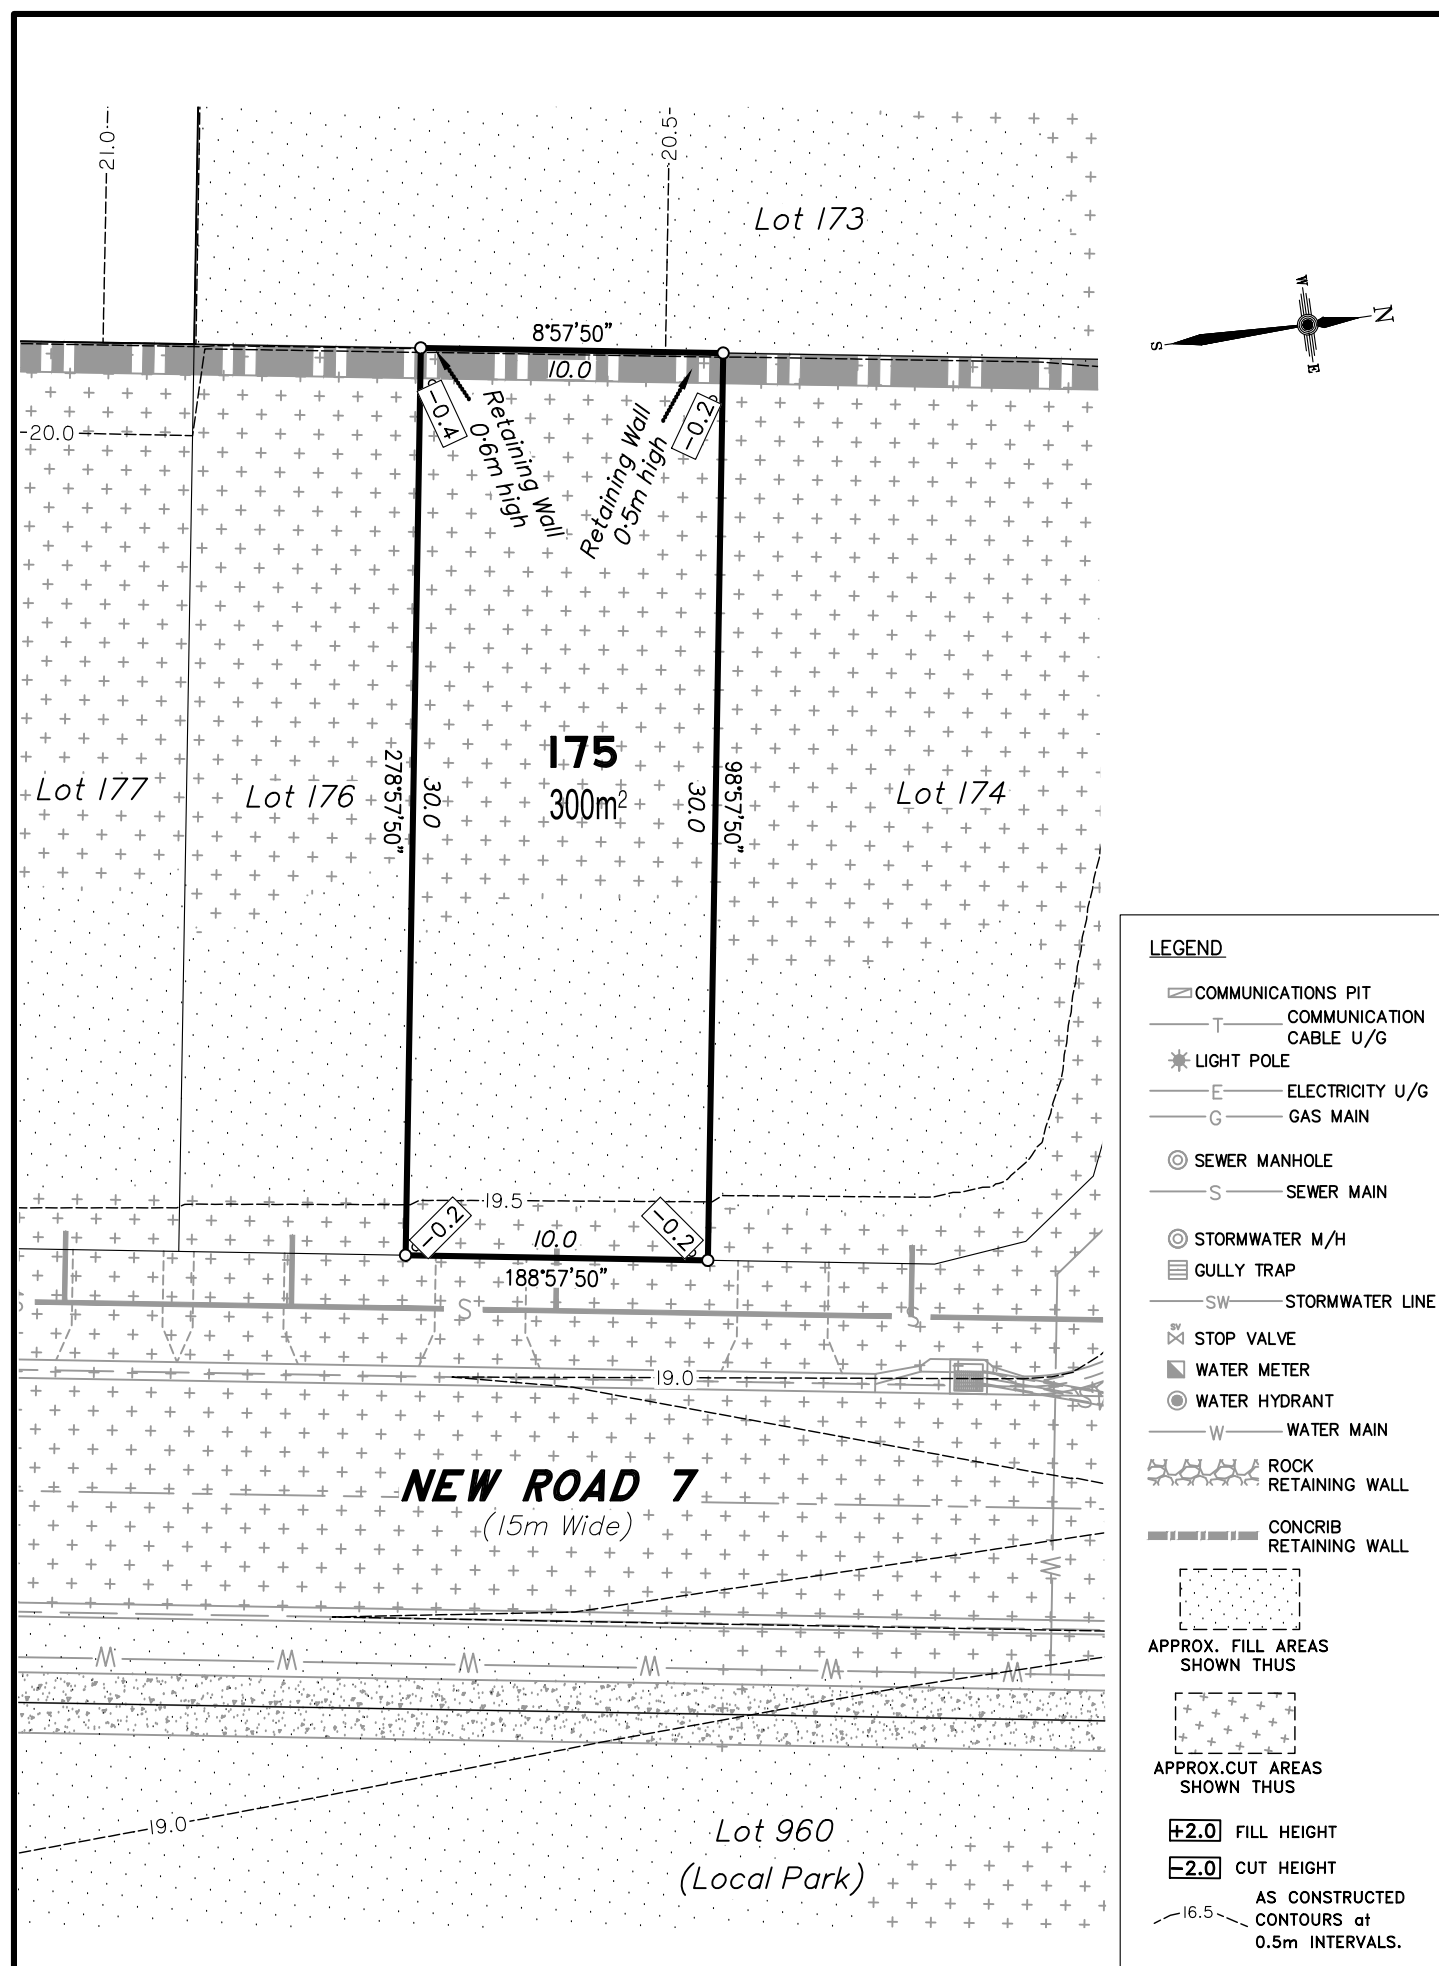

DISCLOSURE PLAN
FOR PROPOSED ALLOTMENT 175
Dated 20th July 2021

This plan shows details of Proposed Allotment 175 on the Proposal Plan 12244-PRO-17 Rev G dated 14/12/2020, which complies with the Development Approval DA/34253/2017/V3RL dated 17th February 2021, approved by Moreton Bay Regional Council, subject to conditions, and associated Judgment by the Planning and Environment Court (1987 of 2018).

The description of the proposed allotment 175, is as part of Lot 1000 on SP324141 (Formally lots 21-24 on RP176393), and situated at Clark Road, Morayfield, commencing at an initial point (A) being the north eastern most point of Lot 20 on RP176393 and thence bounding off on a bearing of 162°00'35" and a distance of 434.797m to point (B) at proposed allotment 175, and containing an area of 300 square metres, more or less.

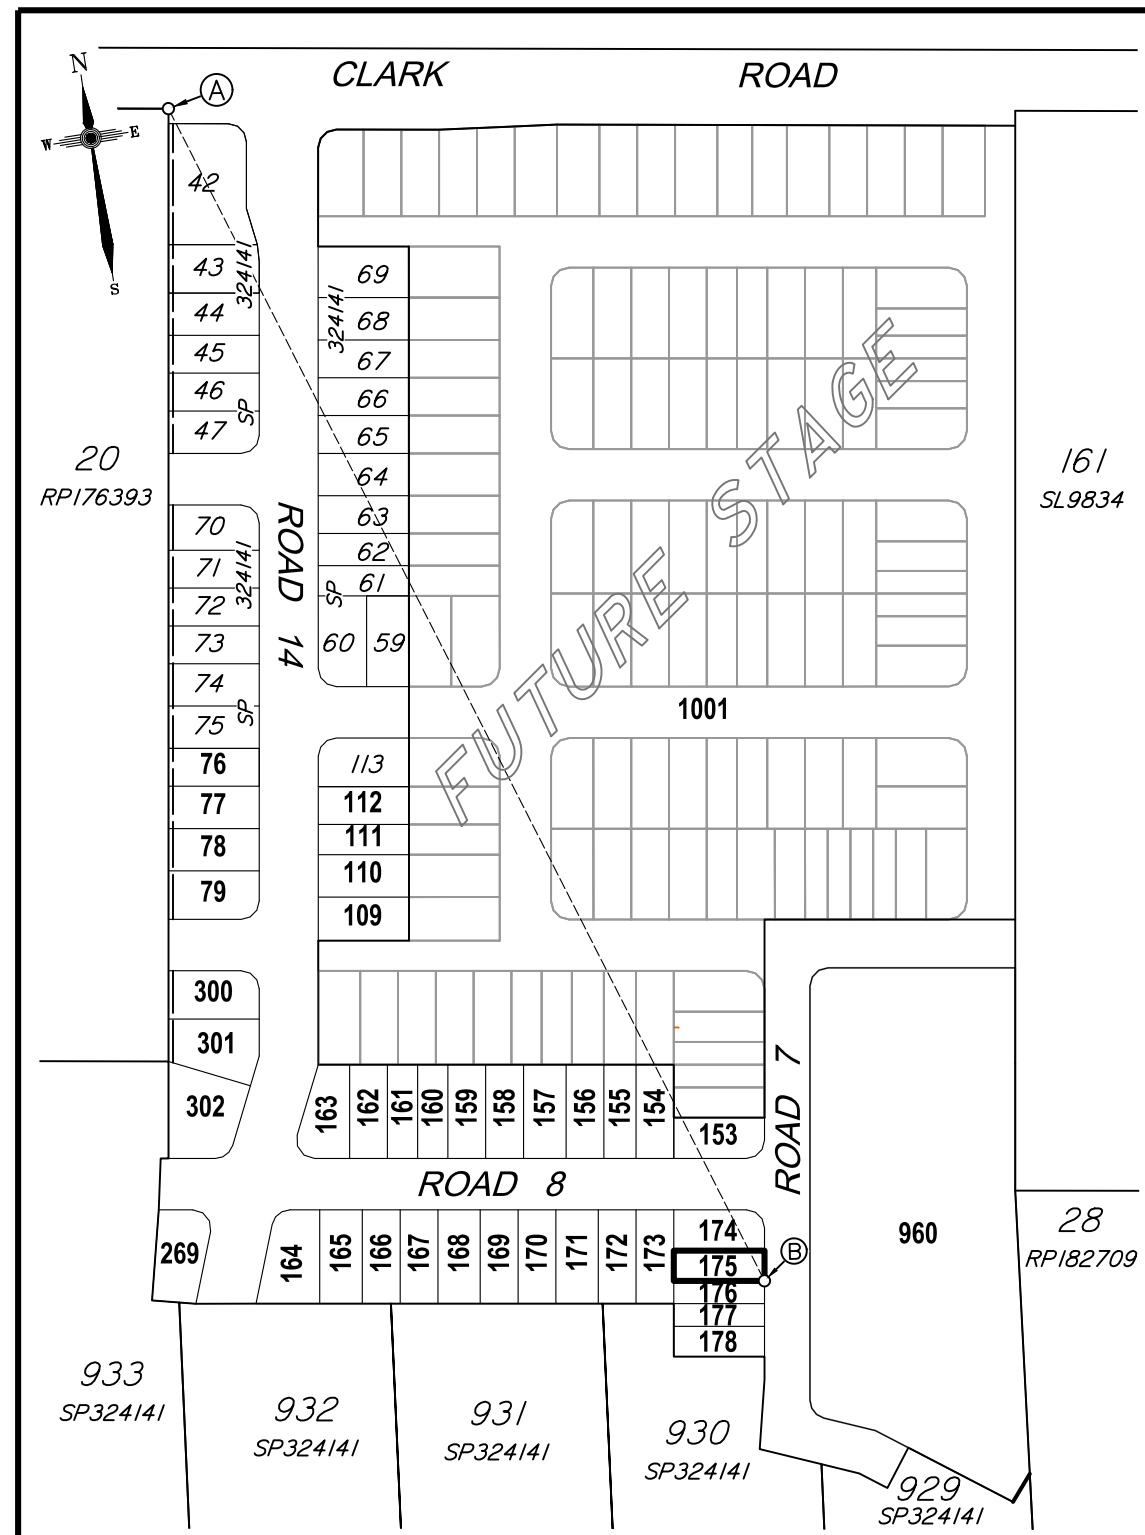

Disclosure Plan
Summerstone Estate,
Morayfield
PROPOSED STAGE 2
ALLOTMENTS 76-79, 109-112, 153-178
& 300-302
Cancelling Lot 1000 on SP324141
(Formally Lots 21-24 on RP176393)
PROPOSED LOT 175

DETAIL SURVEY COMPLETED BY LSD 26/06/2021.
 ENGINEERING DESIGN BY GREEN-HAVEN PROJECTS.
 ANY FILLING ON THIS LOT IS TO BE COMPLETED TO LEVEL ONE SUPERVISION AND TESTING IN ACCORDANCE WITH THE REQUIREMENTS OF AS 3798-2007 "GUIDELINES ON EARTHWORKS FOR COMMERCIAL AND RESIDENTIAL DEVELOPMENTS".

Revisions	Surveyed	Drawn	Checked	Passed	Date
A ORIGINAL PLAN	LSD	LA	MH	LS	20/07/21


PO Box 6334, Maroochydore BC QLD 4558
 10/1 Newspaper Place, Maroochydore QLD 4558
 Mobile: 0412 666 516
 Email: mail@landsurveyingdynamics.com
 Web: www.landsurveyingdynamics.com
 Land Surveying Dynamics (LSD) Pty Ltd
 ACN 154 593 870

Signed
 Cadastral Surveyor/Director
 Date 20/7/2021

Horiz. Datum MGA20 Z56
 Origin GNSS CORS
 Vert. Datum AHD
 Origin PSM 42642
 RL 25.417 AHD
 Locality: Morayfield
 Local Government: Moreton Bay R.C.

Scale **As shown at A3**
 SHEET 1 OF 1
 COMPUTER FILE 12244-DIS
 DRAWING NUMBER **12116-DIS-175**
 REV. **A**


Scale 1:250 - Lengths are in Metres.

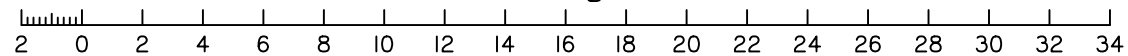


CADASTRAL CONNECTION

A - B 162°00'35" 434.797

Scale 1:2000 - Lengths are in Metres.

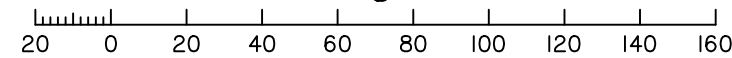

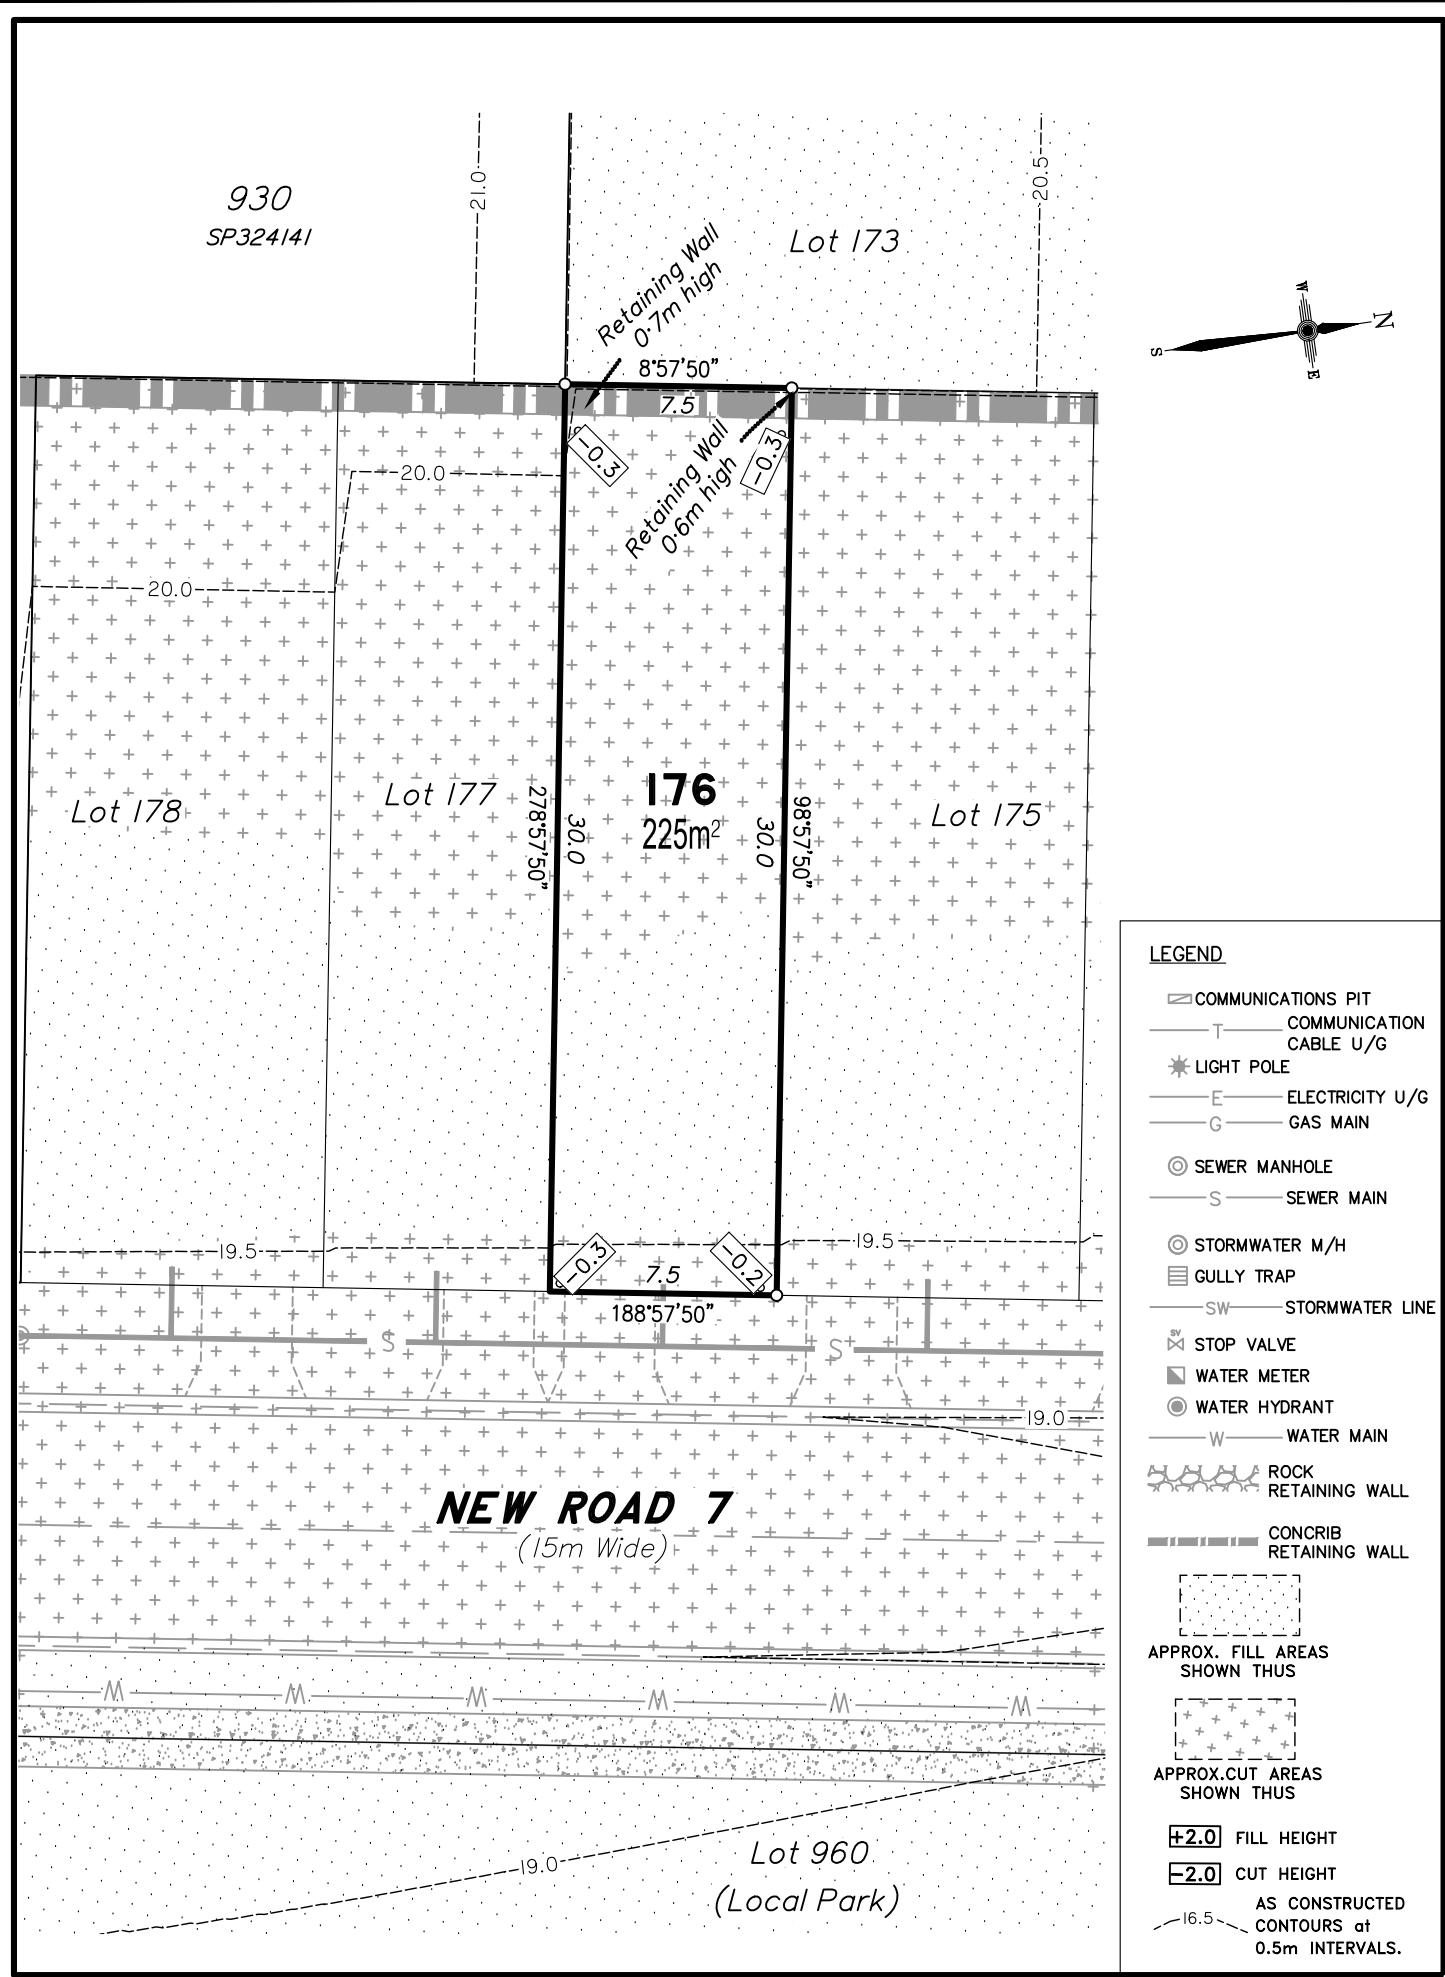



DISCLOSURE PLAN FOR PROPOSED ALLOTMENT 176

Dated 20th July 2021

This plan shows details of Proposed Allotment 176 on the Proposal Plan 12244-PRO-17 Rev G dated 14/12/2020, which complies with the Development Approval DA/34253/2017/V3RL dated 17th February 2021, approved by Moreton Bay Regional Council, subject to conditions, and associated Judgment by the Planning and Environment Court (1987 of 2018).

The description of the proposed allotment 176, is as part of Lot 1000 on SP324141 (Formally lots 21-24 on RP176393), and situated at Clark Road, Morayfield, commencing at an initial point (A) being the north eastern most point of Lot 20 on RP176393 and thence bounding off on a bearing of 162°00'35" and a distance of 434.797m to point (B) at proposed allotment 176, and containing an area of 225 square metres, more or less.

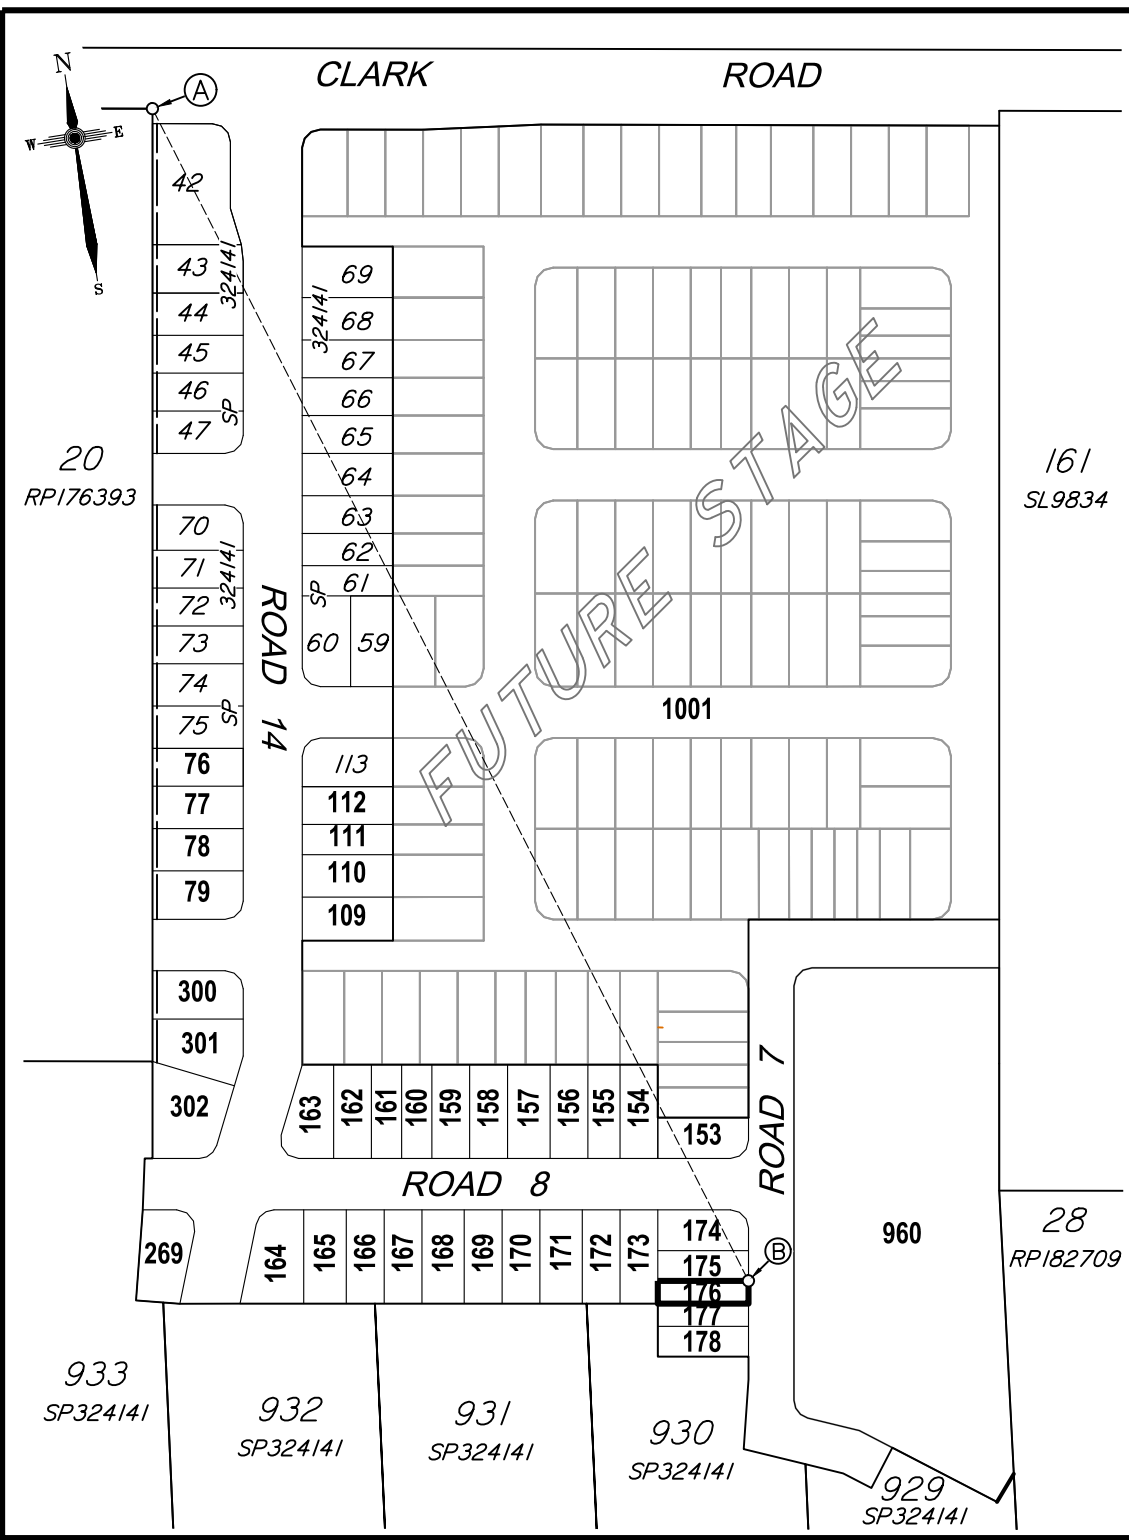


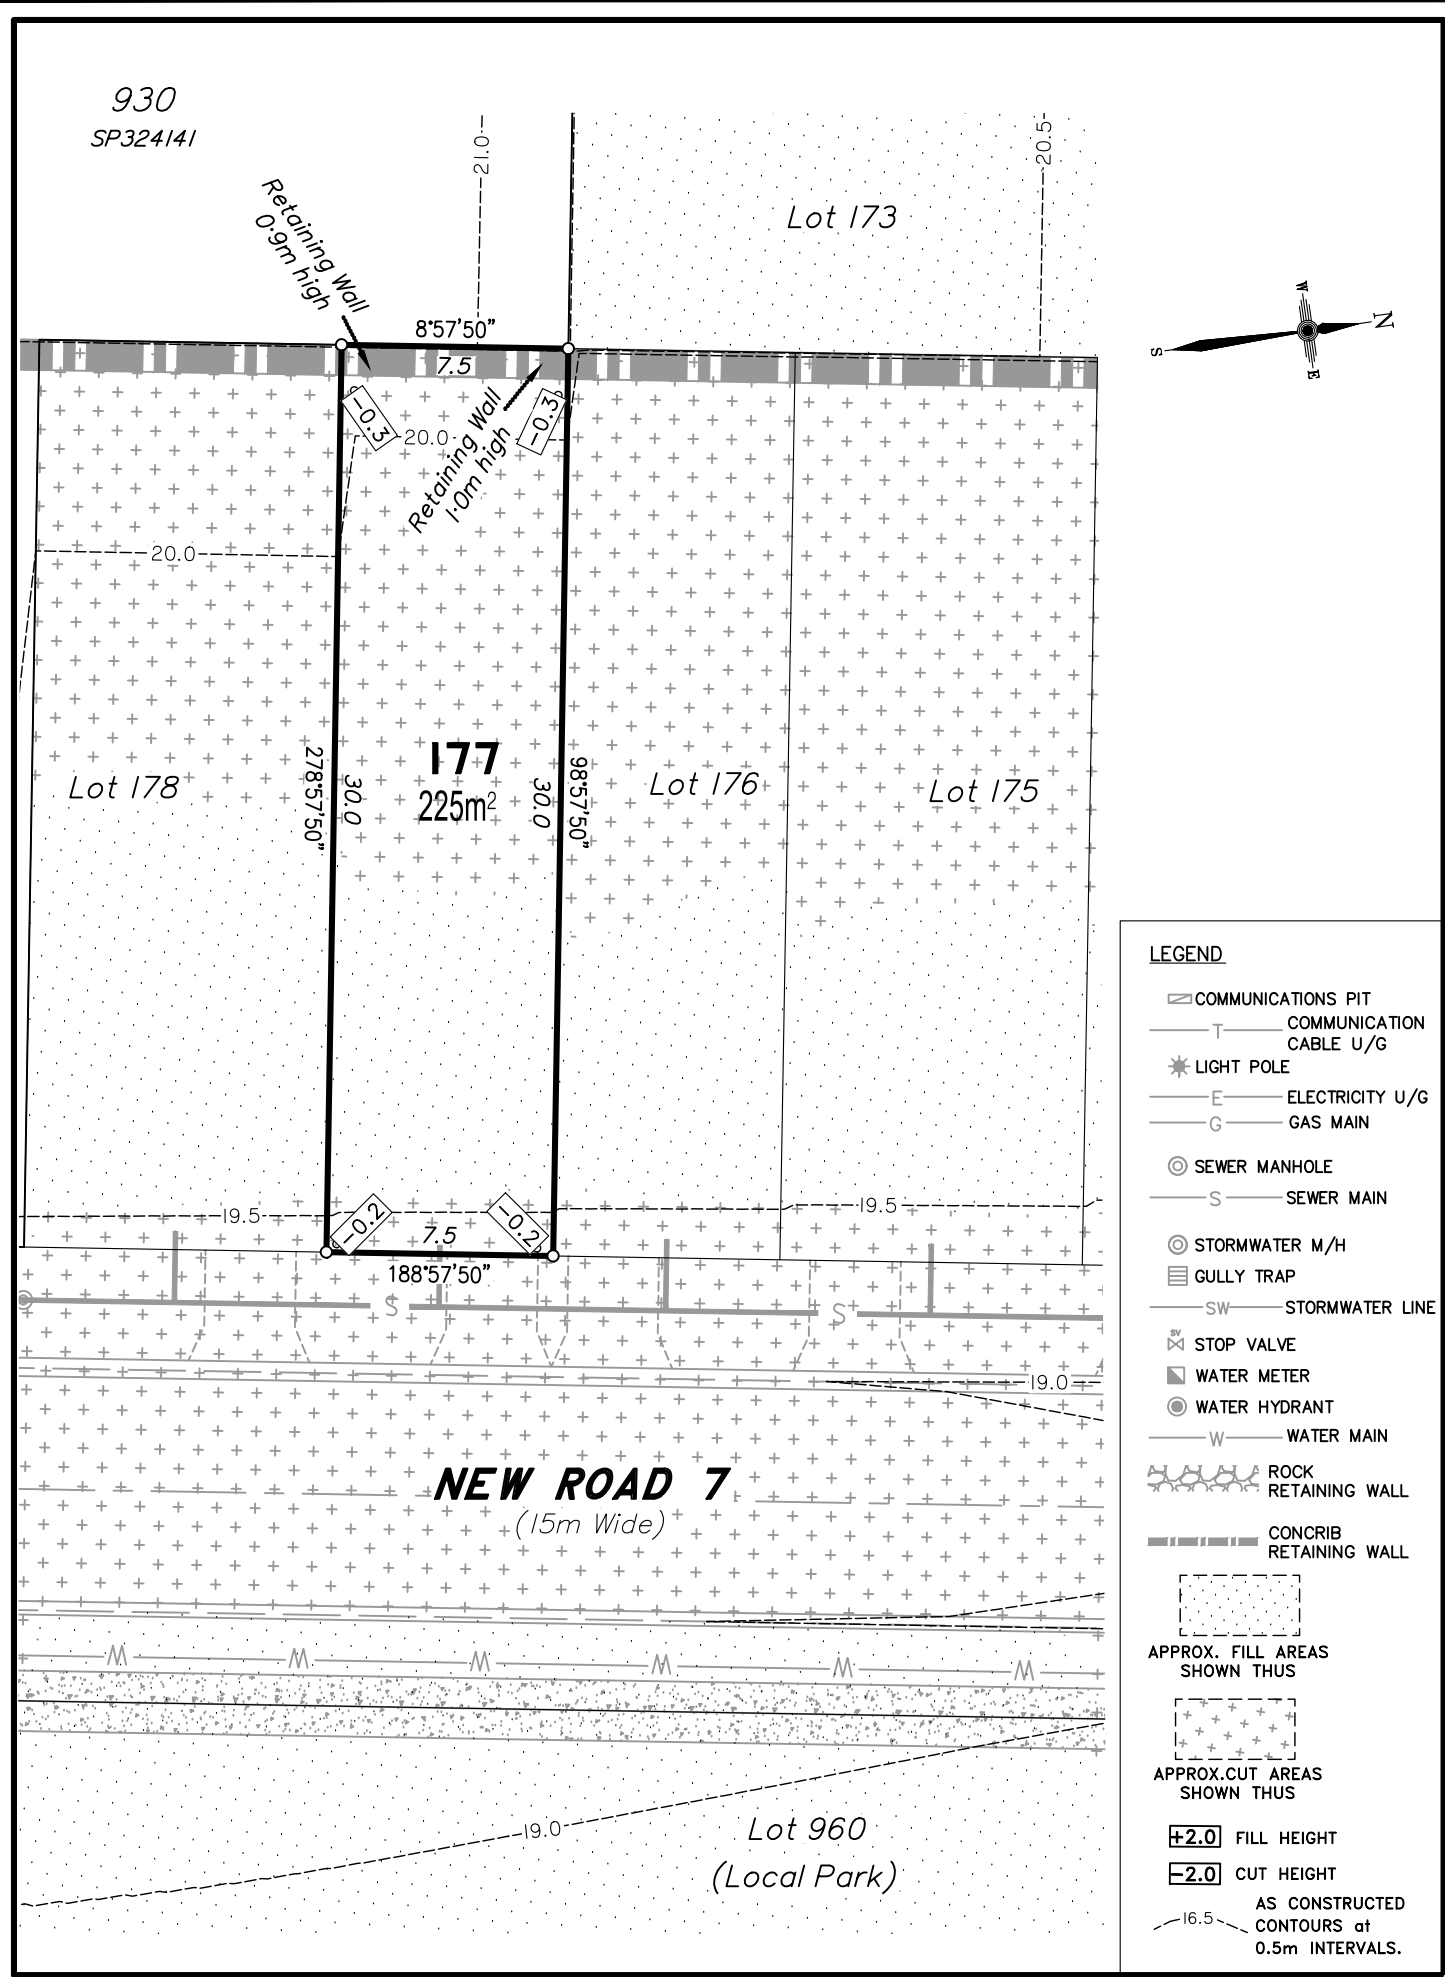

DISCLOSURE PLAN
FOR PROPOSED ALLOTMENT 177
Dated 20th July 2021

This plan shows details of Proposed Allotment 177 on the Proposal Plan 12244-PRO-17 Rev G dated 14/12/2020, which complies with the Development Approval DA/34253/2017/V3RL dated 17th February 2021, approved by Moreton Bay Regional Council, subject to conditions, and associated Judgment by the Planning and Environment Court (1987 of 2018).

The description of the proposed allotment 177, is as part of Lot 1000 on SP324141 (Formally lots 21-24 on RP176393), and situated at Clark Road, Morayfield, commencing at an initial point (A) being the north eastern most point of Lot 20 on RP176393 and thence bounding off on a bearing of 162°52'40" and a distance of 448.219m to point (B) at proposed allotment 177, and containing an area of 225 square metres, more or less.

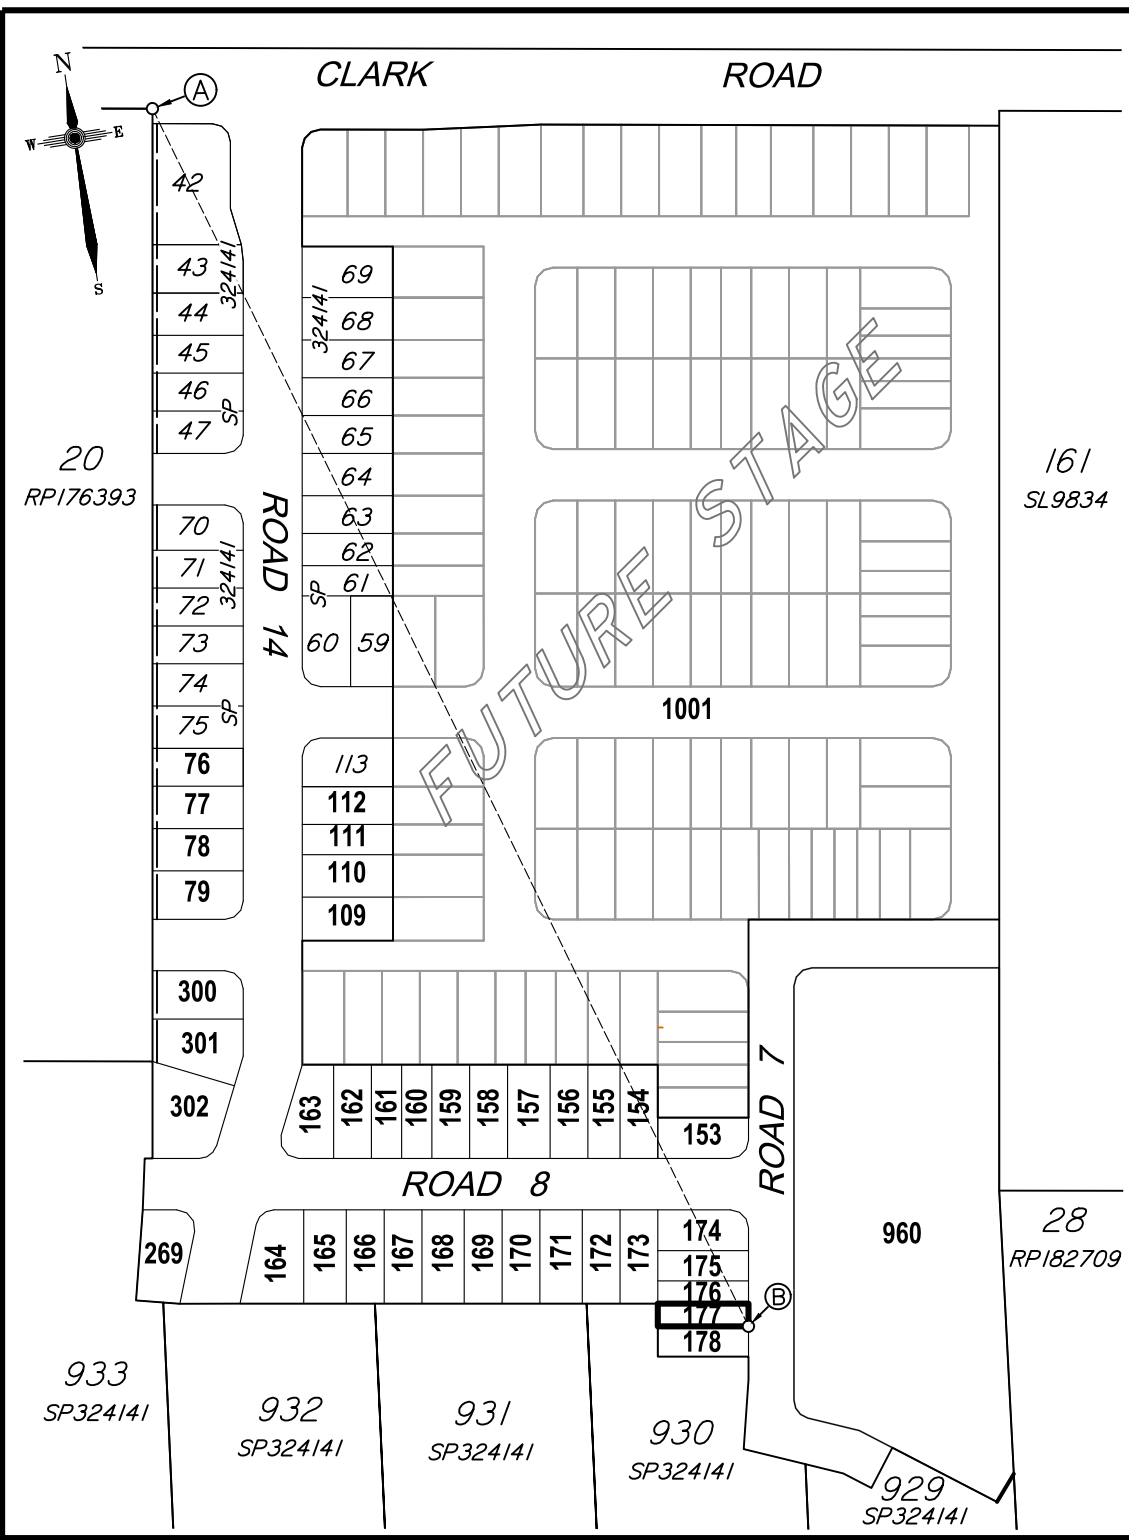

Disclosure Plan
Summerstone Estate,
Morayfield
PROPOSED STAGE 2
ALLOTMENTS 76-79, 109-112, 153-178
& 300-302
Cancelling Lot 1000 on SP324141
(Formally Lots 21-24 on RP176393)
PROPOSED LOT 177



DETAIL SURVEY COMPLETED BY LSD 26/06/2021.
 ENGINEERING DESIGN BY GREEN-HAVEN PROJECTS.
 ANY FILLING ON THIS LOT IS TO BE COMPLETED TO LEVEL ONE SUPERVISION AND TESTING IN ACCORDANCE WITH THE REQUIREMENTS OF AS 3798-2007 "GUIDELINES ON EARTHWORKS FOR COMMERCIAL AND RESIDENTIAL DEVELOPMENTS".


Revisions	Surveyed	Drawn	Checked	Passed	Date
A ORIGINAL PLAN	LSD	LA	MH	LS	20/07/21

PO Box 6334, Maroochydore BC QLD 4558
 10/1 Newspaper Place, Maroochydore QLD 4558
 Mobile: 0412 666 516
 Email: mail@landsurveyingdynamics.com
 Web: www.landsurveyingdynamics.com
 Land Surveying Dynamics (LSD) Pty Ltd
 ACN 154 593 870

Signed
 Cadastral Surveyor/Director
 Date 20/7/2021

Horiz. Datum MGA20 Z56
 Origin GNSS CORS
 Vert. Datum AHD
 Origin PSM 42642
 RL 25.417 AHD
 Locality: Morayfield
 Local Government: Moreton Bay R.C.

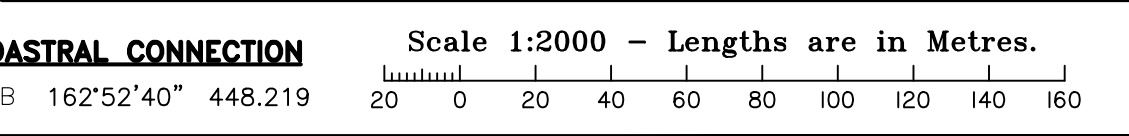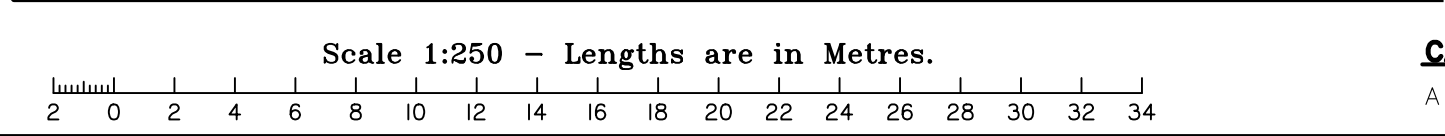


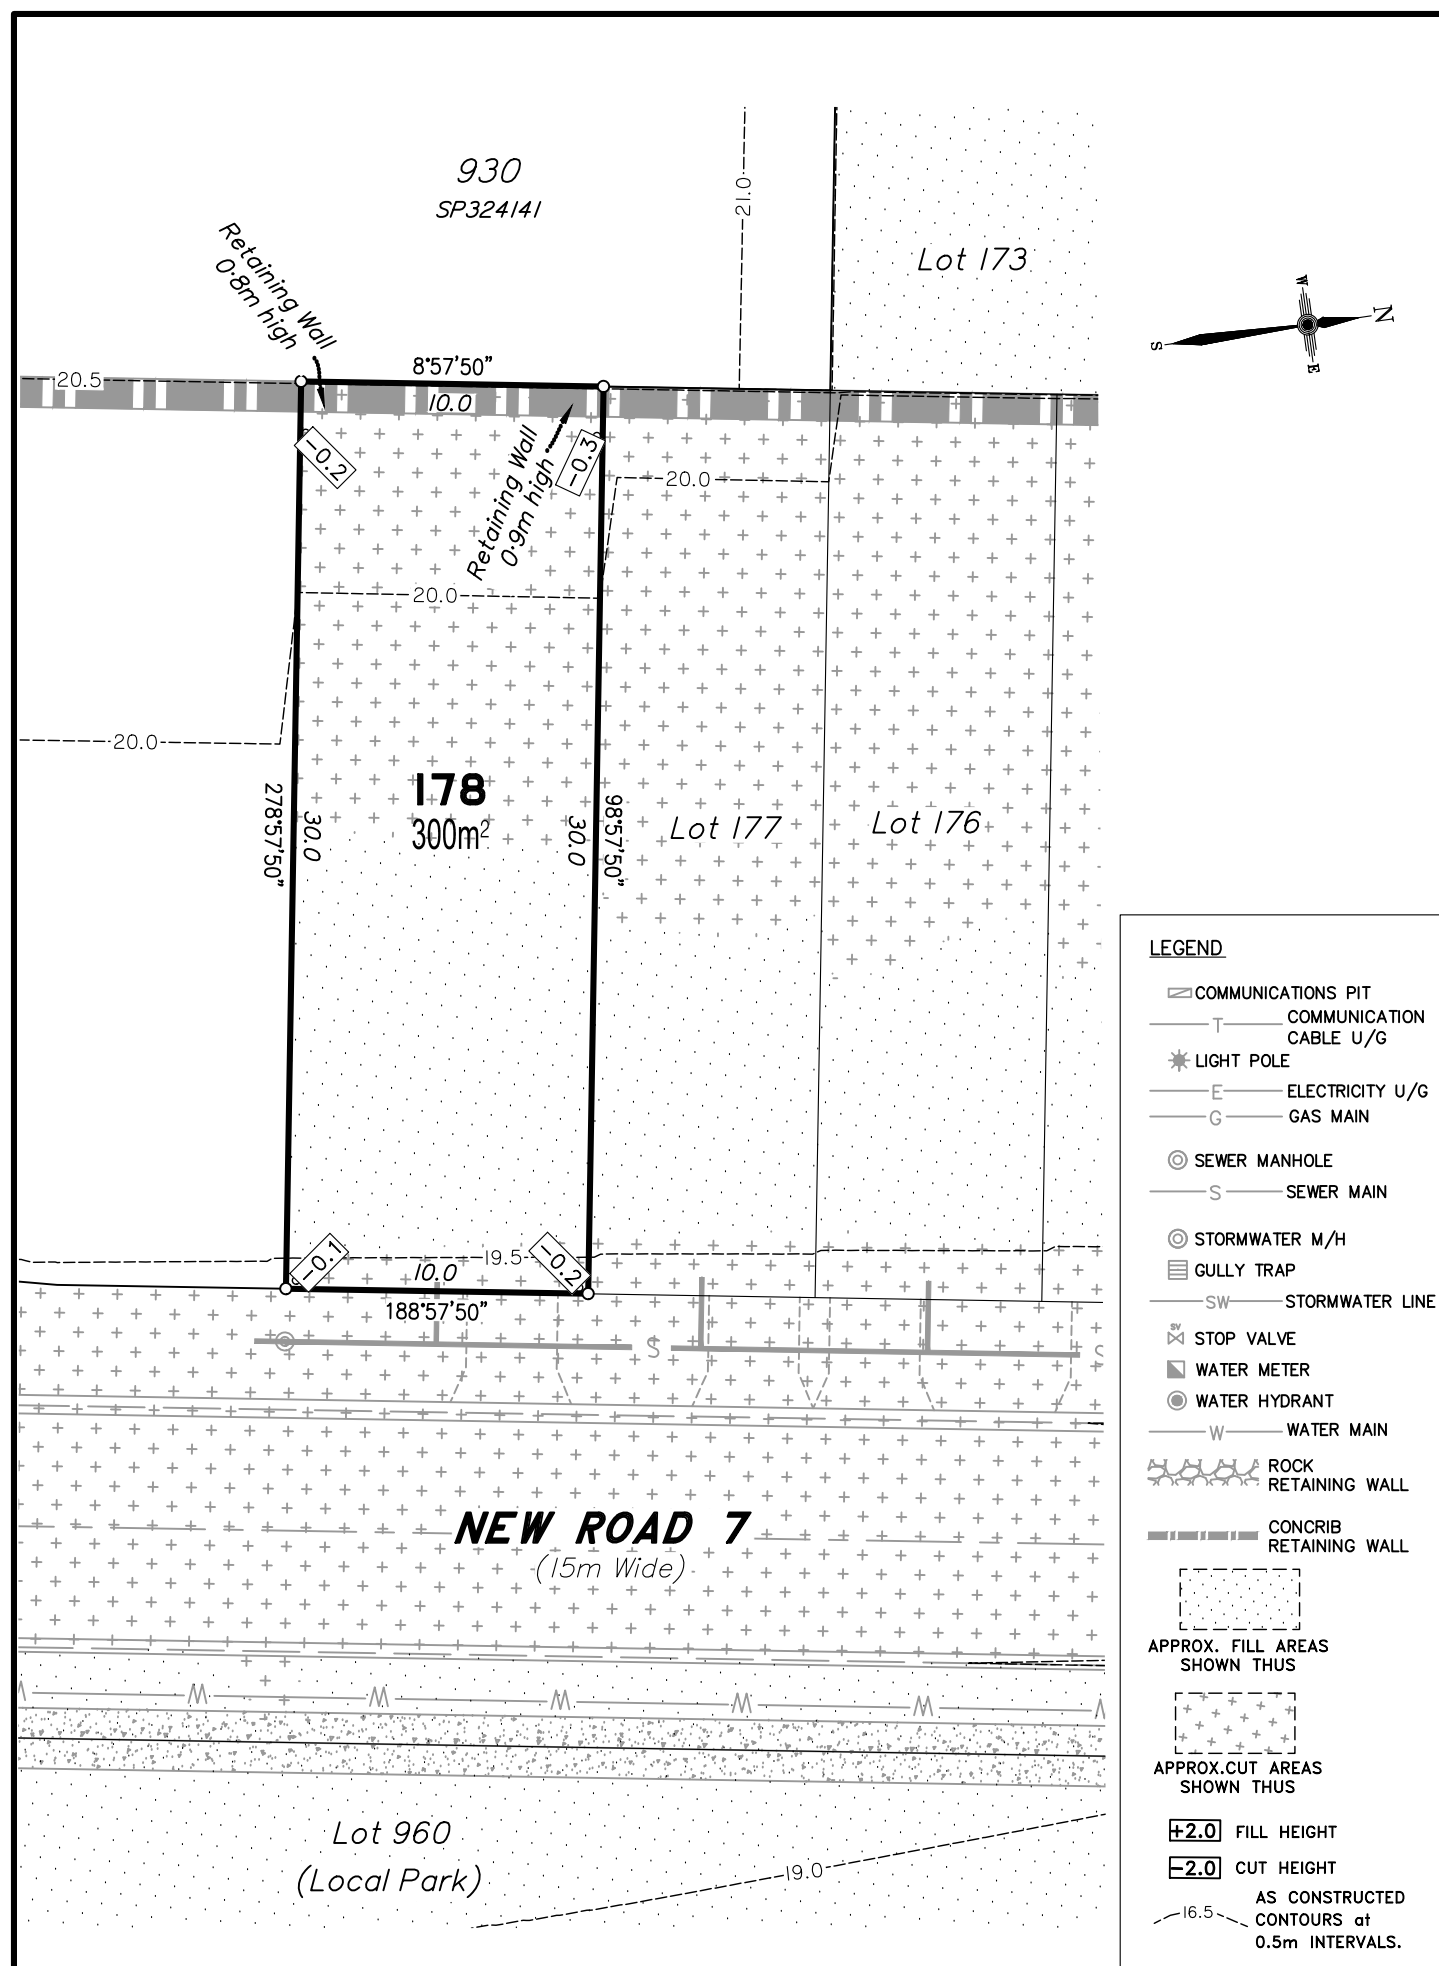

DISCLOSURE PLAN
FOR PROPOSED ALLOTMENT 178
Dated 20th July 2021

This plan shows details of Proposed Allotment 178 on the Proposal Plan 12244-PRO-17 Rev G dated 14/12/2020, which complies with the Development Approval DA/34253/2017/V3RL dated 17th February 2021, approved by Moreton Bay Regional Council, subject to conditions, and associated Judgment by the Planning and Environment Court (1987 of 2018).

The description of the proposed allotment 178, is as part of Lot 1000 on SP324141 (Formally lots 21-24 on RP176393), and situated at Clark Road, Morayfield, commencing at an initial point (A) being the north eastern most point of Lot 20 on RP176393 and thence bounding off on a bearing of 162°52'40" and a distance of 448.219m to point (B) at proposed allotment 178, and containing an area of 300 square metres, more or less.

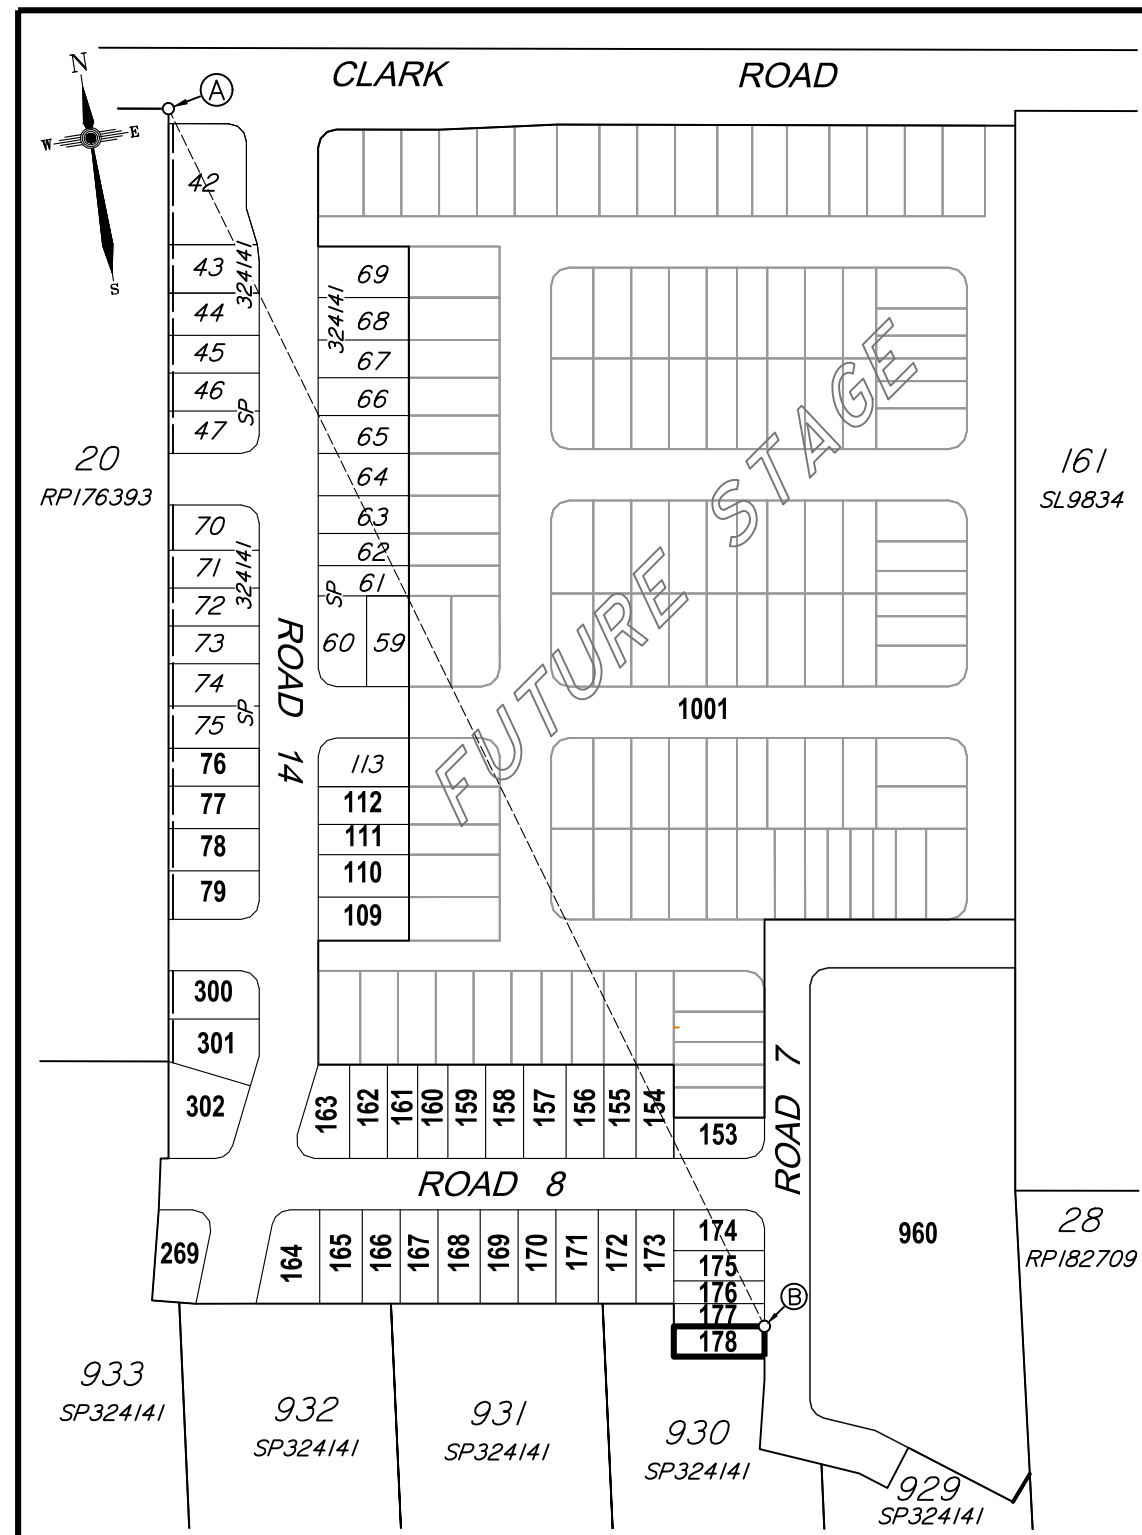

Disclosure Plan

**Summerstone Estate,
Morayfield**

PROPOSED STAGE 2
ALLOTMENTS 76-79, 109-112, 153-178
& 300-302

Cancelling Lot 1000 on SP324141
 (Formally Lots 21-24 on RP176393)

PROPOSED LOT 178

DETAIL SURVEY COMPLETED BY LSD
 26/06/2021.
 ENGINEERING DESIGN BY GREEN-
 HAVEN PROJECTS.
 ANY FILLING ON THIS LOT IS TO BE
 COMPLETED TO LEVEL ONE
 SUPERVISION AND TESTING IN
 ACCORDANCE WITH THE
 REQUIREMENTS OF AS 3798-2007
 "GUIDELINES ON EARTHWORKS FOR
 COMMERCIAL AND RESIDENTIAL
 DEVELOPMENTS".

Revisions	Surveyed	Drawn	Checked	Passed	Date

A ORIGINAL PLAN LSD LA MH LS 20/07/21



PO Box 6334, Maroochydore BC QLD 4558
 10/1 Newspaper Place, Maroochydore QLD 4558
 Mobile: 0412 666 516
 Email: mail@landsurveyingdynamics.com
 Web: www.landsurveyingdynamics.com
 Land Surveying Dynamics (LSD) Pty Ltd
 ACN 154 593 870

Signed
 Cadastral Surveyor/Director
 Date 20/7/2021

Horiz. Datum MGA20 Z56
 Origin GNSS CORS

Vert. Datum AHD
 Origin PSM 42642
 RL 25.417 AHD

Locality: Morayfield


Local Government: Moreton Bay R.C.

Scale
 SHEET 1 OF 1 **As shown at A3**


COMPUTER FILE 12244-DIS

DRAWING NUMBER REV.

12116-DIS-178 **A**

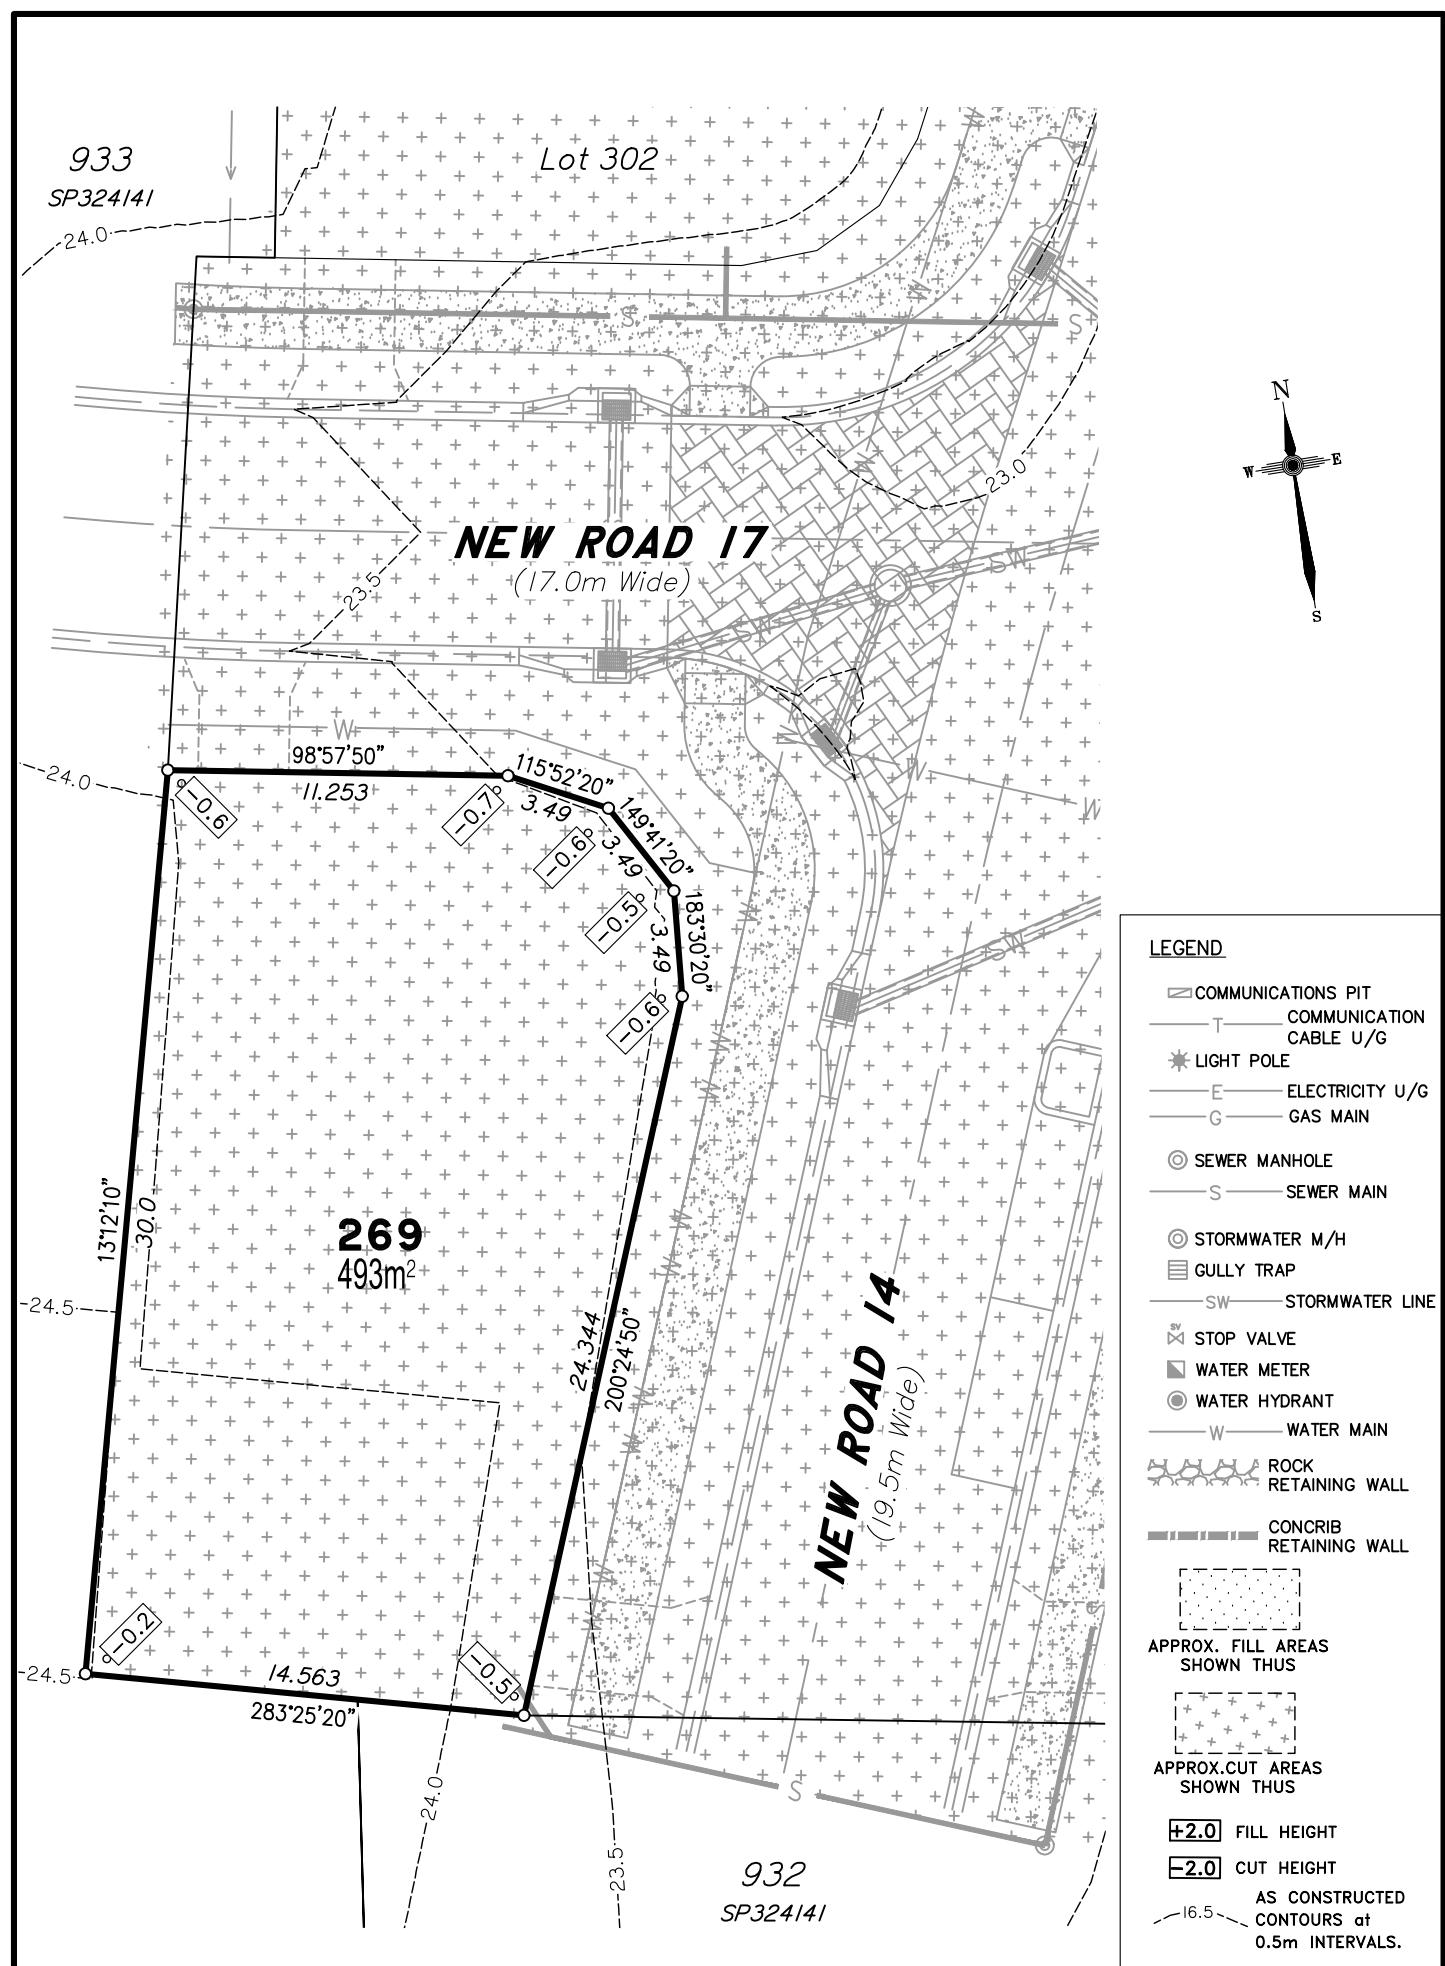


Scale 1:250 - Lengths are in Metres.

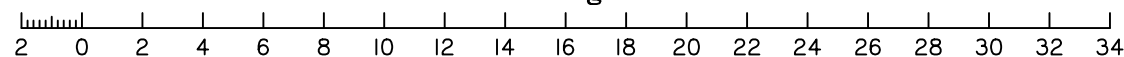

DISCLOSURE PLAN
FOR PROPOSED ALLOTMENT 269
Dated 20th July 2021

This plan shows details of Proposed Allotment 269 on the Proposal Plan 12244-PRO-17 Rev G dated 14/12/2020, which complies with the Development Approval DA/34253/2017/V3RL dated 17th February 2021, approved by Moreton Bay Regional Council, subject to conditions, and associated Judgment by the Planning and Environment Court (1987 of 2018).


The description of the proposed allotment 269, is as part of Lot 1000 on SP324141 (Formally lots 21-24 on RP176393), and situated at Clark Road, Morayfield, commencing at an initial point (A) being the north eastern most point of Lot 20 on RP176393 and thence bounding off on a bearing of 189°28'30" and a distance of 364.079m to point (B) at proposed allotment 269, and containing an area of 493 square metres, more or less.

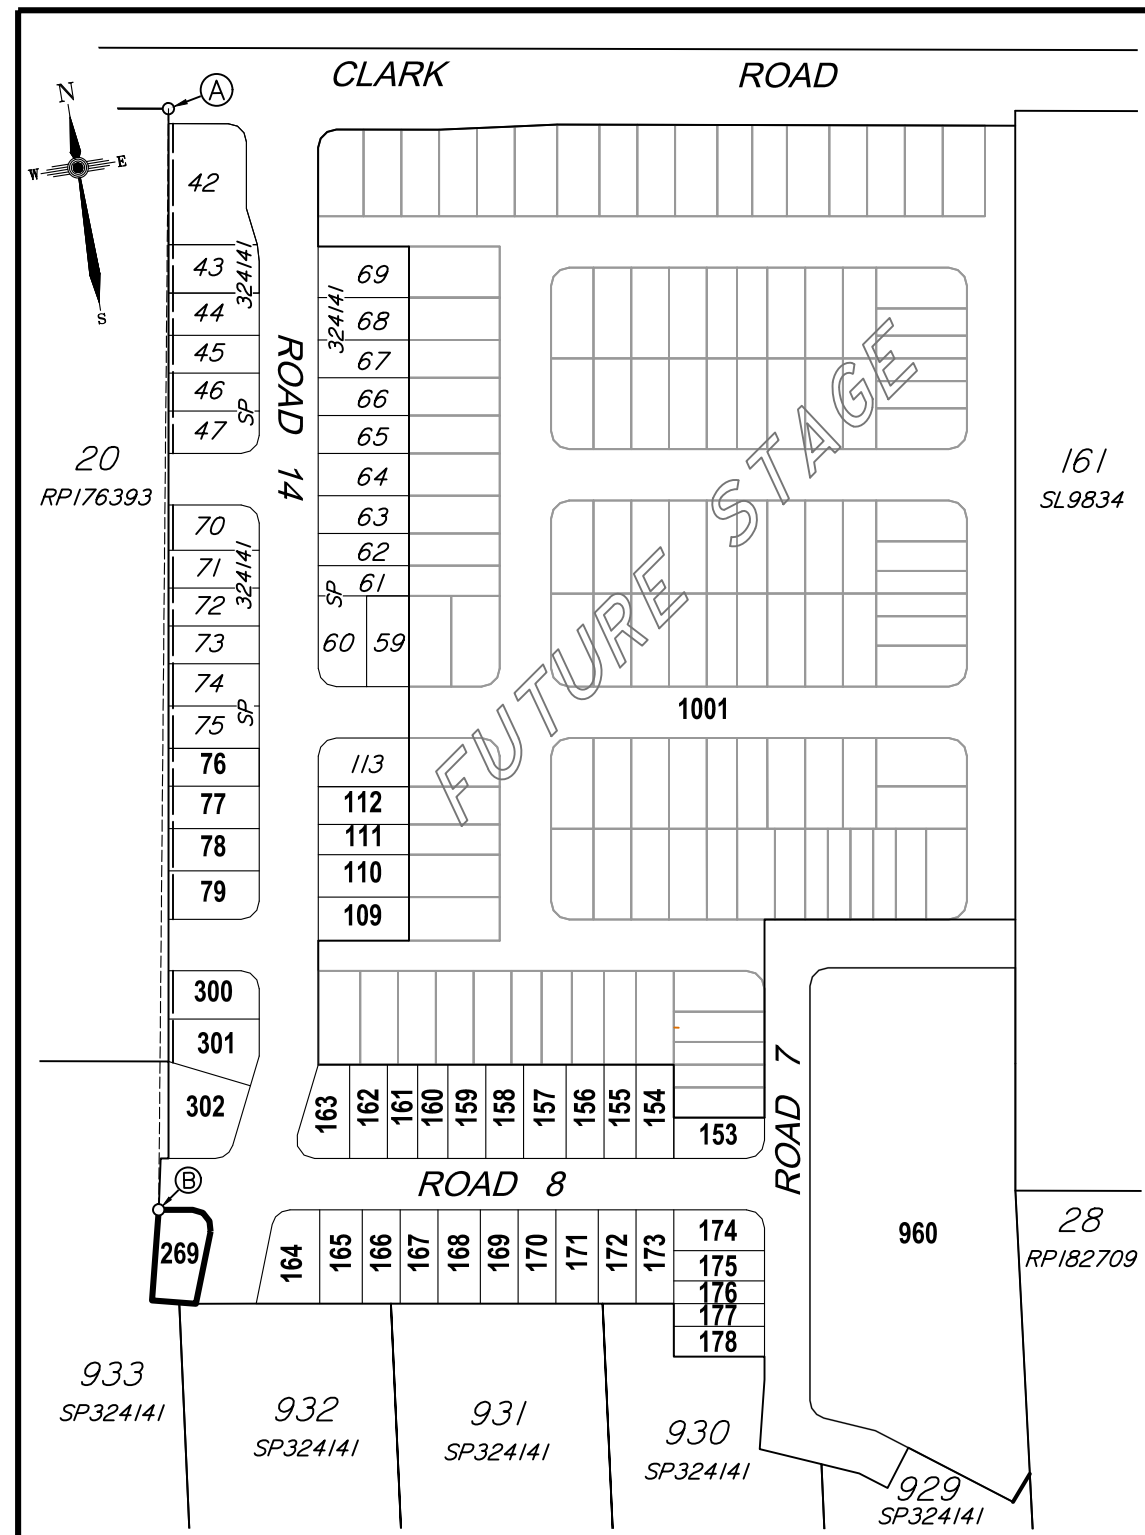

CADASTRAL CONNECTION

A - B 189°28'30" 364.079

Scale 1:2500 - Lengths are in Metres.

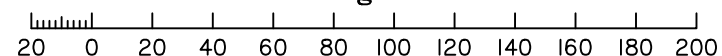

Disclosure Plan

**Summerstone Estate,
Morayfield**

PROPOSED STAGE 2
ALLOTMENTS 76-79, 109-112, 153-178
& 300-302
 Cancelling Lot 1000 on SP324141
 (Formally Lots 21-24 on RP176393)
PROPOSED LOT 269

DETAIL SURVEY COMPLETED BY LSD
 26/06/2021.
 ENGINEERING DESIGN BY GREEN-
 HAVEN PROJECTS.
 ANY FILLING ON THIS LOT IS TO BE
 COMPLETED TO LEVEL ONE
 SUPERVISION AND TESTING IN
 ACCORDANCE WITH THE
 REQUIREMENTS OF AS 3798-2007
 "GUIDELINES ON EARTHWORKS FOR
 COMMERCIAL AND RESIDENTIAL
 DEVELOPMENTS".

Revisions	Surveyed	Drawn	Checked	Passed	Date
A ORIGINAL PLAN	LSD	LA	MH	LS	20/07/21



PO Box 6334, Maroochydore BC QLD 4558
 10/1 Newspaper Place, Maroochydore QLD 4558
 Mobile: 0412 666 516
 Email: mail@landsurveyingdynamics.com
 Web: www.landsurveyingdynamics.com
 Land Surveying Dynamics (LSD) Pty Ltd
 ACN 154 593 670


Signed
 Cadastral Surveyor/Director
 Date 20/7/2021

Horiz. Datum MGA20 Z56
 Origin GNSS CORS

Vert. Datum AHD
 Origin PSM 42642
 RL 25.417 AHD

Locality: Morayfield
 Local Government: Moreton Bay R.C.

SHEET 1 OF 1
 COMPUTER FILE 12244-DIS
 DRAWING NUMBER
12116-DIS-269
 Scale As shown at A3
 REV. **A**

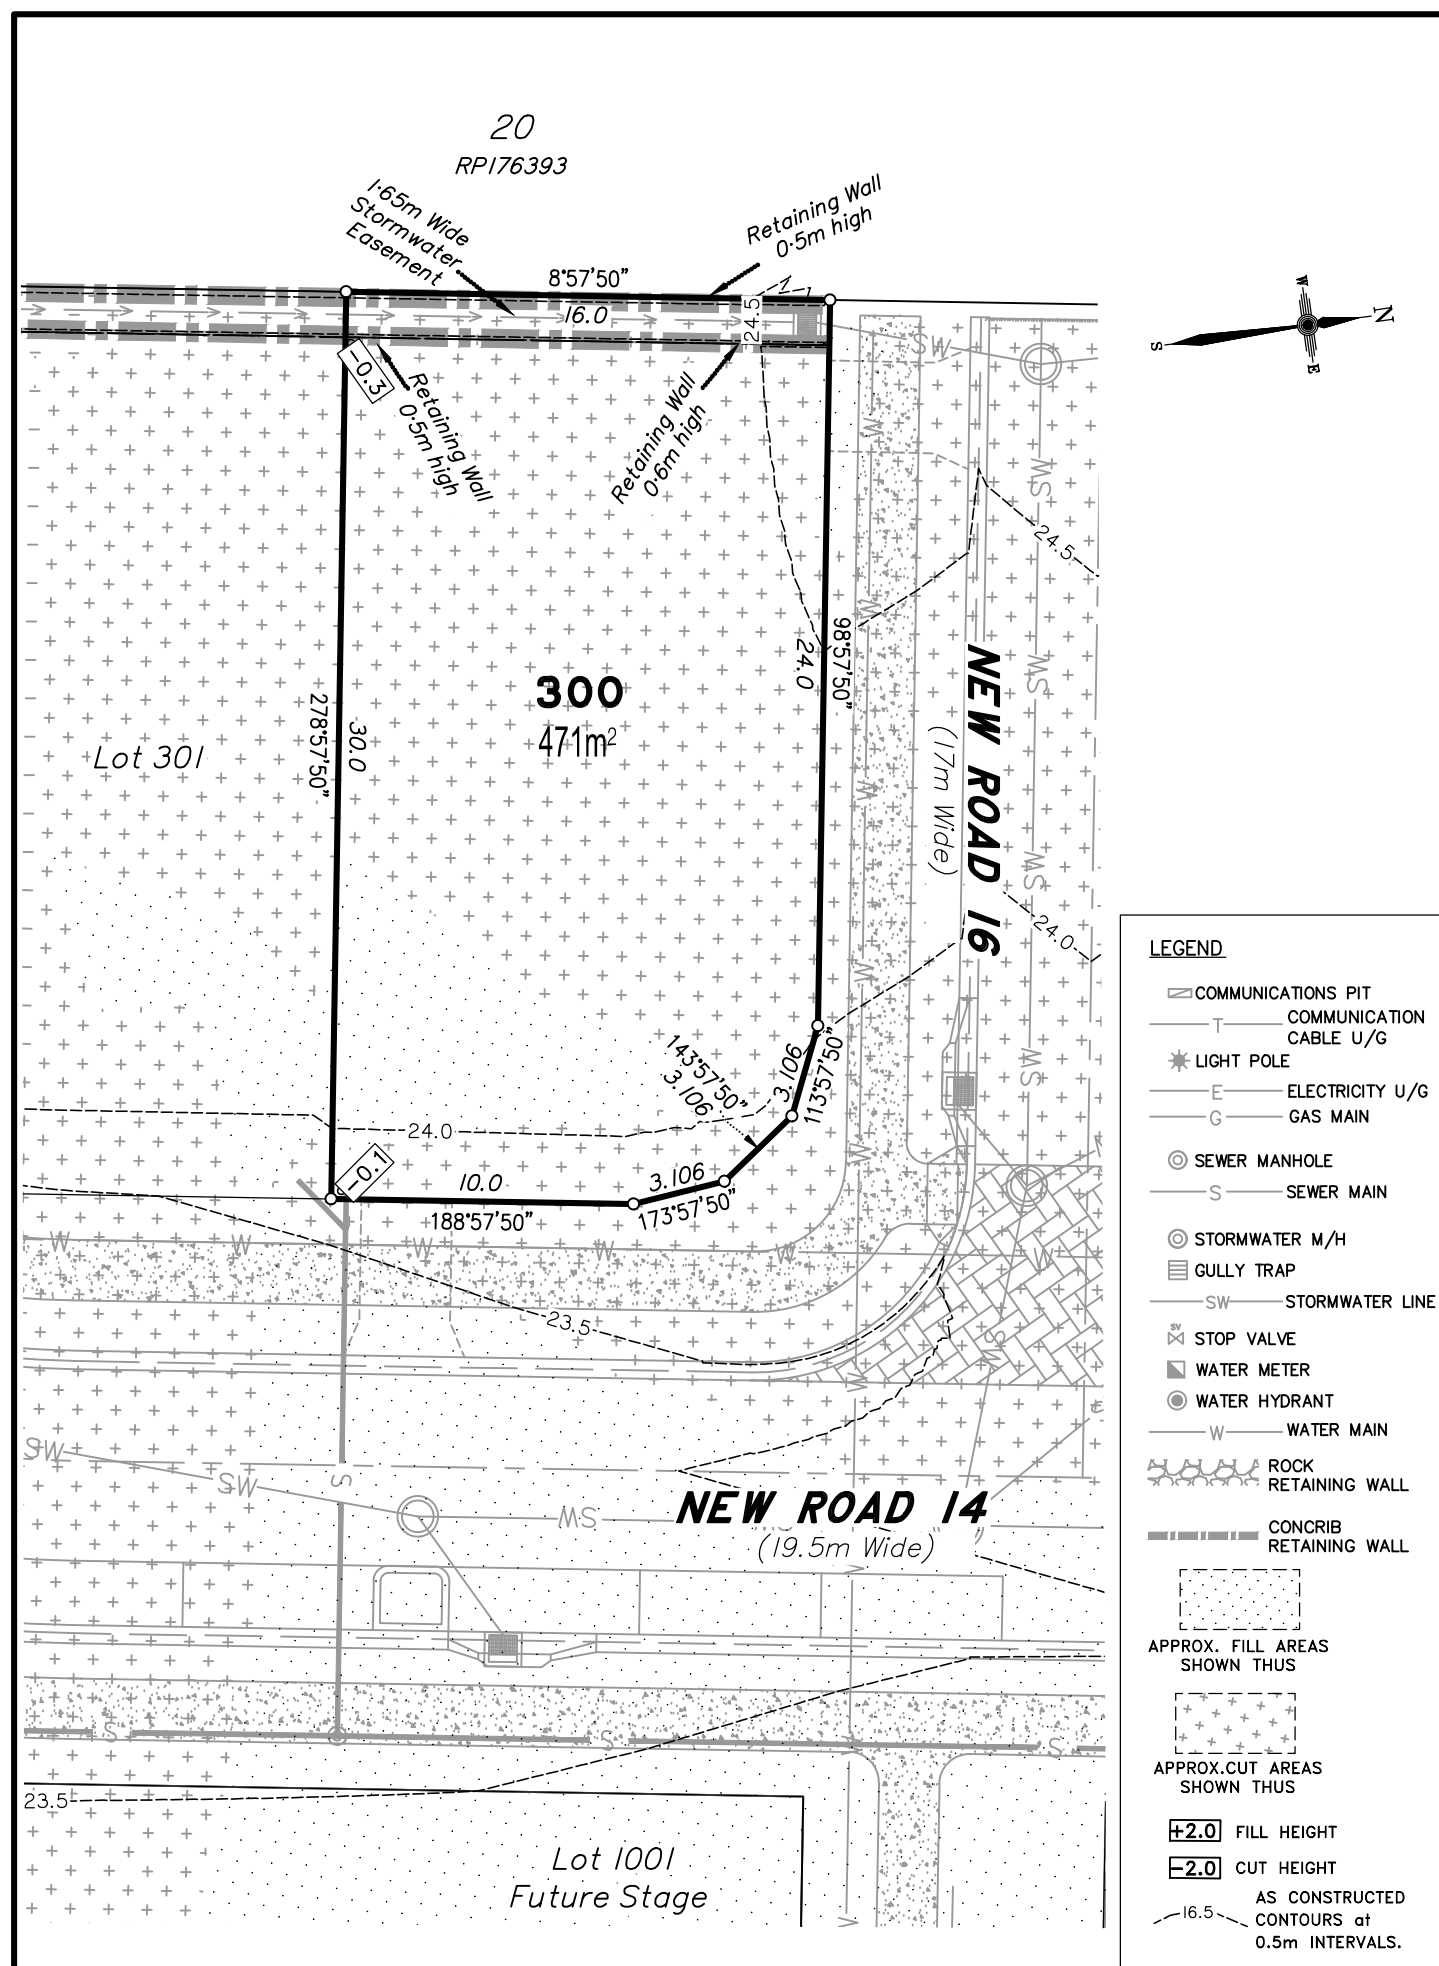


DISCLOSURE PLAN FOR PROPOSED ALLOTMENT 300

Dated 20th July 2021

This plan shows details of Proposed Allotment 300 on the Proposal Plan 12244-PRO-17 Rev G dated 14/12/2020, which complies with the Development Approval DA/34253/2017/V3RL dated 17th February 2021, approved by Moreton Bay Regional Council, subject to conditions, and associated Judgment by the Planning and Environment Court (1987 of 2018).

The description of the proposed allotment 300, is as part of Lot 1000 on SP324141 (Formally lots 21-24 on RP176393), and situated at Clark Road, Morayfield, commencing at an initial point (A) being the north eastern most point of Lot 20 on RP176393 and thence bounding off on a bearing of 183°16'20" and a distance of 302.493m to point (B) at proposed allotment 300, and containing an area of 471 square metres, more or less.

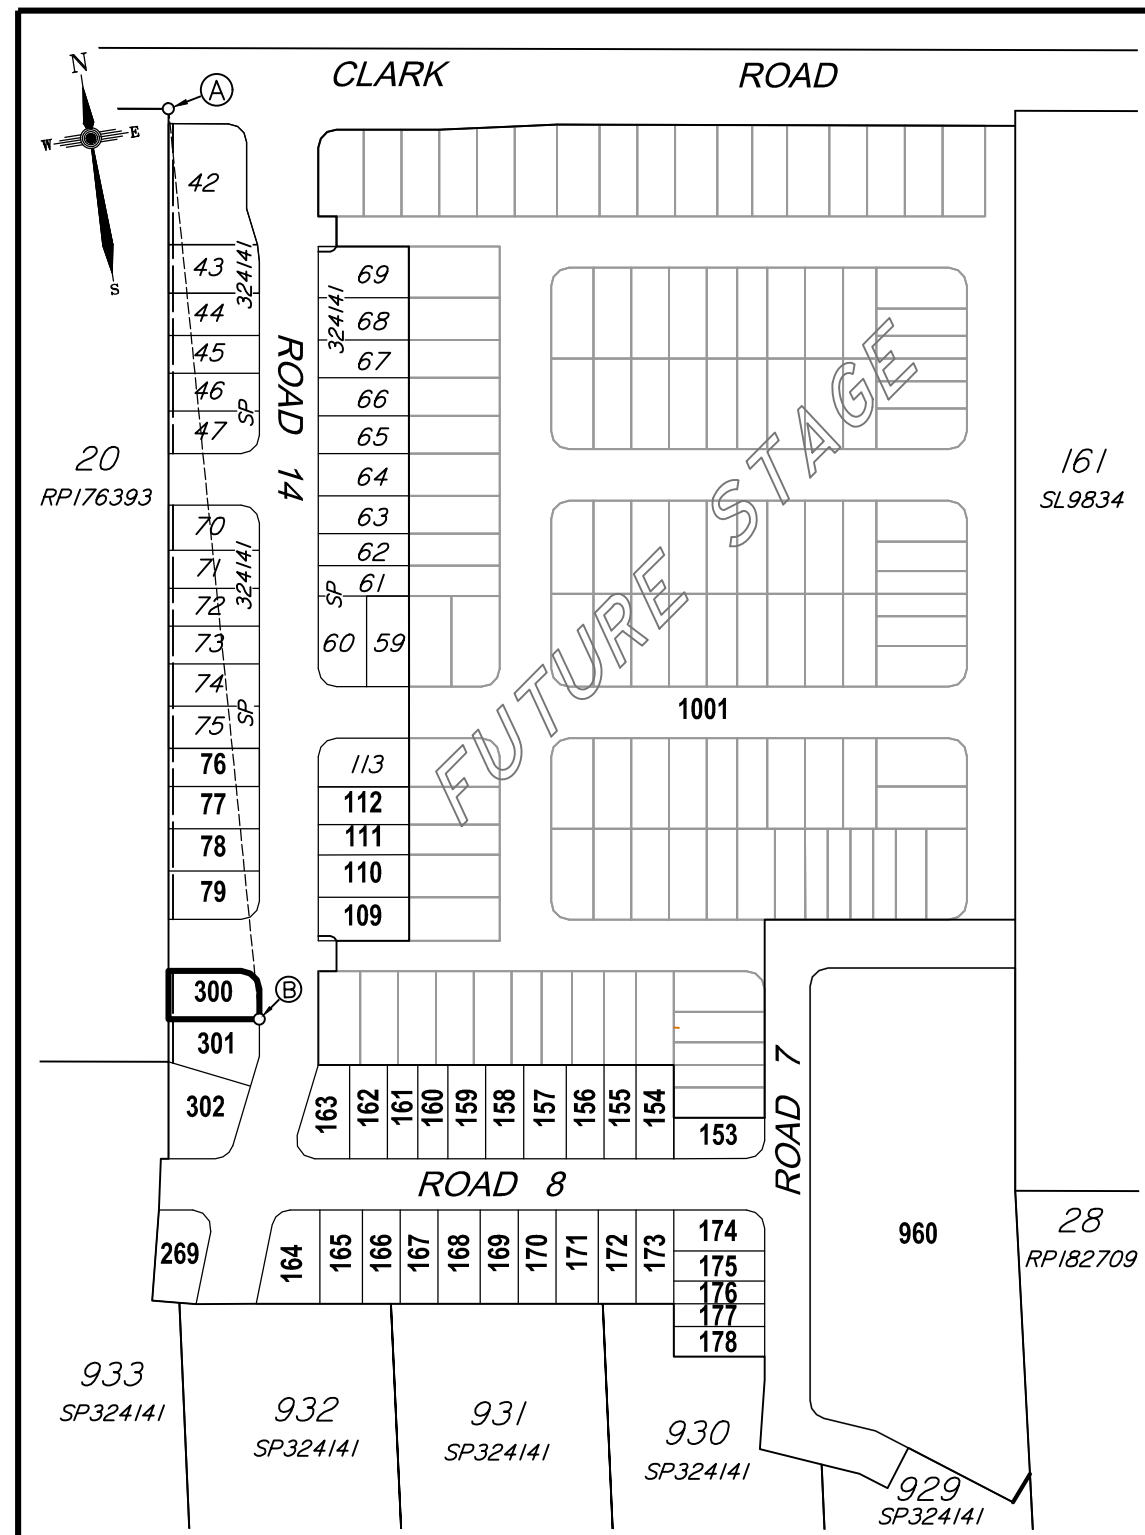

CADASTRAL CONNECTION

A - B 183°16'20" 302.493



Disclosure Plan

**Summerstone Estate,
Morayfield**

PROPOSED STAGE 2
ALLOTMENTS 76-79, 109-112, 153-178
& 300-302
Cancelling Lot 1000 on SP324141
(Formally Lots 21-24 on RP176393)
PROPOSED LOT 300

DETAIL SURVEY COMPLETED BY LSD
26/06/2021.
ENGINEERING DESIGN BY GREEN-
HAVEN PROJECTS.
ANY FILLING ON THIS LOT IS TO BE
COMPLETED TO LEVEL ONE
SUPERVISION AND TESTING IN
ACCORDANCE WITH THE
REQUIREMENTS OF AS 3798-2007
"GUIDELINES ON EARTHWORKS FOR
COMMERCIAL AND RESIDENTIAL
DEVELOPMENTS".

Revisions	Surveyed	Drawn	Checked	Passed	Date
B EMT UPDATES	LSD	MH	MH	LS	1/10/21
A ORIGINAL PLAN	LSD	LA	MH	LS	20/07/21



PO Box 6334, Maroochydore BC QLD 4558
10/1 Newspaper Place, Maroochydore QLD 4558
Mobile: 0412 666 516
Email: mail@landsurveyingdynamics.com
Web: www.landsurveyingdynamics.com
Land Surveying Dynamics (LSD) Pty Ltd
ACN 154 593 870


Signed
Cadastral Surveyor/Director
Date 1/10/2021

Horiz. Datum MGA20 Z56
Origin GNSS CORS

Vert. Datum AHD
Origin PSM 42642
RL 25.417 AHD

Locality: Morayfield
Local Government: Moreton Bay R.C.


Scale
SHEET 1 OF 1 **As shown at A3**
COMPUTER FILE 12244-DIS
DRAWING NUMBER **12116-DIS-300** REV. **B**

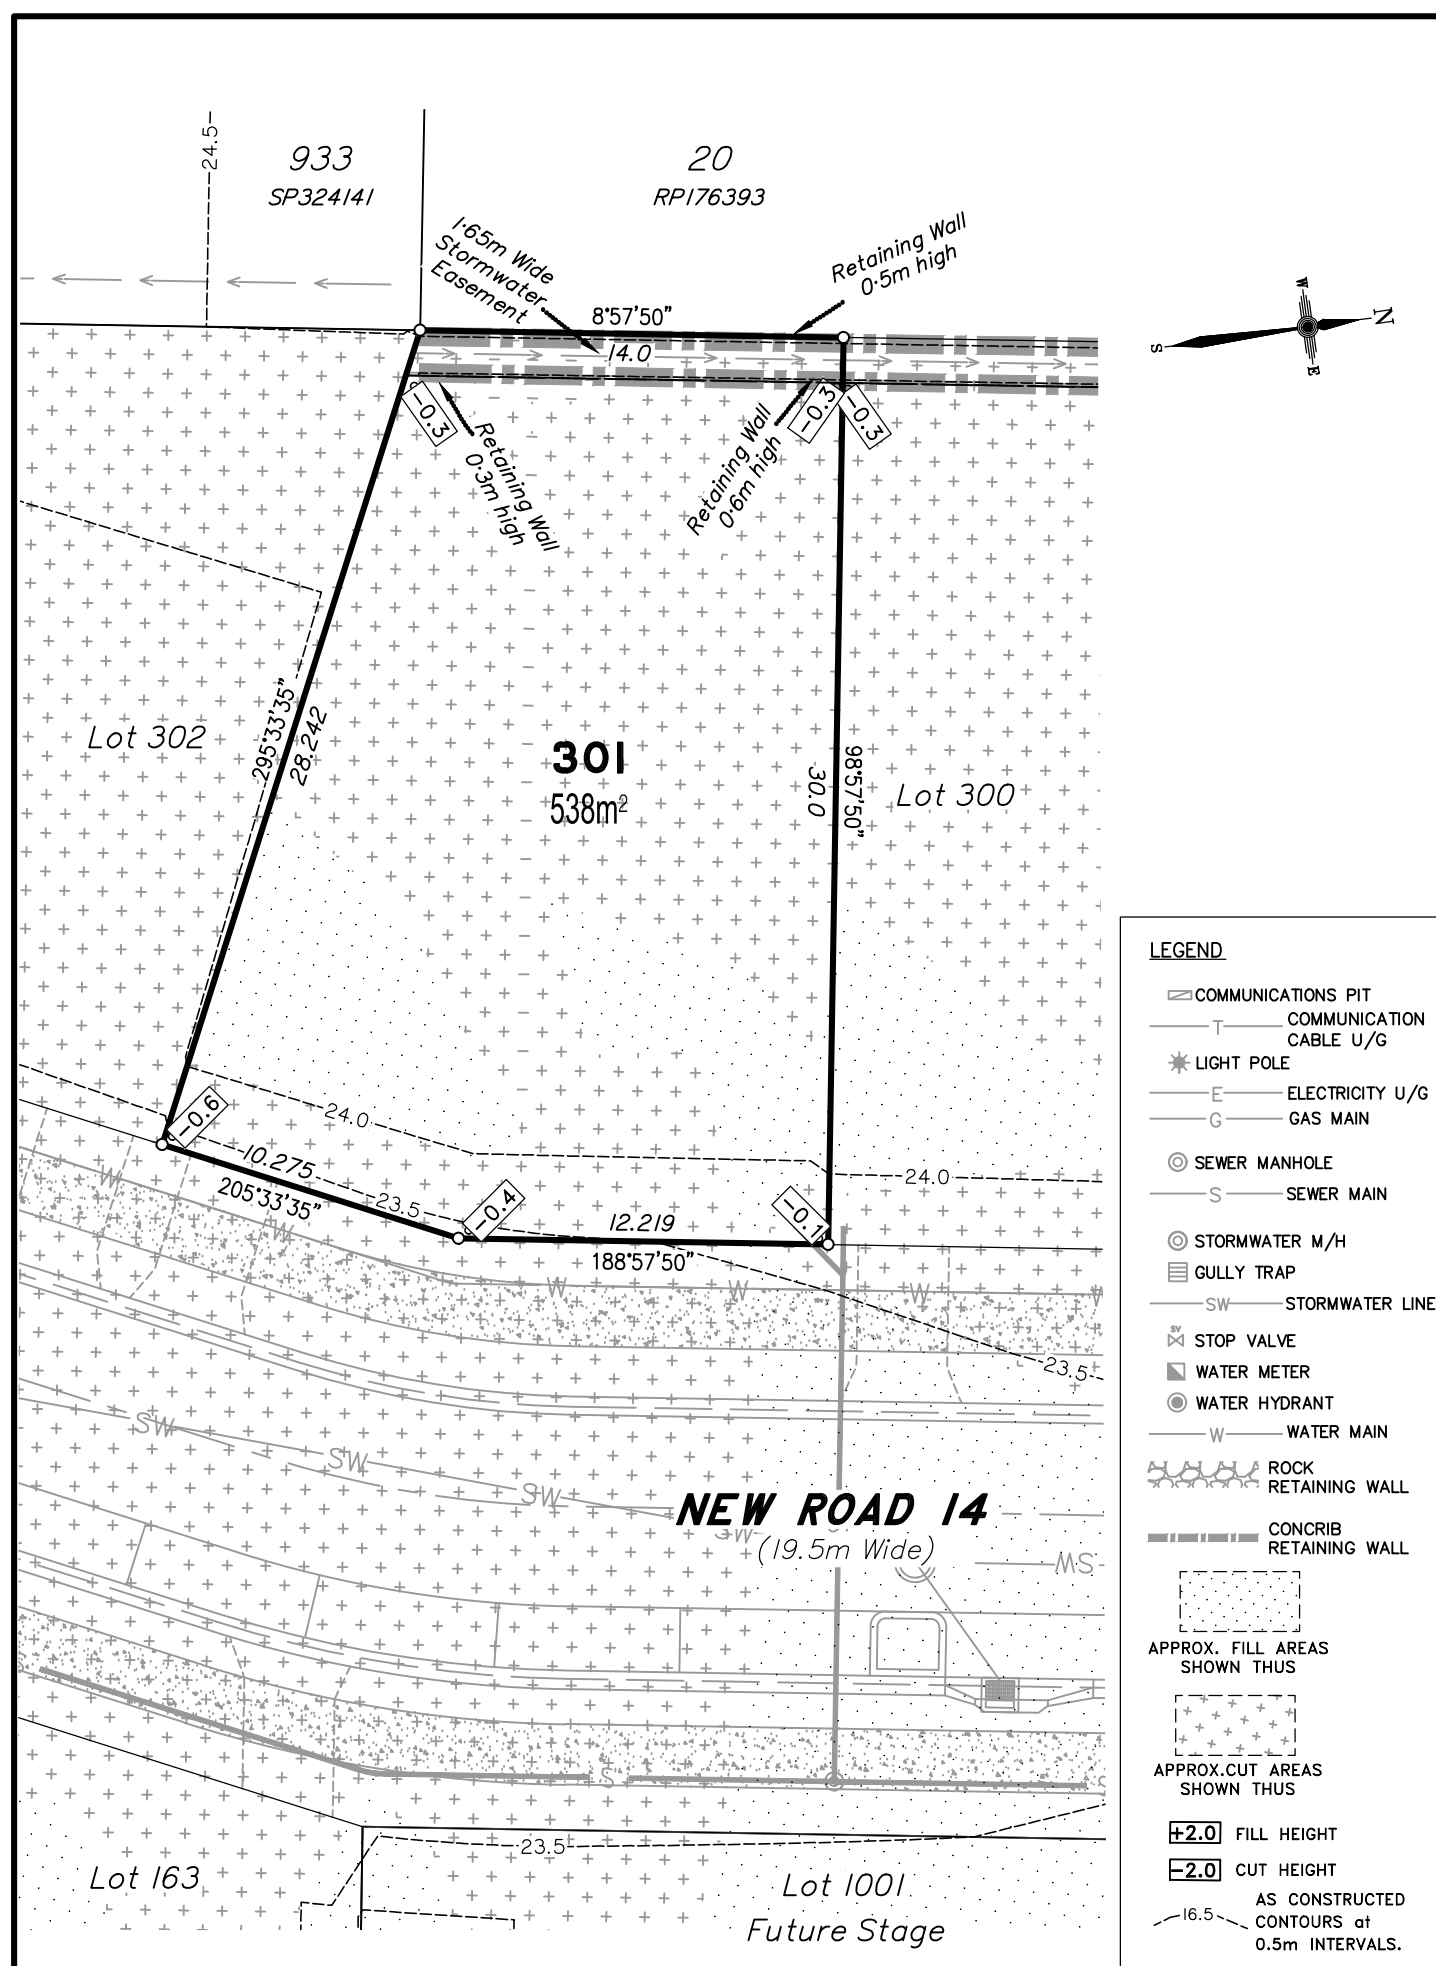

DISCLOSURE PLAN
FOR PROPOSED ALLOTMENT 301
Dated 20th July 2021

This plan shows details of Proposed Allotment 301 on the Proposal Plan 12244-PRO-17 Rev G dated 14/12/2020, which complies with the Development Approval DA/34253/2017/V3RL dated 17th February 2021, approved by Moreton Bay Regional Council, subject to conditions, and associated Judgment by the Planning and Environment Court (1987 of 2018).

The description of the proposed allotment 301, is as part of Lot 1000 on SP324141 (Formally lots 21-24 on RP176393), and situated at Clark Road, Morayfield, commencing at an initial point (A) being the north eastern most point of Lot 20 on RP176393 and thence bounding off on a bearing of 183°16'20" and a distance of 302.493m to point (B) at proposed allotment 301, and containing an area of 538 square metres, more or less.

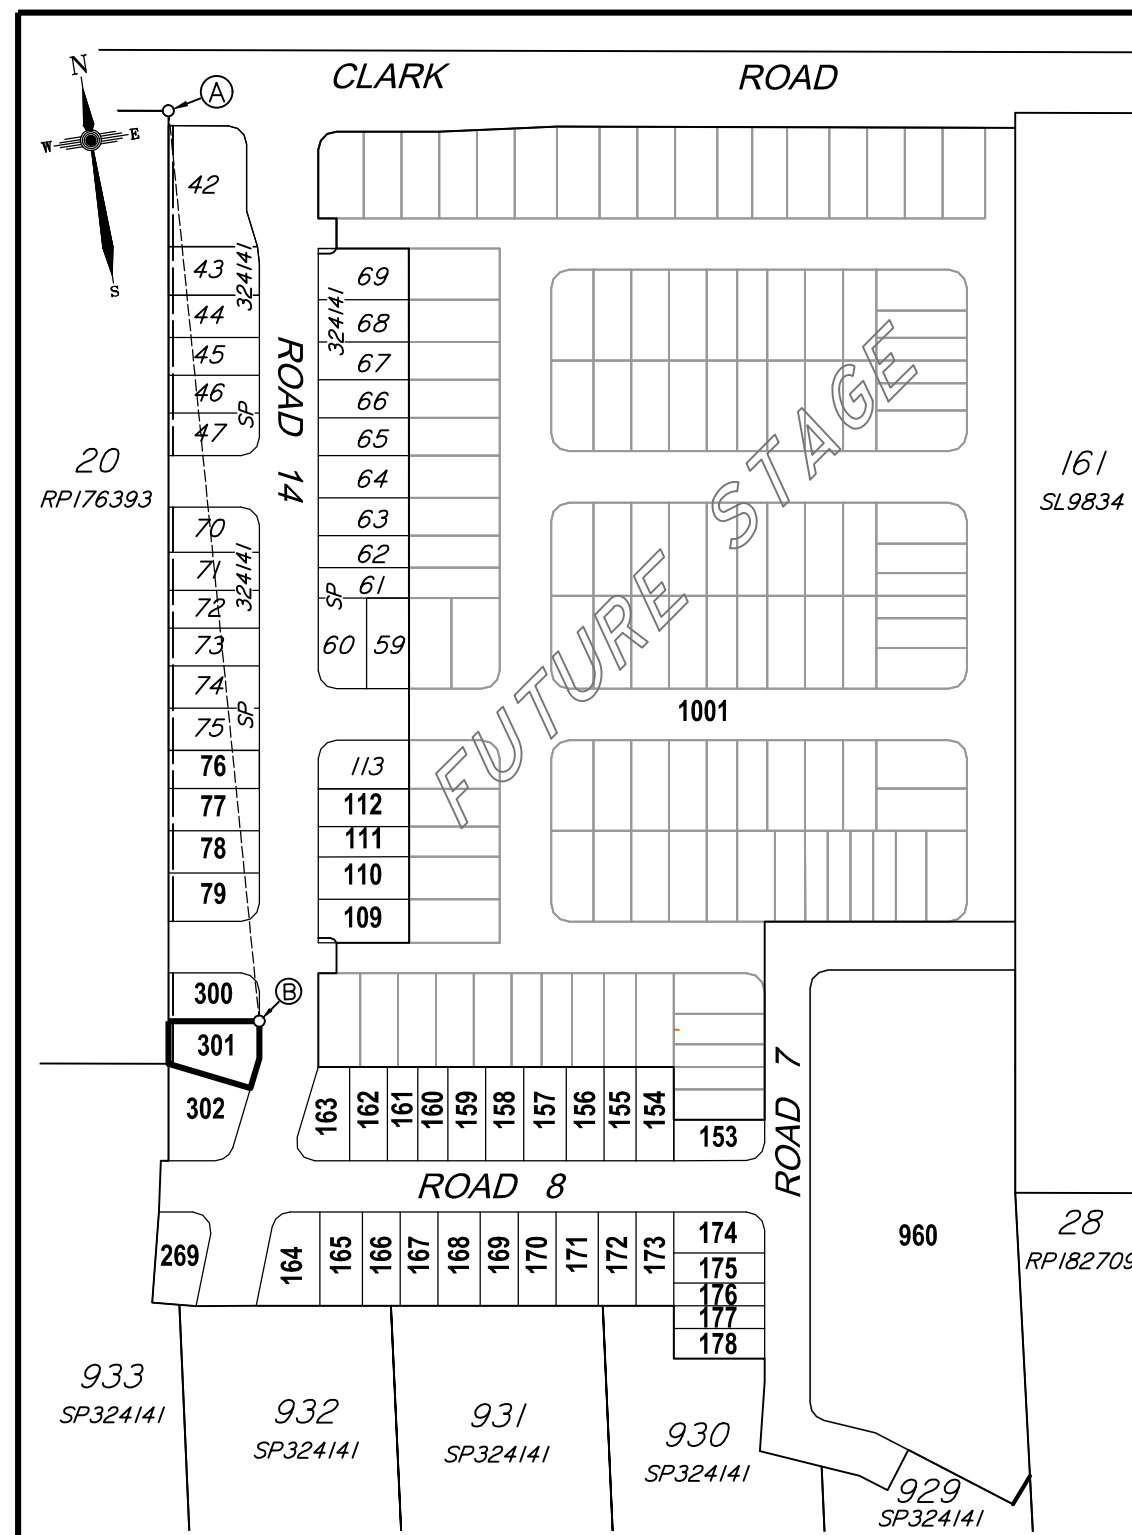

CADASTRAL CONNECTION

A - B 183°16'20" 302.493



Disclosure Plan

**Summerstone Estate,
Morayfield**

PROPOSED STAGE 2
ALLOTMENTS 76-79, 109-112, 153-178
& 300-302

Cancelling Lot 1000 on SP324141
 (Formally Lots 21-24 on RP176393)

PROPOSED LOT 301

DETAIL SURVEY COMPLETED BY LSD 26/06/2021.
 ENGINEERING DESIGN BY GREEN-HAVEN PROJECTS.
 ANY FILLING ON THIS LOT IS TO BE COMPLETED TO LEVEL ONE SUPERVISION AND TESTING IN ACCORDANCE WITH THE REQUIREMENTS OF AS 3798-2007 "GUIDELINES ON EARTHWORKS FOR COMMERCIAL AND RESIDENTIAL DEVELOPMENTS".

Revisions	Surveyed	Drawn	Checked	Passed	Date
B EMT UPDATES	LSD	MH	MH	LS	1/10/21
A ORIGINAL PLAN	LSD	LA	MH	LS	20/07/21



PO Box 6334, Maroochydore BC QLD 4558
 10/1 Newspaper Place, Maroochydore QLD 4558
 Mobile: 0412 666 516
 Email: mail@landsurveyingdynamics.com
 Web: www.landsurveyingdynamics.com
 Land Surveying Dynamics (LSD) Pty Ltd
 ACN 154 593 870


Signed
 Cadastral Surveyor/Director
 Date 1/10/2021

Horiz. Datum MGA20 Z56
 Origin GNSS CORS

Vert. Datum AHD
 Origin PSM 42642
 RL 25.417 AHD

Locality: Morayfield
 Local Government: Moreton Bay R.C.

Scale
SHEET 1 OF 1 As shown at A3
 COMPUTER FILE 12244-DIS
 DRAWING NUMBER **12116-DIS-301** REV. **B**

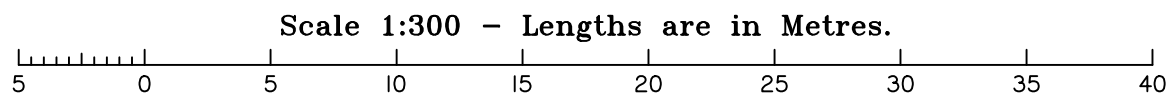

CLARK ROAD

ROAD 14

ROAD 8

ROAD 7

FUTURE STAGE

Lot Numbers:

- 42, 43, 44, 45, 46, 47, 70, 71, 72, 73, 74, 75, 76, 77, 78, 79, 300, 301, 302
- 69, 68, 67, 66, 65, 64, 63, 62, 61, 60, 59
- 113, 112, 111, 110, 109
- 163, 162, 161, 160, 159, 158, 157, 156, 155, 154, 153
- 164, 165, 166, 167, 168, 169, 170, 171, 172, 173, 174, 175, 176, 177, 178

Other Labels:

- 20, RP176393
- 161, SL9834
- 933, SP324141
- 932, SP324141
- 931, SP324141
- 930, SP324141
- 929, SP324141
- 960
- 28, RP18270

SHEET 1 OF 1		Scale As shown at A3
COMPUTER FILE		12244-DIS
DRAWING NUMBER 12116-DIS-302	REV. A	